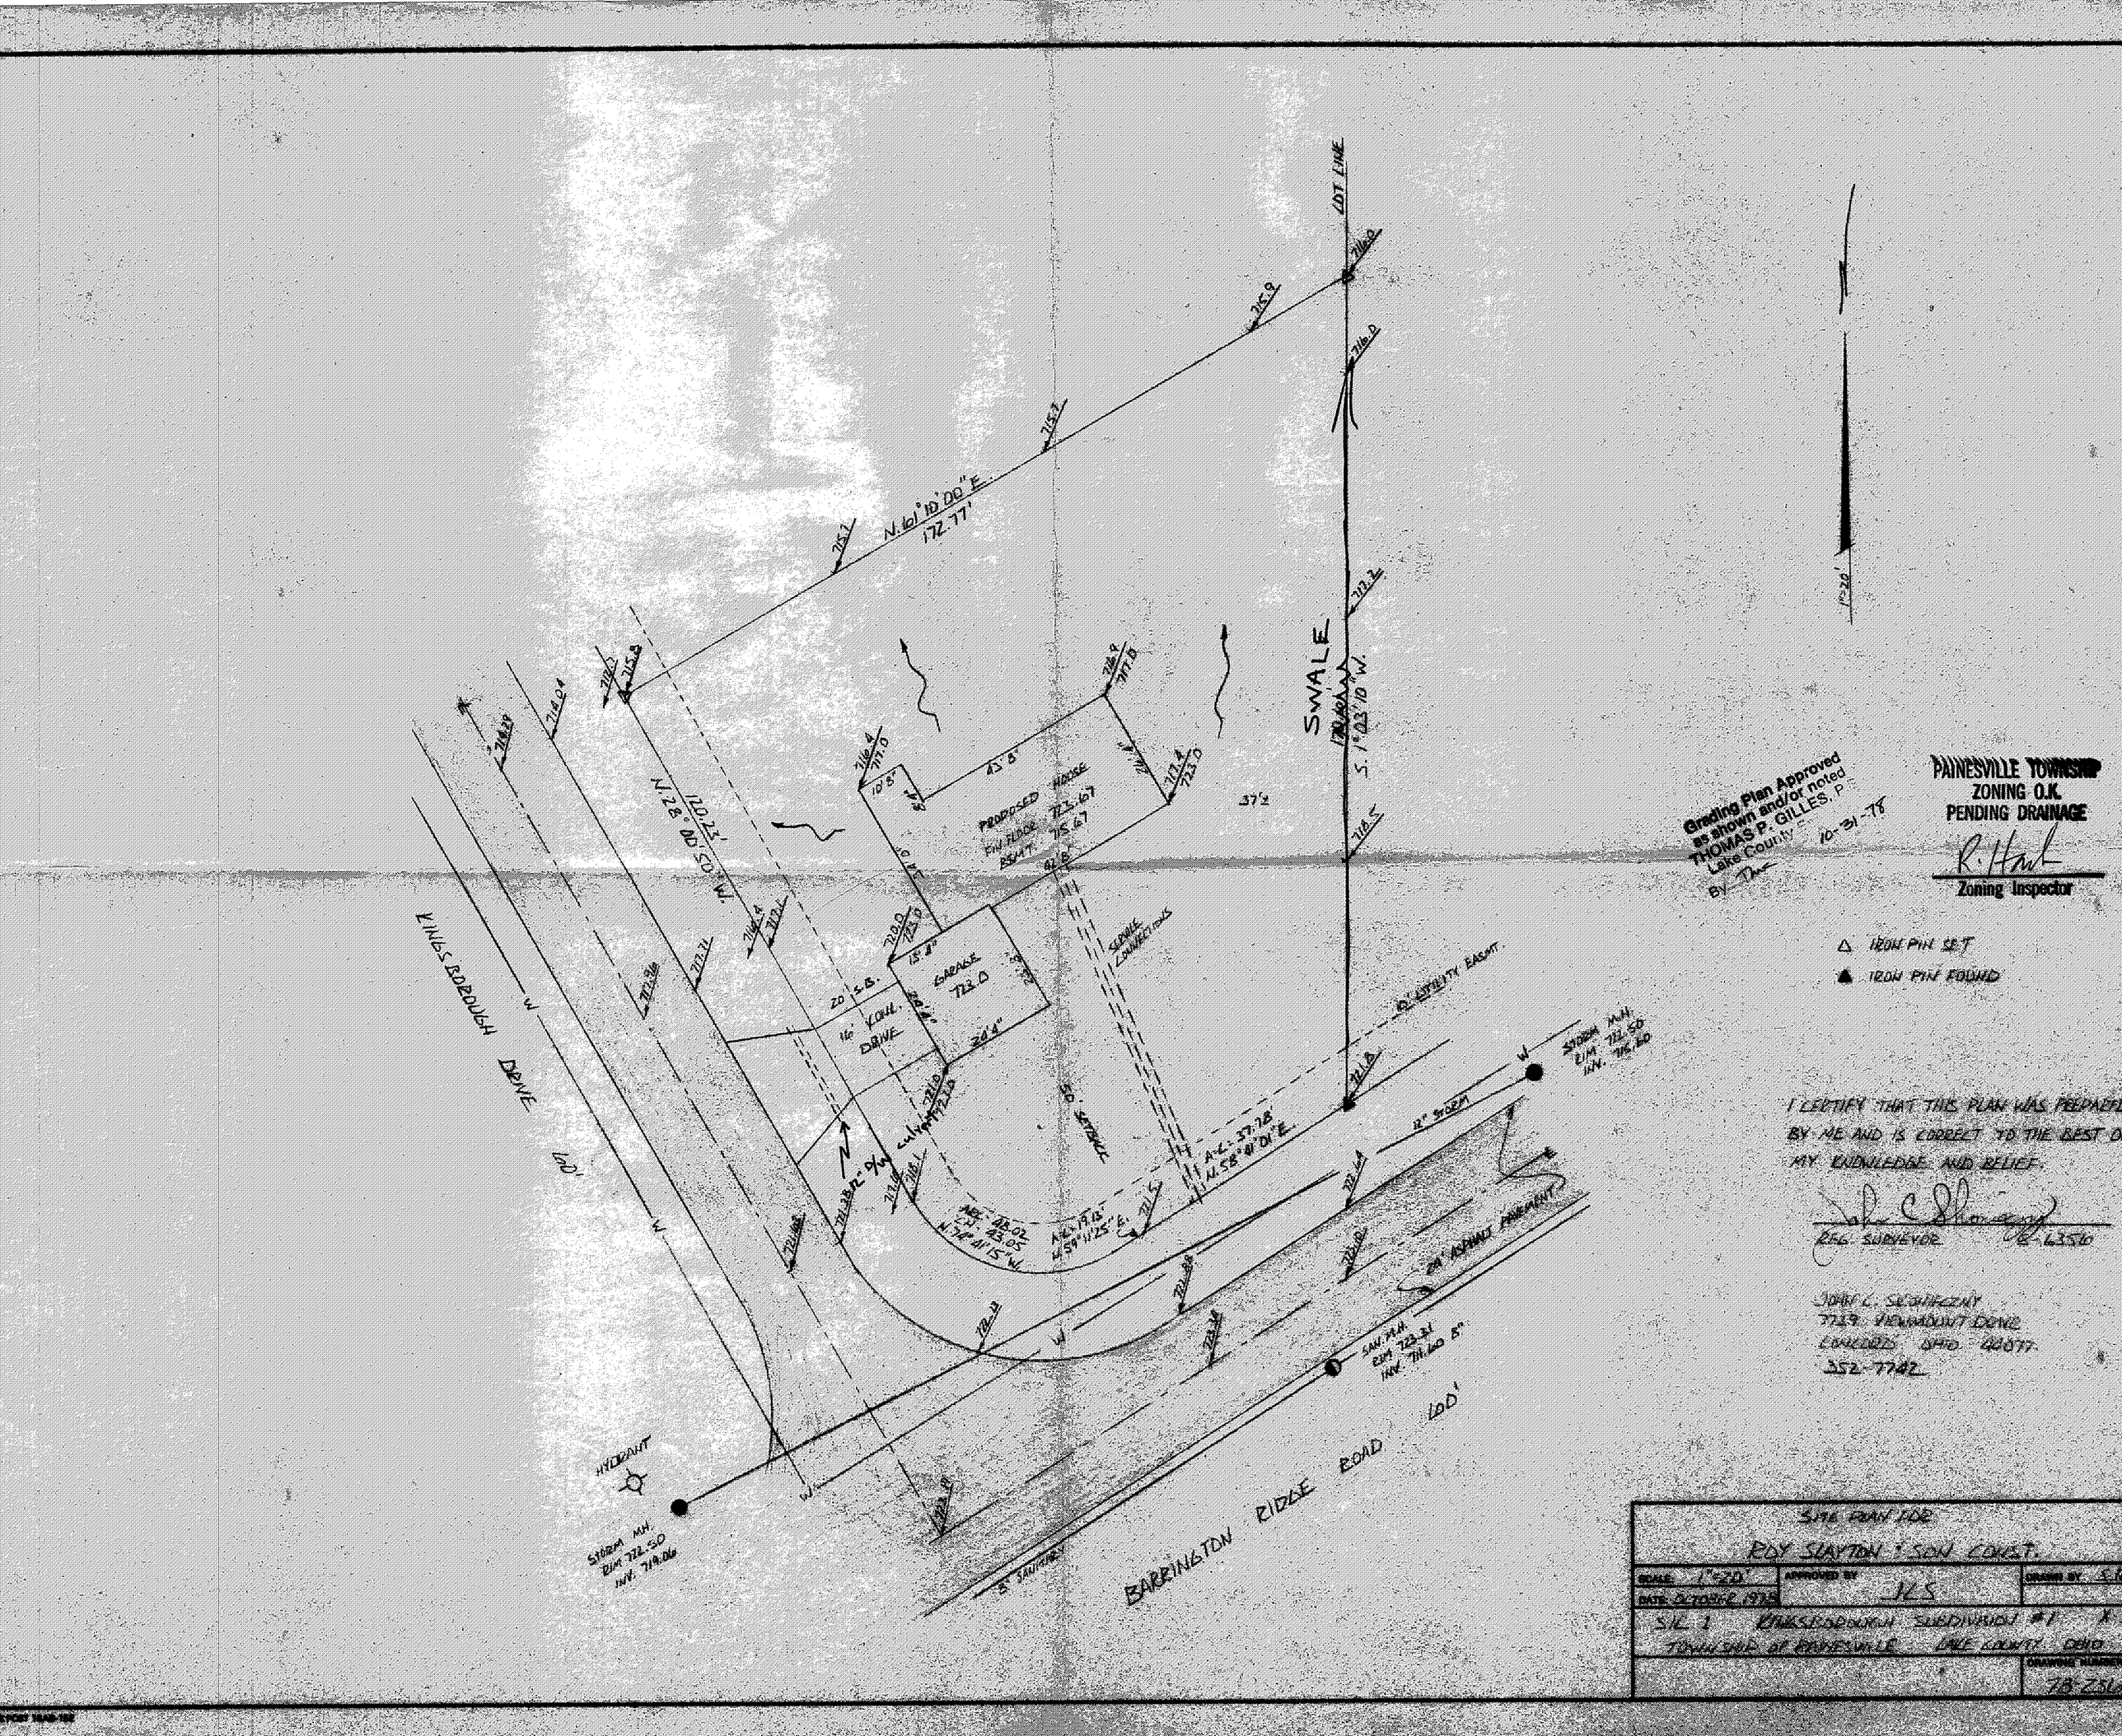

Grading Plan Approved as shown and/or noted
THOMAS P. GILLES, P
Lake County
By
10-31-78

PAINESVILLE TOWNSHIP
ZONING O.K.
PENDING DRAINAGE
R. Hunt
Zoning Inspector

△ IRON PIN SET
▲ IRON PIN FOUND

I CERTIFY THAT THIS PLAN WAS PREPARED BY ME AND IS CORRECT TO THE BEST OF MY KNOWLEDGE AND BELIEF.

JOHN L. SLOSARCZYK
REG. SURVEYOR No. 4356

JOHN L. SLOSARCZYK
7739 VERMOUNT DRIVE
CONCORD OHIO 44077
352-7742

SITE PLAN FOR
ROY SLAYTON & SON CONST.

SCALE: 1"=20'	APPROVED BY: JLS	DRAWN BY: SK
DATE: OCTOBER 1978		
S/L 1 KINGSBOROUGH SUBDIVISION #1		X
TOWNSHIP OF PAINESVILLE LAKE COUNTY OHIO		
		DRAWING NUMBER 78-256