SITE PLAN

PAINESVILLE TOWNSHIP — LAKE COUNTY, OHIO

for: BILL MICHELS
CLIENT — OWNER

3488 EUCLID AVE — HTS — 44094
ADDRESS — STREET — CITY — ZIP

CLIFTON FARMS SUB
SUBDIVISION — NAME

VOL. — PG. 32

LOT — TRACT

VOLUME — PAGE

11150 ENGLEWOOD
SUBLOT NO. — STREET

PERM. PARCEL NO. — STREET

LEGEND

SANITARY MANHOLE		WATER VALVE (GAS)	
STORM MANHOLE		WATER METER (GAS)	
INLET OR CATCH BASIN		AS BUILT ELEVATION	100.0
HYDRANT			
EXISTING CONTOURS		INDICATES DIRECTION OF SURFACE DRAINAGE	
PROPOSED CONTOURS			
EXIST. ELEV. 100.0 / PROP. ELEV. 100.0			

REMARKS

ALL BOUNDARY DATA SHOWN WAS OBTAINED FROM (DEEDS, RECORDED SUBDIVISION PLAT OR OTHER PUBLIC RECORDS)

LOCATIONS AS SHOWN OF ADJACENT WELLS AND SEPTIC TANKS OBTAINED FROM LAKE COUNTY HEALTH DEPARTMENT

DESIGN CERTIFICATION

THIS PLAT WAS PREPARED BY ME, AND IS CORRECT TO THE BEST OF MY KNOWLEDGE AND BELIEF.

NAME — SURVEYOR / REGISTRATION NO. #6343

CHECK LIST

NO. OF BEDROOMS	WATER MAIN SIZE, LOCATION
DIMENSIONS	SAN. SEWER SIZE % GR. LOC.
BEARINGS	SAN. MH. CAST. ELEV. INV. ELEV.
TIE TO NEAREST STREET	SAN. CONN. SIZE, LOC. DEPTH
SUBLOT NO. PARCEL NO.	STORM SEWER SIZE % GR. LOC.
SURROUNDING OWNERS	STORM MH. CAST ELEV. INV. ELEV.
BLDG. DIMENSIONS FIN. GR.	PAV'T TYPE GRADE CURBS
BLDG. TIES FL'R. GRADES	GAS LINE LOC. SIZE PRESSURE
APRON TYPE WIDTH THICKNESS	SEPTIC TANK LOCATION & DUPLICATION AREA
SIDEWALK TYPE WIDTH THICKNESS	WELL LOCATION
CULVERT TYPE DIA. LENGTH	ISOLATION RADIUS FROM WELL
ROCK OUTCROPPINGS	

REVISIONS		
NO.	DATE	BY
1		
2		
3		
4		
5		

PLAN PREPARED BY:
BABCOCK • JONES & ASSOCIATES, INC.
270 MAIN ST. — SUITE #20 — PAINESVILLE, OHIO

DRAWN BY: [illegible] — SCALE: 1" = 20' — PHONE NO. 357-1811
CHK'D: RT — DATE: 1/6/81 — DRAWING NO. 80-195
CREW CHIEF: CH — APP'D: RT

"AS BUILT" CERTIFICATION

I, HEREBY CERTIFY THAT THE CIRCLED GRADES ARE EXISTING FINISH GRADES CHECKED IN THE FIELD ON _____ 19____ AND ARE CORRECT TO THE BEST OF MY KNOWLEDGE AND BELIEF.

REGISTERED SURVEYOR — REG NO

★ DISCUSSED WITH Q.H.
9:10 AM 1-14-81

Grading Plan Approved as shown and/or noted
THOMAS P. GILLES, P.E.
Lake County Engineer
By _____ Date 1-12-81

This Permit Expires
JAN 9 1982
PAINESVILLE TOWNSHIP
ZONING APPROVED
5224
R. M. Hall
Zoning Inspector 1/9/81
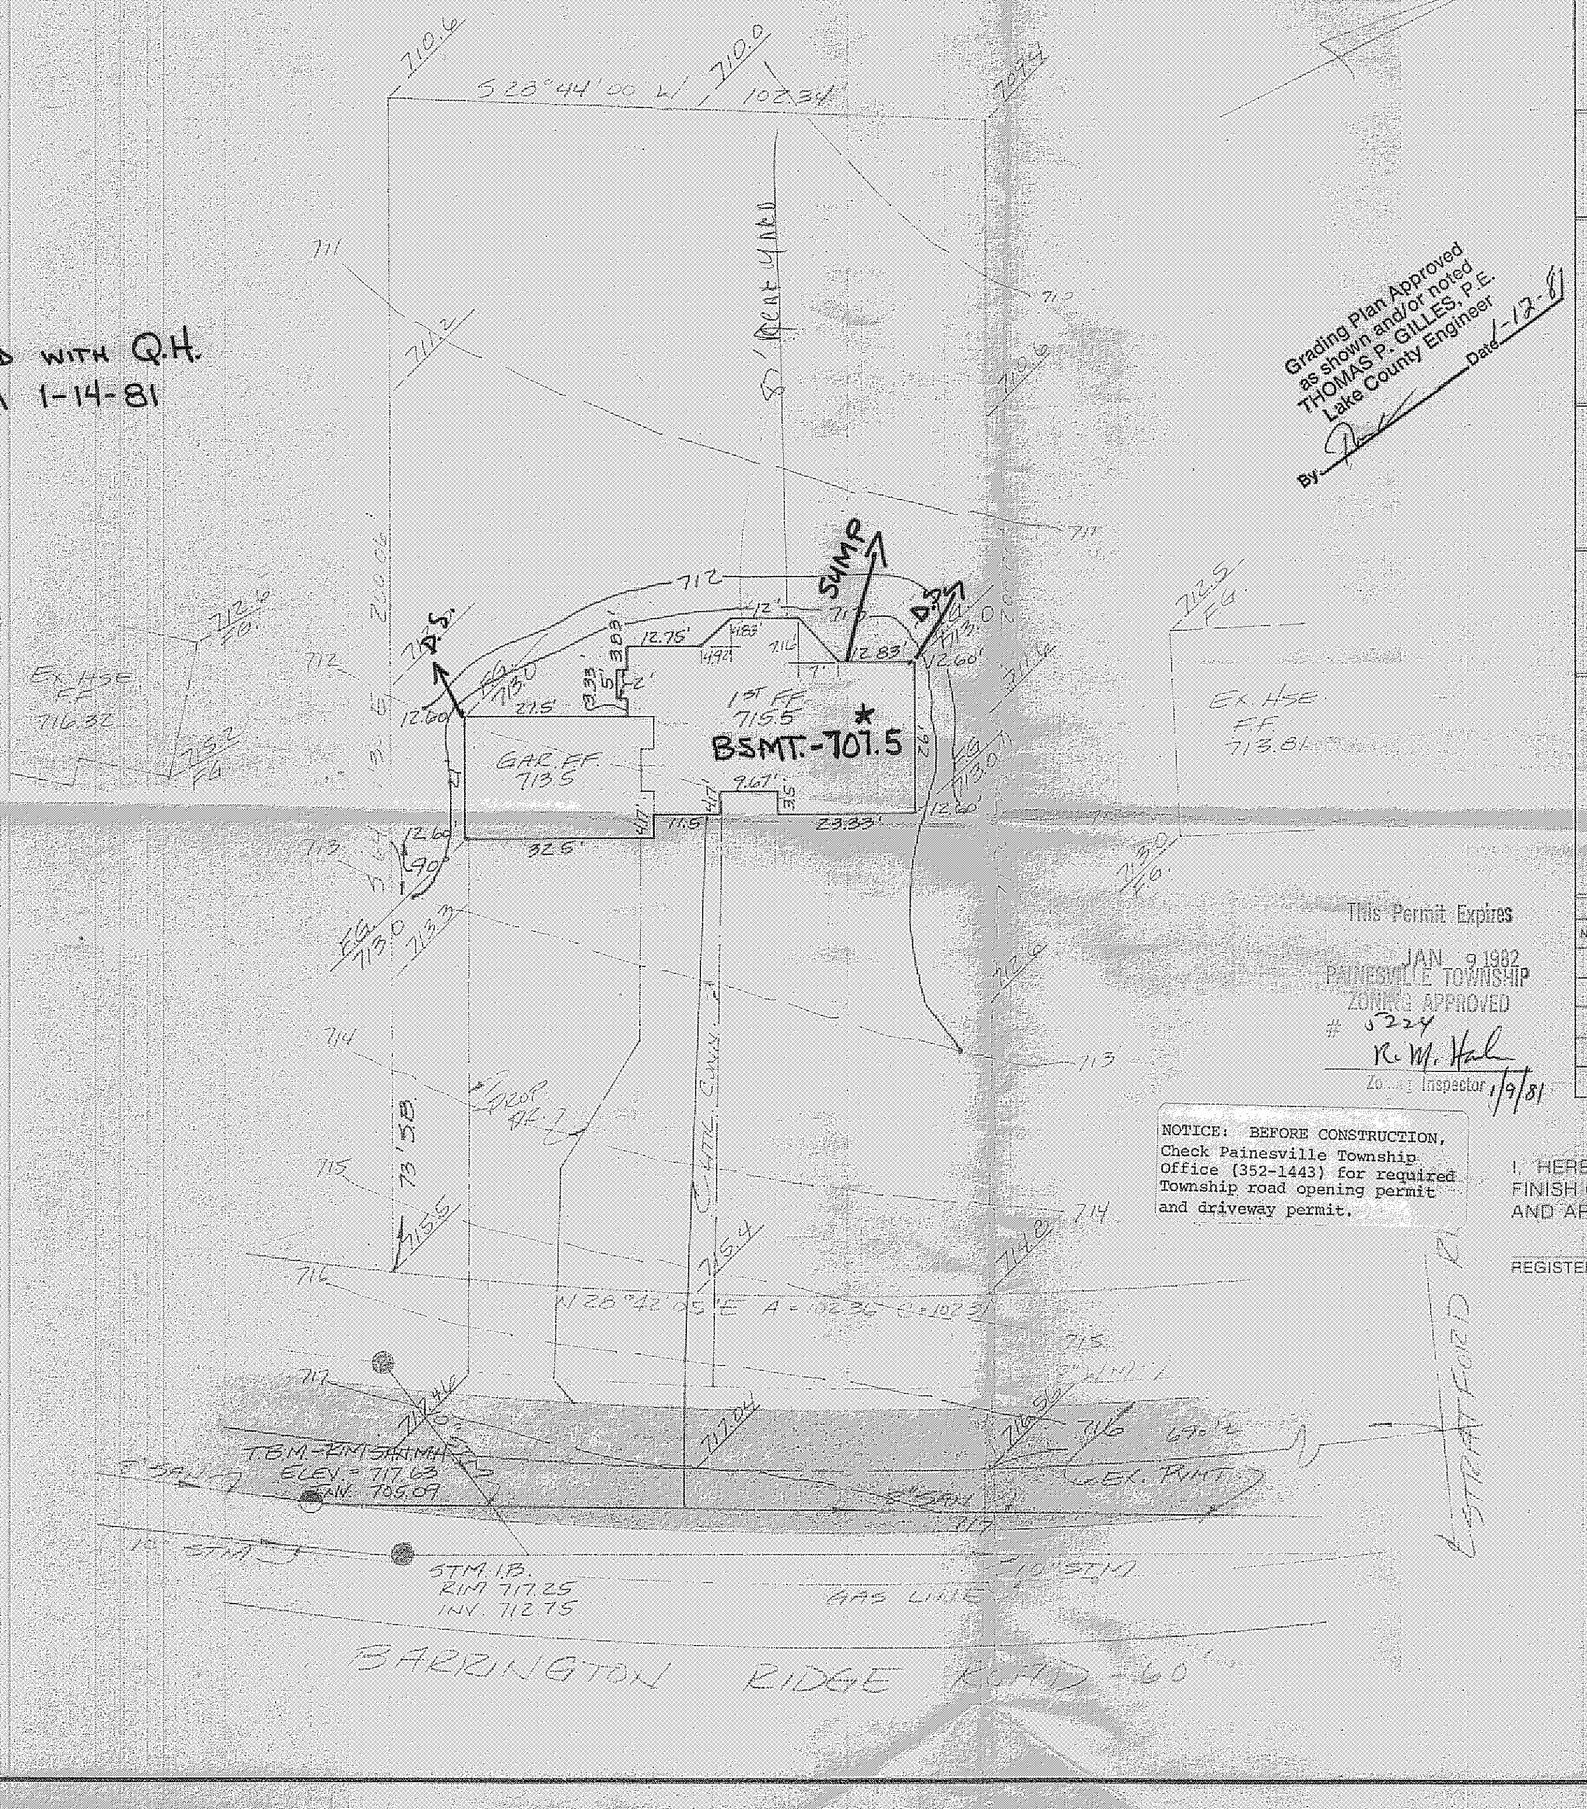
NOTICE: BEFORE CONSTRUCTION, Check Painesville Township Office (352-1443) for required Township road opening permit and driveway permit.