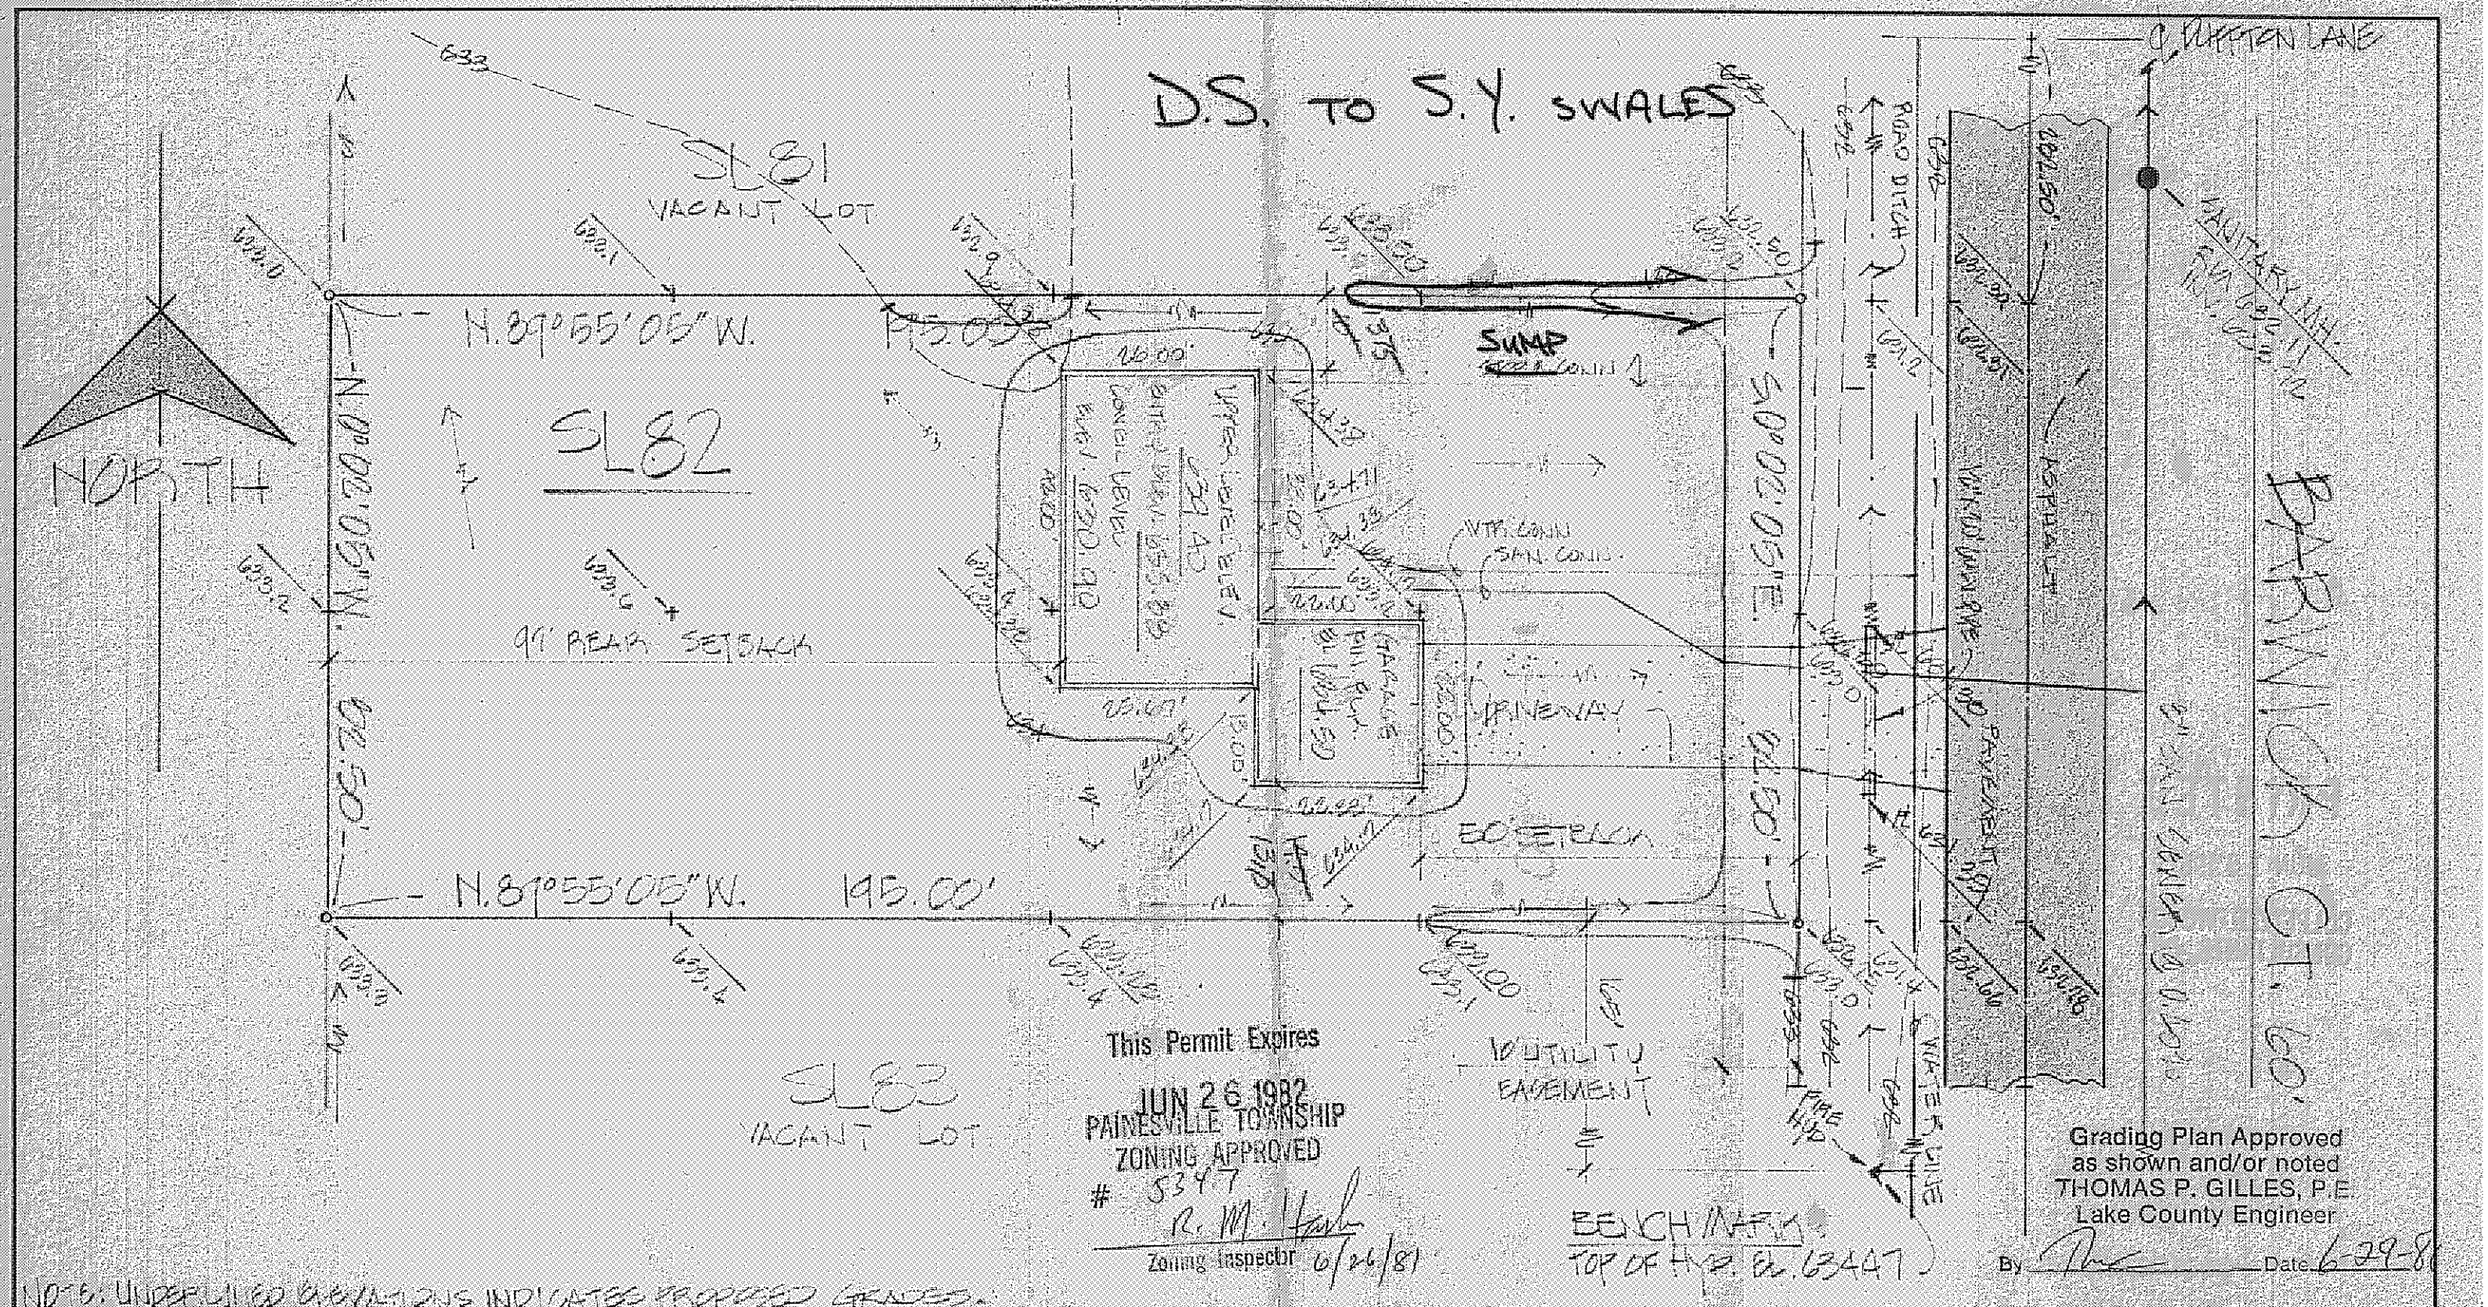

NOTE: UNDERLINED ELEVATIONS INDICATES PROPOSED GRADES.

DESIGN CERTIFICATION	AS BUILT CERTIFICATION			
THIS PLAT WAS PREPARED BY ME, AND IS CORRECT TO THE BEST OF MY KNOWLEDGE AND BELIEF.	I HEREBY CERTIFY THAT THE CIRCLED GRADES ARE EXISTING FINISH GRADES CHECKED IN THE FIELD ON _____ AND THAT SURVEY IS CORRECT TO THE BEST OF MY KNOWLEDGE AND BELIEF.	COLPETZER · WOODS CONSULTANTS, INC. 9470 MENTOR AVENUE • MENTOR, OHIO 44066 • (216) 357-7569	DATE JUNE 19, 1981 SCALE 1" = 20' DRWN BY Bertie CHKD BY JOB NO. 78-156 FB 332A PG	SITE PLAN FOR: EDWARD H. TRESGER, INC. 8100 DEEPWOOD BLVD., MENTOR, OHIO. BEING SUBLOT NO 82 IN THE PINES SUBD. NO. 2 PAINESVILLE TOWNSHIP, OHIO.
REG. SURVEYOR NO. 4765	REG. SURVEYOR NO.			