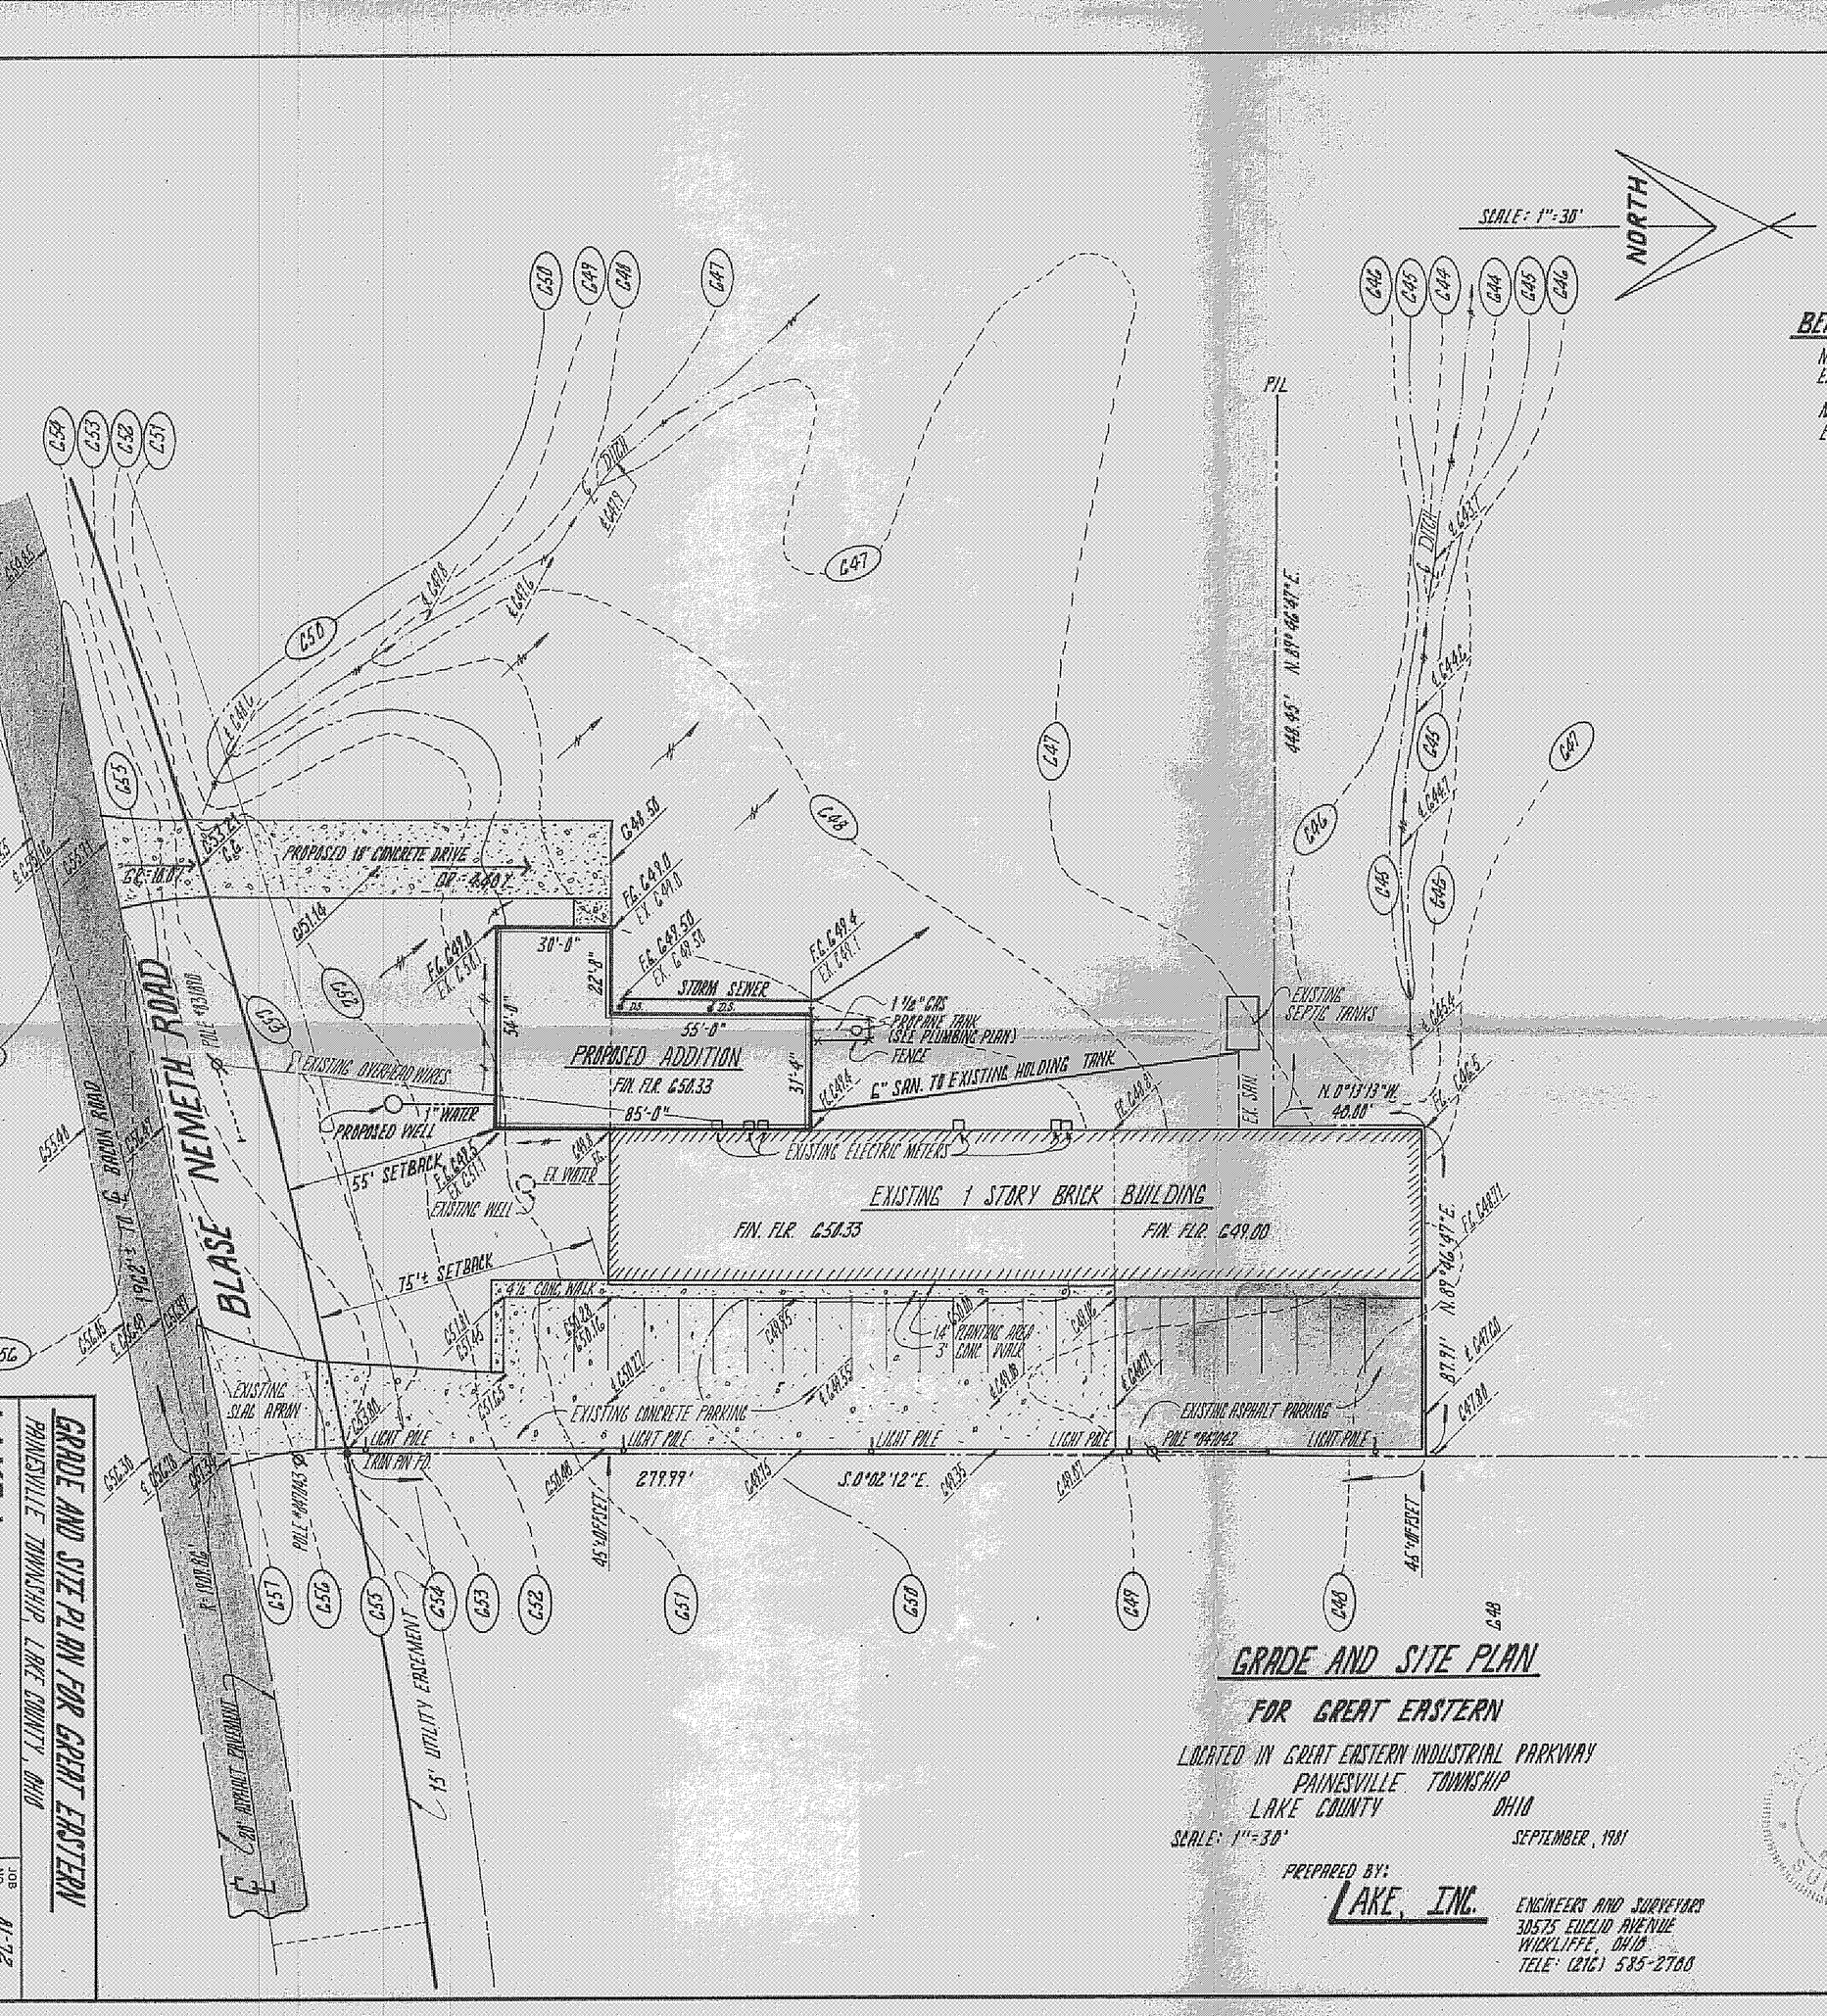


# GRADE AND SITE PLAN FOR GREAT EASTERN

PAINESVILLE TOWNSHIP, LAKE COUNTY, OHIO

JOB 81-22

E.P. #5267

Grading Plan Approved
as shown and/or noted
THOMAS P. GILLES, P.E.
Lake County Engineer
By _____ Date 10-16-81

## GRADE AND SITE PLAN

### FOR GREAT EASTERN

LOCATED IN GREAT EASTERN INDUSTRIAL PARKWAY
PAINESVILLE TOWNSHIP
LAKE COUNTY OHIO

SCALE: 1"=30' SEPTEMBER, 1981

PREPARED BY:

LAKE, INC.
ENGINEERS AND SURVEYORS
30575 EUCLID AVENUE
WICKLIFFE, OHIO
TELE: (216) 585-2780

REVISED: OCTOBER 15, 1981 AS PER COUNTY JAM