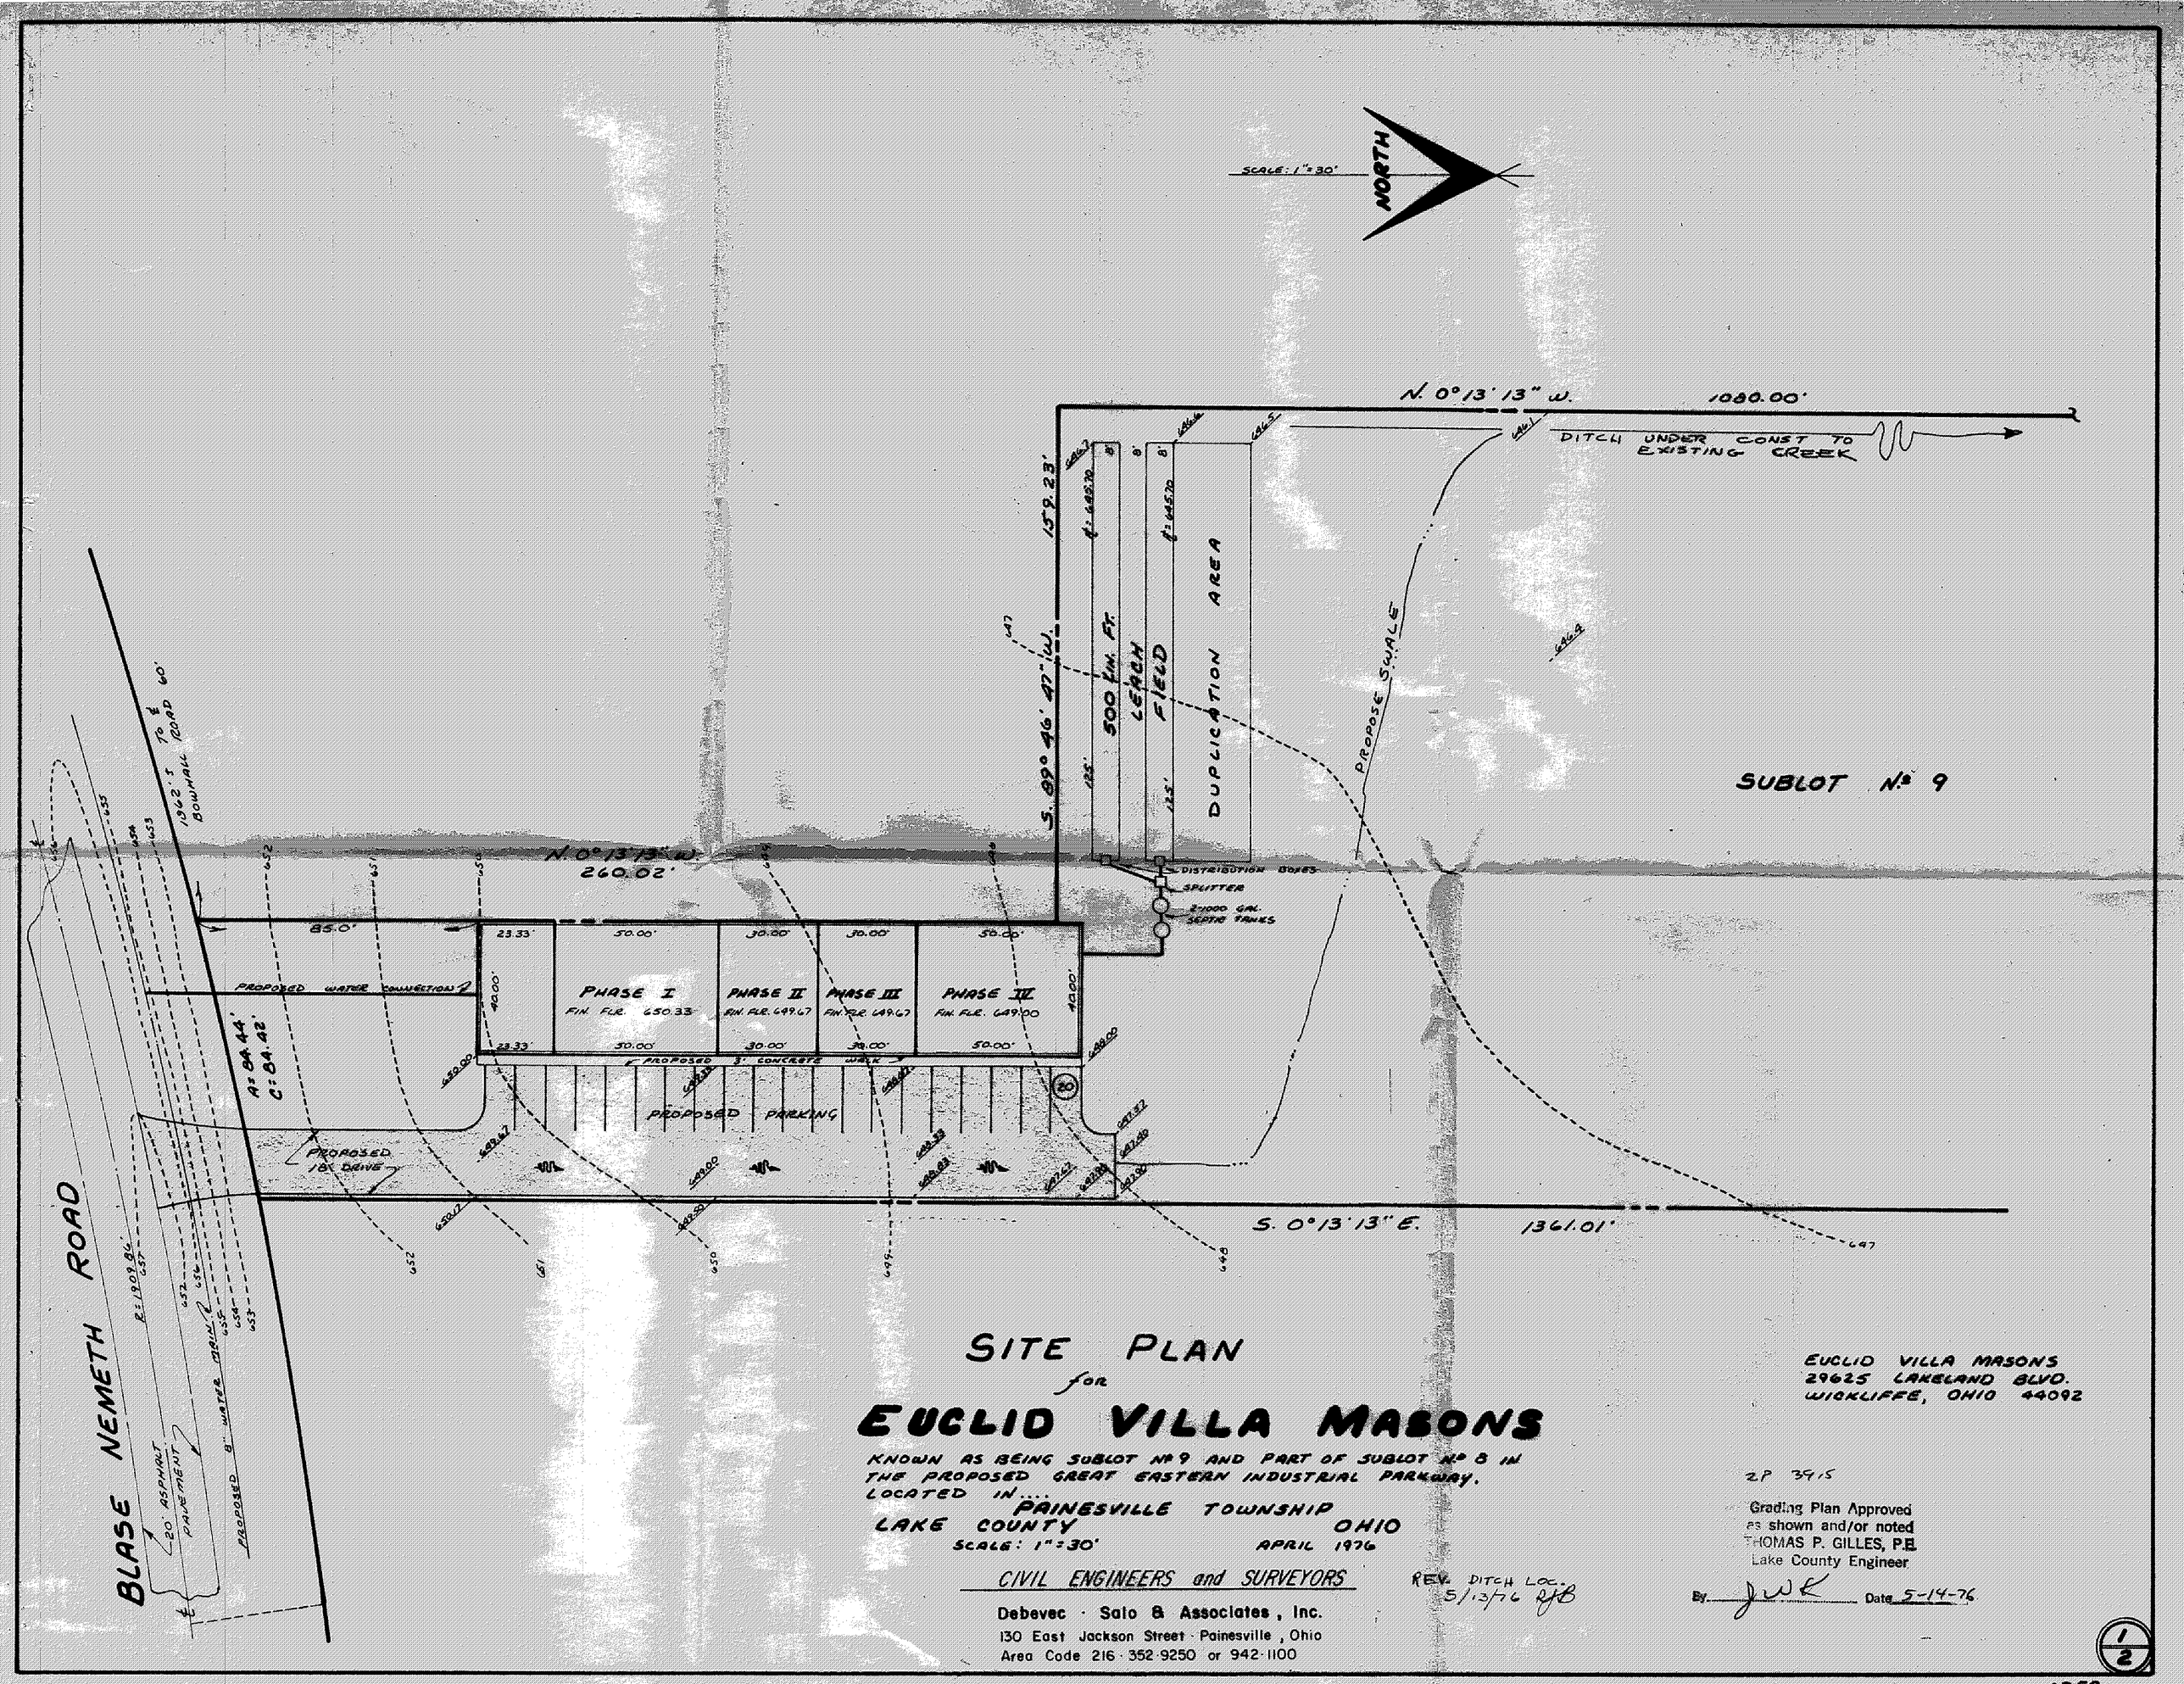

SITE PLAN
for
EUCLID VILLA MASONS

KNOWN AS BEING SUBLOT Nº 9 AND PART OF SUBLOT Nº 8 IN THE PROPOSED GREAT EASTERN INDUSTRIAL PARKWAY.
LOCATED IN.... PAINESVILLE TOWNSHIP
LAKE COUNTY OHIO
SCALE: 1"=30' APRIL 1976

EUCLID VILLA MASONS
29625 LAKELAND BLVD.
WICKLIFFE, OHIO 44092

CIVIL ENGINEERS and SURVEYORS
Debevec · Salo & Associates, Inc.
130 East Jackson Street · Painesville, Ohio
Area Code 216 · 352-9250 or 942-1100

REV. DITCH LOC. 5/13/76 RJB

ZP 3915
Grading Plan Approved as shown and/or noted
THOMAS P. GILLES, P.E.
Lake County Engineer
By. J W K Date 5-14-76

1/2

4259