PAINESVILLE TOWNSHIP
ZONING O.K.
PENDING DRAINAGE
R. Hall
Zoning Inspector

NOTE: SEE APPROVED GRADING PLAN ON FILE WITH THE COUNTY ENGINEER.

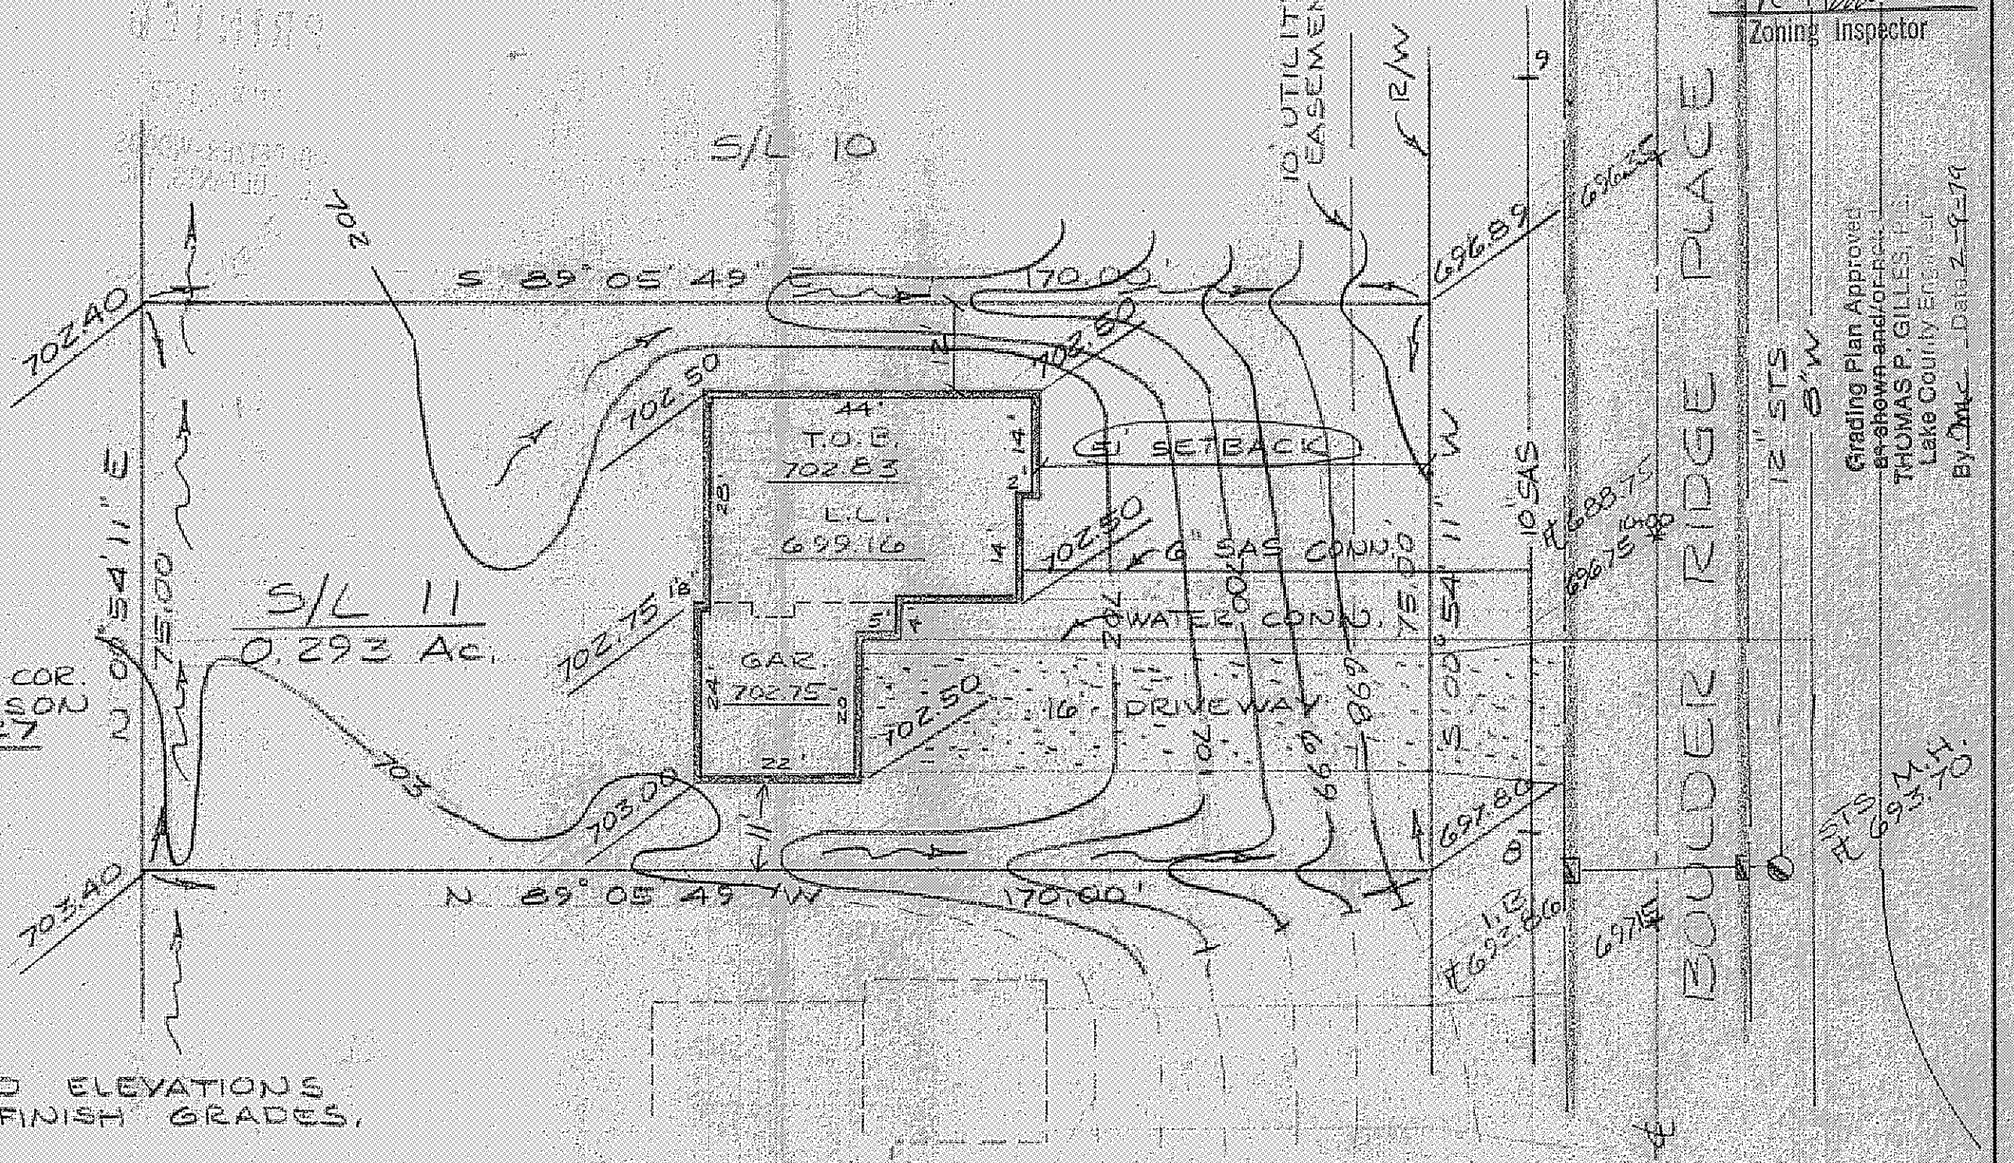

BENCH MARK: P.K. NAIL IN POLE N.E. COR. BOWHALL & MADISON AVE. ELEV. 695.27

NOTE: UNDERLINED ELEVATIONS ARE PROPOSED FINISH GRADES.

Grading Plan Approved as shown and/or noted
THOMAS P. GILLES P.E.
Lake County Engineer
By _____ Date 2-8-79

DESIGN CERTIFICATION

THIS PLAT WAS PREPARED BY ME, AND IS CORRECT TO THE BEST OF MY KNOWLEDGE AND BELIEF.

Eldon Woods

REG. SURVEYOR NO. 4785

AS BUILT CERTIFICATION

I HEREBY CERTIFY THAT THE CIRCLED GRADES ARE EXISTING FINISH GRADES CHECKED IN THE FIELD ON _____ AND THAT SURVEY IS CORRECT TO THE BEST OF MY KNOWLEDGE AND BELIEF.

REG. SURVEYOR NO. _____

COLPETZER · WOODS
CONSULTANTS, INC.
160 SOUTH STATE STREET • PAINESVILLE, OHIO 44077 • (216) 357-7569

DATE JAN. 79
SCALE 1" = 30'
DRWN BY
CHKD BY
JOB NO. 78282
FB. 321 PG 72

SITE PLAN FOR:
CASEMENT HOMES
1251 MADISON AVE. PAINESVILLE, OHIO
SUBLOT 11 BOULDER RIDGE SUBD.
PAINESVILLE TWP., LA. CO., OHIO