PAINESVILLE TOWNSHIP
ZONING O.K.
PENDING DRAINAGE
R. Hall
Zoning Inspector

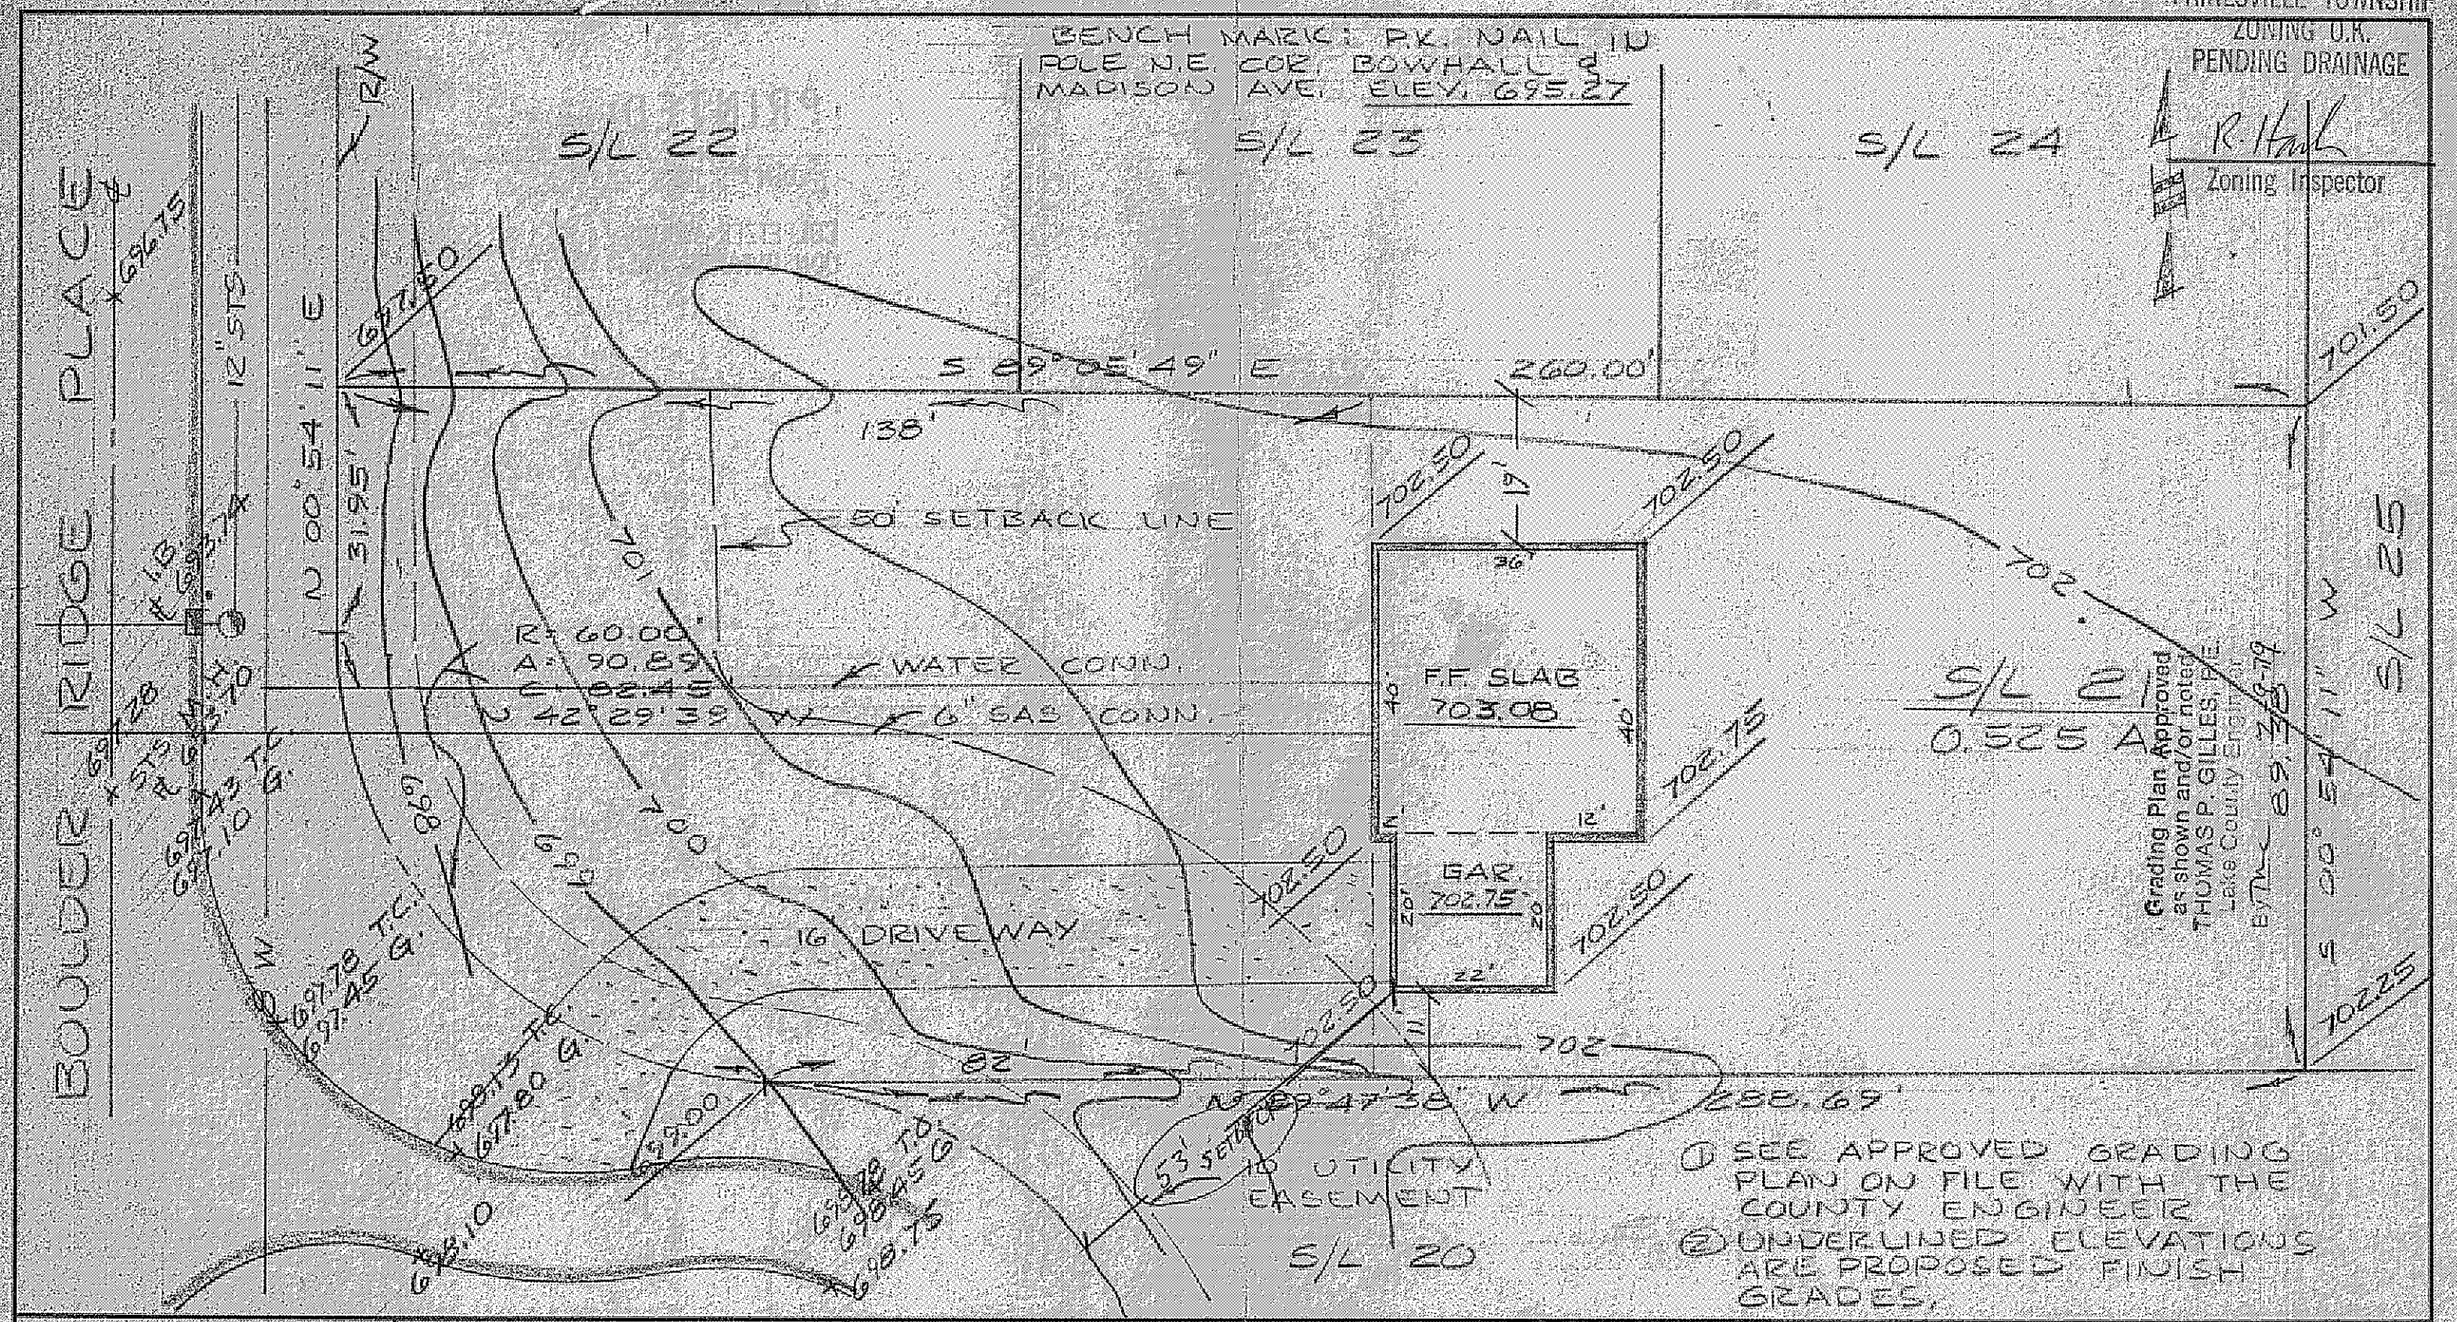

① SEE APPROVED GRADING PLAN ON FILE WITH THE COUNTY ENGINEER
② UNDERLINED ELEVATIONS ARE PROPOSED FINISH GRADES.

DESIGN CERTIFICATION

THIS PLAT WAS PREPARED BY ME AND IS CORRECT TO THE BEST OF MY KNOWLEDGE AND BELIEF.

REG. SURVEYOR NO. 4785

AS BUILT CERTIFICATION

I HEREBY CERTIFY THAT THE CIRCLED GRADES ARE EXISTING FINISH GRADES CHECKED IN THE FIELD ON _____ AND THAT SURVEY IS CORRECT TO THE BEST OF MY KNOWLEDGE AND BELIEF.

REG. SURVEYOR NO. _____

COLPETZER · WOODS
CONSULTANTS, INC.
180 SOUTH STATE STREET • PAINESVILLE, OHIO 44077 • (216) 357-7569

DATE JAN. 79
SCALE 1"=20'
DRWN BY CG
CHKD BY
JOB NO. 78-282
FB 321 PG 72

SITE PLAN FOR:
CASEMENT HOMES
1251 MADISON AVE PAINESVILLE, OHIO
SUBLOT 21 BOULDER RIDGE SUBD.
PAINESVILLE TWP., LA. CO., OHIO