PAINESVILLE TOWNSHIP
ZONING O.K.
PENDING DRAINAGE
R. Hall
Zoning Inspector

NOTE: SEE APPROVED GRADING PLAN ON FILE WITH THE COUNTY ENGINEER.

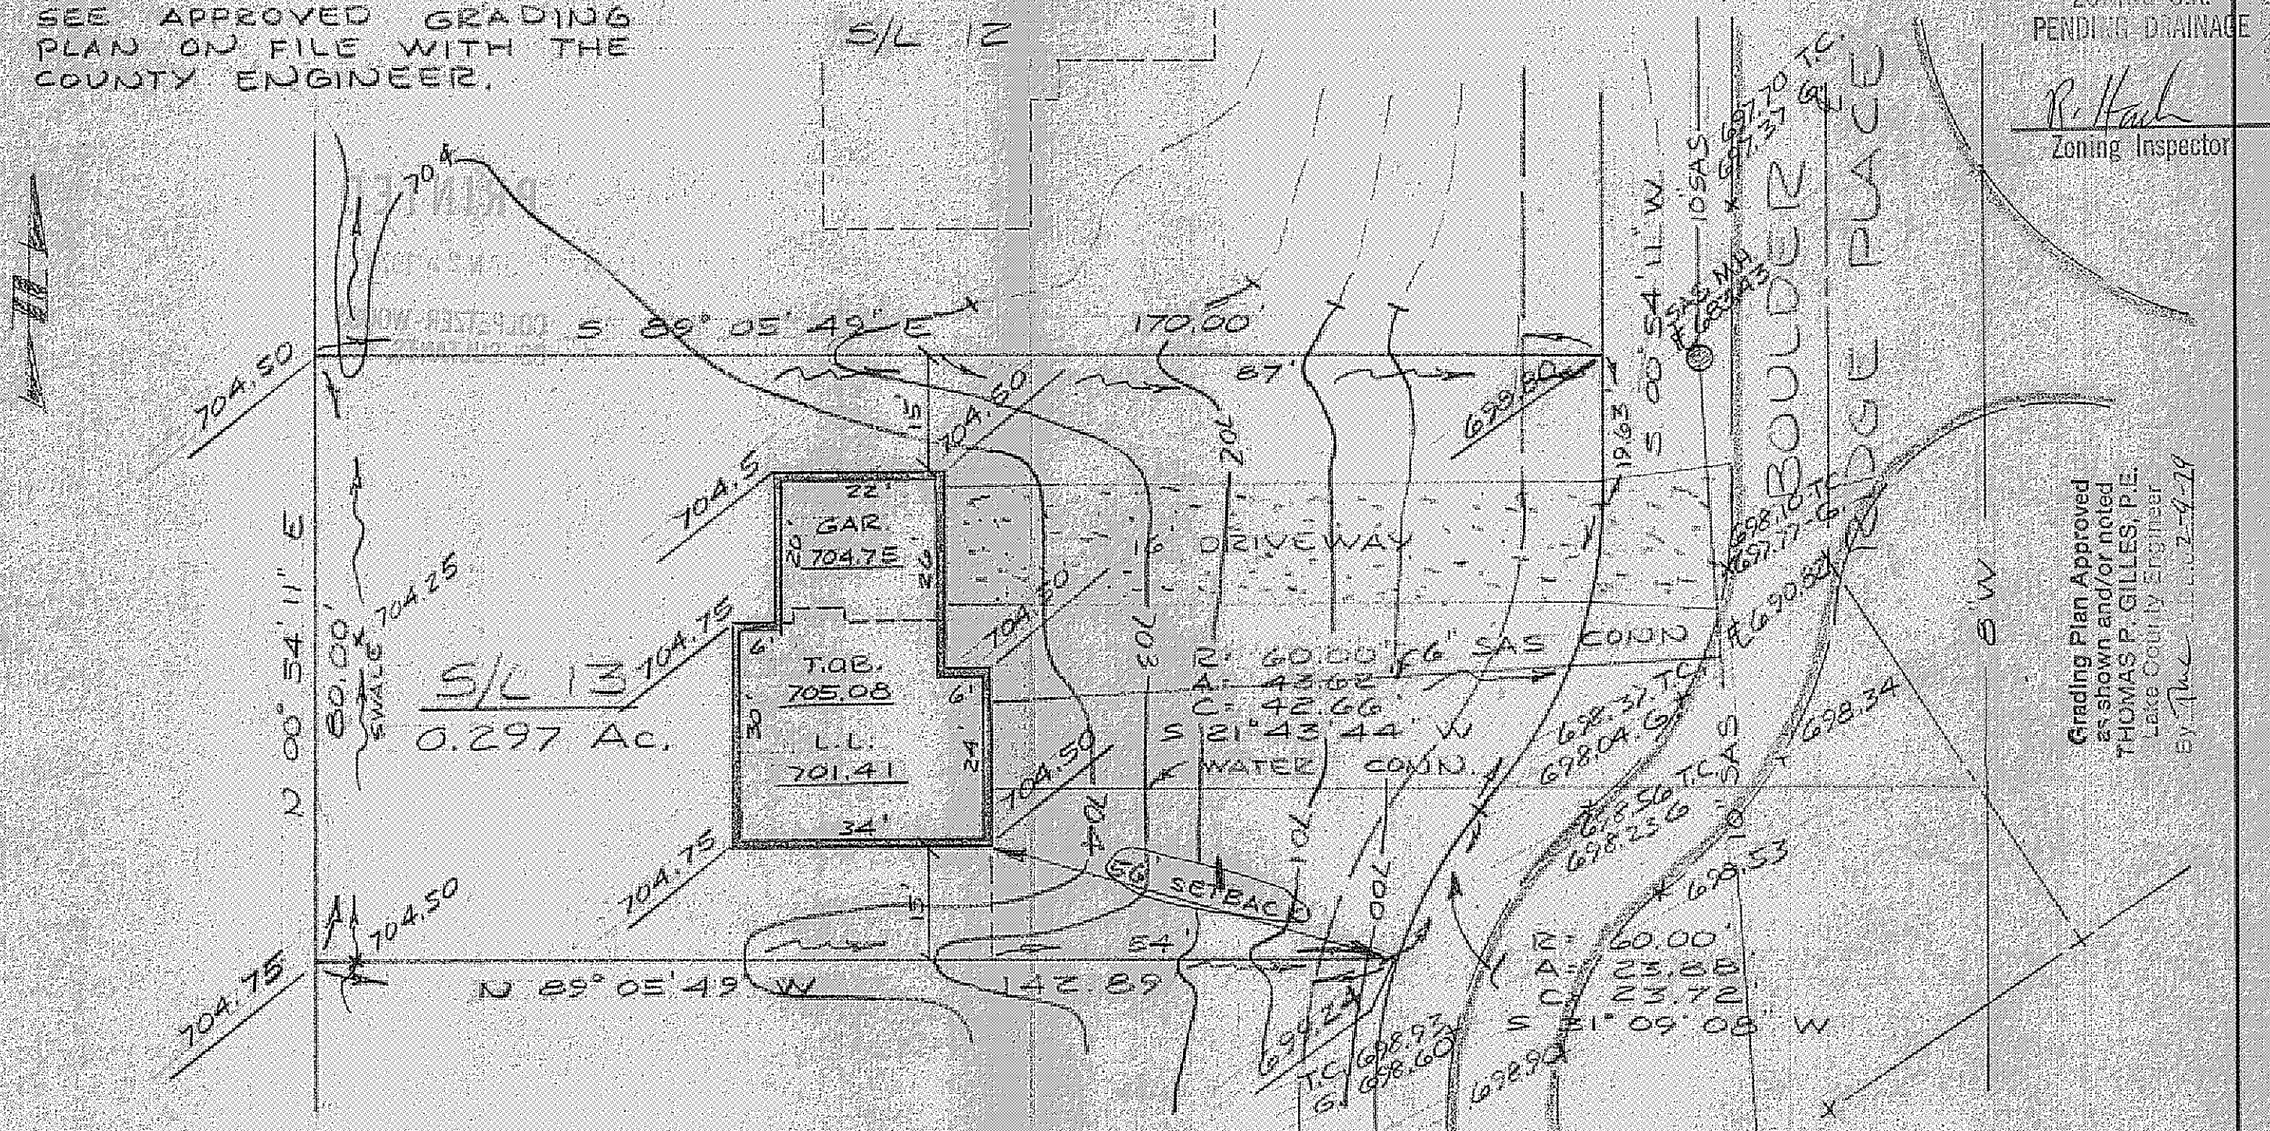

NOTE: UNDERLINED ELEVATIONS ARE PROPOSED FINISH GRADES.

BENCH MARK: P.K. NAIL IN POLE N.E. COR. BOWHALL & MADISON AVE. ELEV. 695.27

Grading Plan Approved as shown and/or noted
THOMAS P. GILLES, P.E.
Lake County Engineer
By [illegible] 2-4-79

DESIGN CERTIFICATION	AS BUILT CERTIFICATION			
THIS PLAT WAS PREPARED BY ME, AND IS CORRECT TO THE BEST OF MY KNOWLEDGE AND BELIEF.	I HEREBY CERTIFY THAT THE CIRCLED GRADES ARE EXISTING FINISH GRADES CHECKED IN THE FIELD ON _____ AND THAT SURVEY IS CORRECT TO THE BEST OF MY KNOWLEDGE AND BELIEF.	COLPETZER · WOODS CONSULTANTS, INC. 180 SOUTH STATE STREET • PAINESVILLE, OHIO 44077 • (216) 357-7569	DATE JAN. 79 SCALE 1" = 20' DRWN BY [illegible] CHKD BY [illegible] JOB NO. 18222 FB 321 PG 72	SITE PLAN FOR: CASEMENT HOMES 1251 MADISON AVE. PAINESVILLE, OHIO LOT 13 BOULDER RIDGE SUBD. PAINESVILLE TWP., LA. CO., OHIO
REG. SURVEYOR NO. 4785	REG. SURVEYOR NO. _____			