PAINESVILLE TOWNSHIP
ZONING O.K.
PENDING DRAINAGE

R. Hach
Zoning Inspector

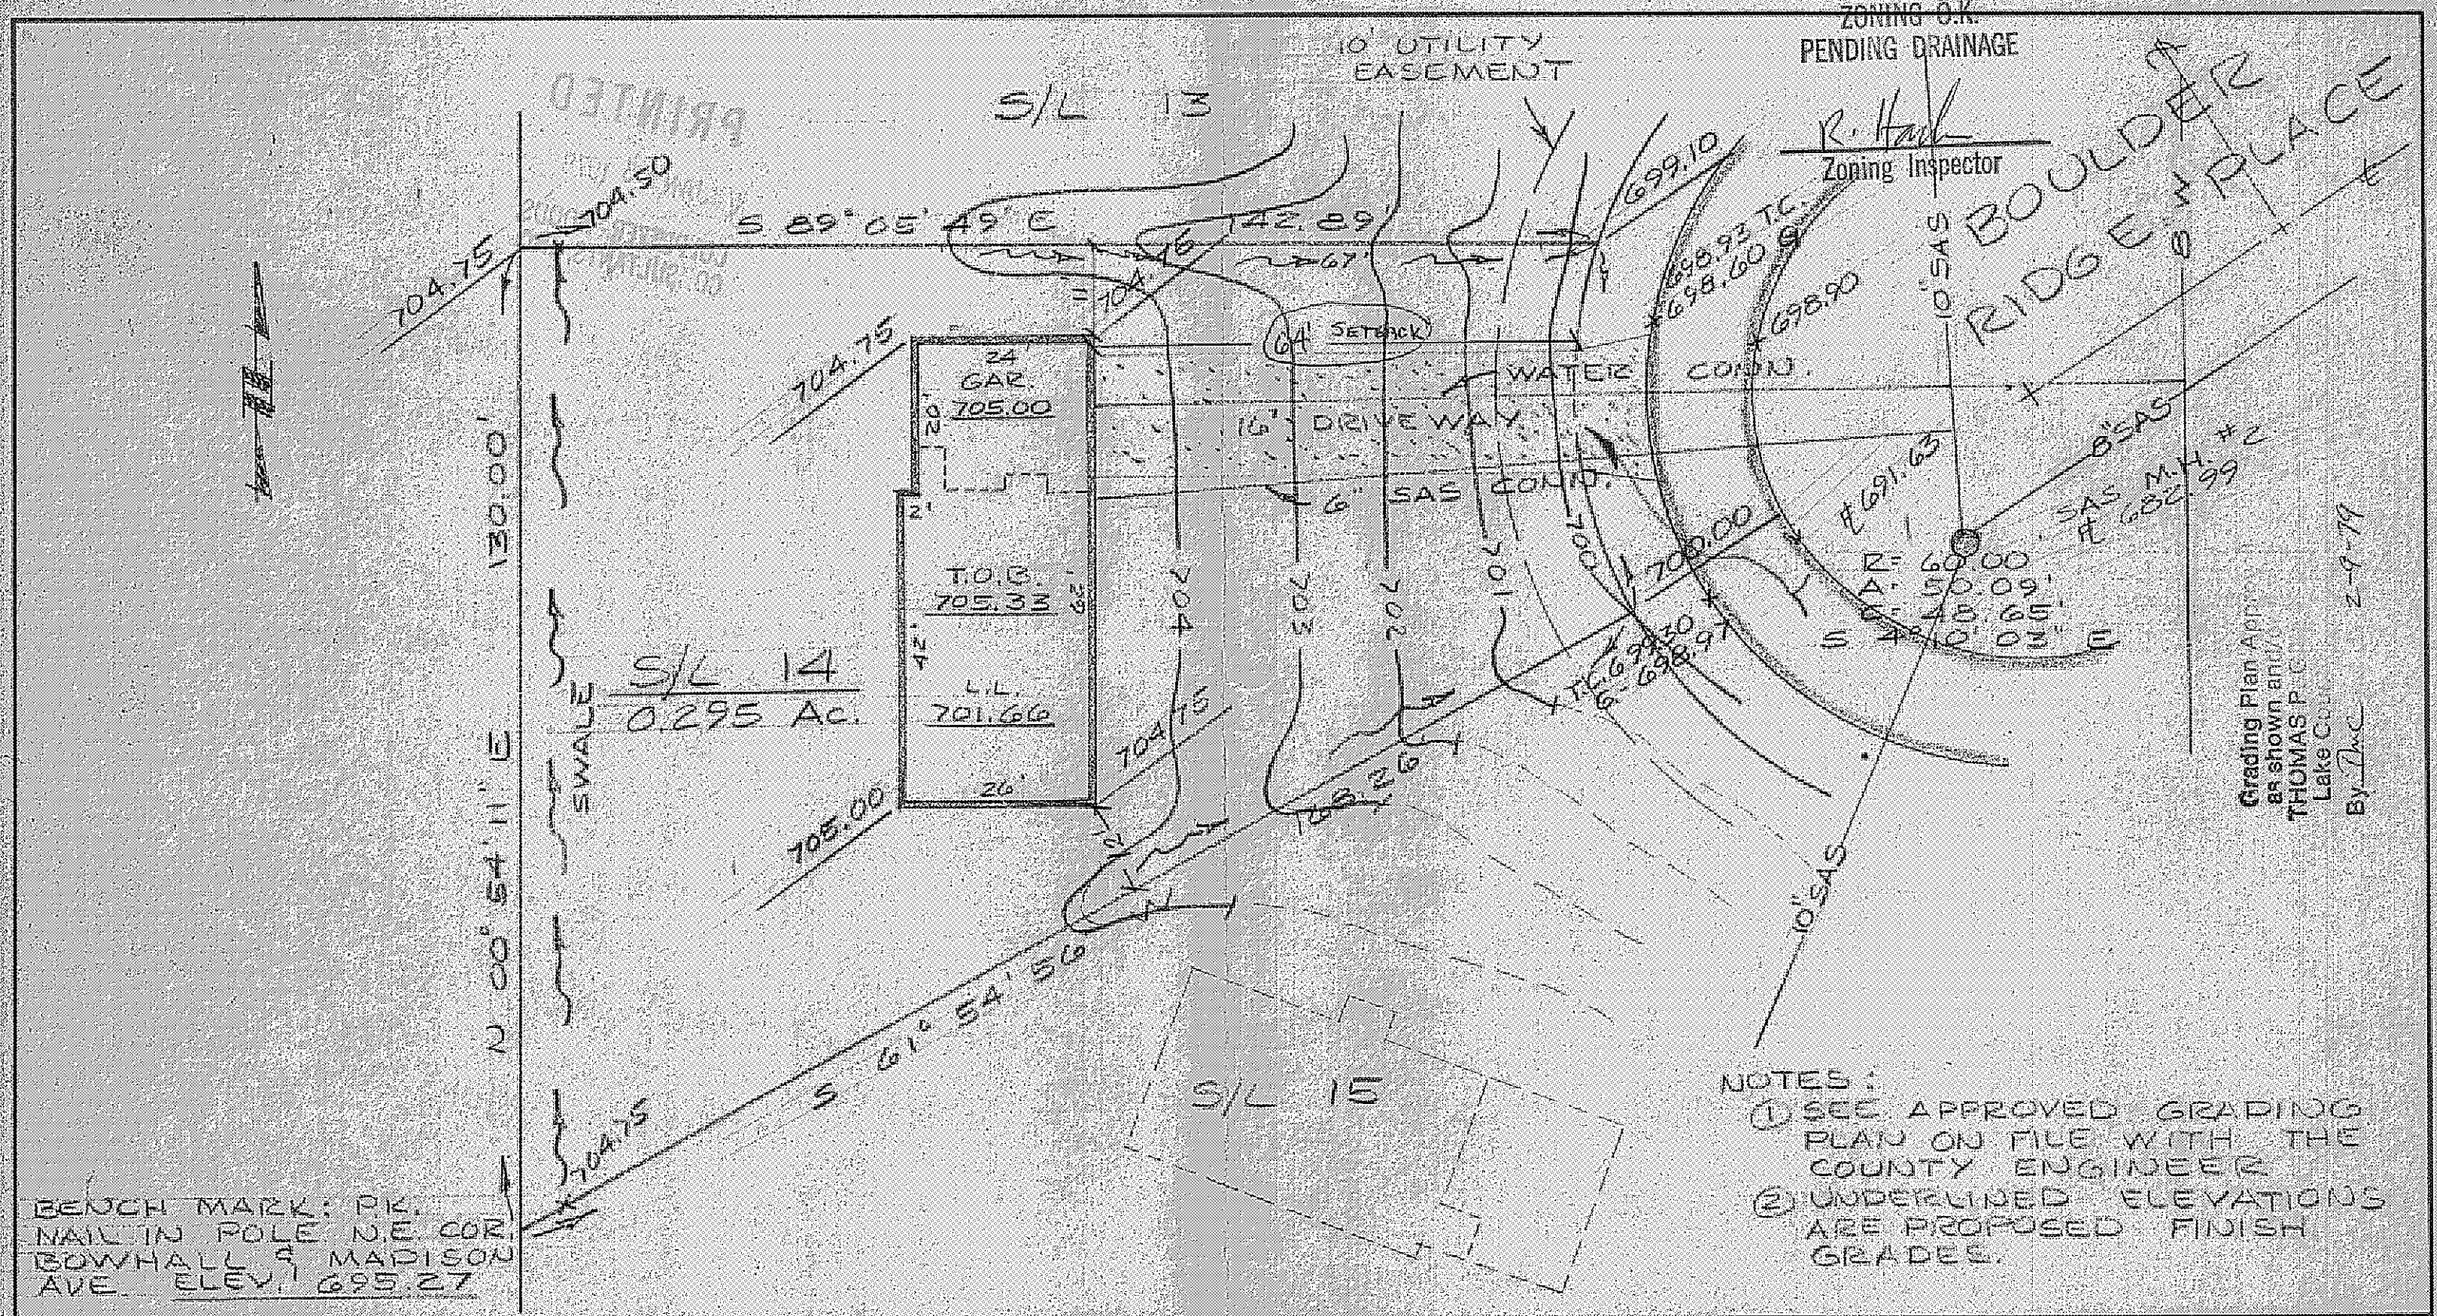


NOTES:
1. SEE APPROVED GRADING PLAN ON FILE WITH THE COUNTY ENGINEER
2. UNDERLINED ELEVATIONS ARE PROPOSED FINISH GRADES.

BENCH MARK: P.K. NAIL IN POLE N.E. COR. BOWHALL & MADISON AVE. ELEV. 695.27

| DESIGN CERTIFICATION | AS BUILT CERTIFICATION | | | |
|---|---|---|---|---|
| THIS PLAT WAS PREPARED BY ME, AND IS CORRECT TO THE BEST OF MY KNOWLEDGE AND BELIEF. | I HEREBY CERTIFY THAT THE CIRCLED GRADES ARE EXISTING FINISH GRADES CHECKED IN THE FIELD ON _____ AND THAT SURVEY IS CORRECT TO THE BEST OF MY KNOWLEDGE AND BELIEF. | COLPETZER · WOODS CONSULTANTS, INC. 180 SOUTH STATE STREET • PAINESVILLE, OHIO 44077 • (216) 357-7569 | DATE JAN. 79<br>SCALE 1"=20'<br>DRWN BY [illegible]<br>CHKD BY [illegible]<br>JOB NO. 78282<br>FB 321 PG 72 | SITE PLAN FOR: CASEMENT HOMES<br>1251 MADISON AVE. PAINESVILLE, OHIO<br>SUBLOT 14 BOULDER RIDGE SUBD.<br>PAINESVILLE TWP., LA. CO., OHIO |
| REG. SURVEYOR NO. 4785 | REG. SURVEYOR NO. _____ | | | |