PAINESVILLE TOWNSHIP
ZONING O.K.
PENDING DRAINAGE

R. Hark
Zoning Inspector

NOTES:
1. SEE APPROVED GRADING PLAN ON FILE WITH THE COUNTY ENGINEER.
2. UNDERLINED ELEVATION ARE PROPOSED FINISH GRADES.
3. BENCH MARK: P.K. NAIL IN POLE N.E. COR. OF BOWHALL & MADISON AVE. ELEV. 695.27

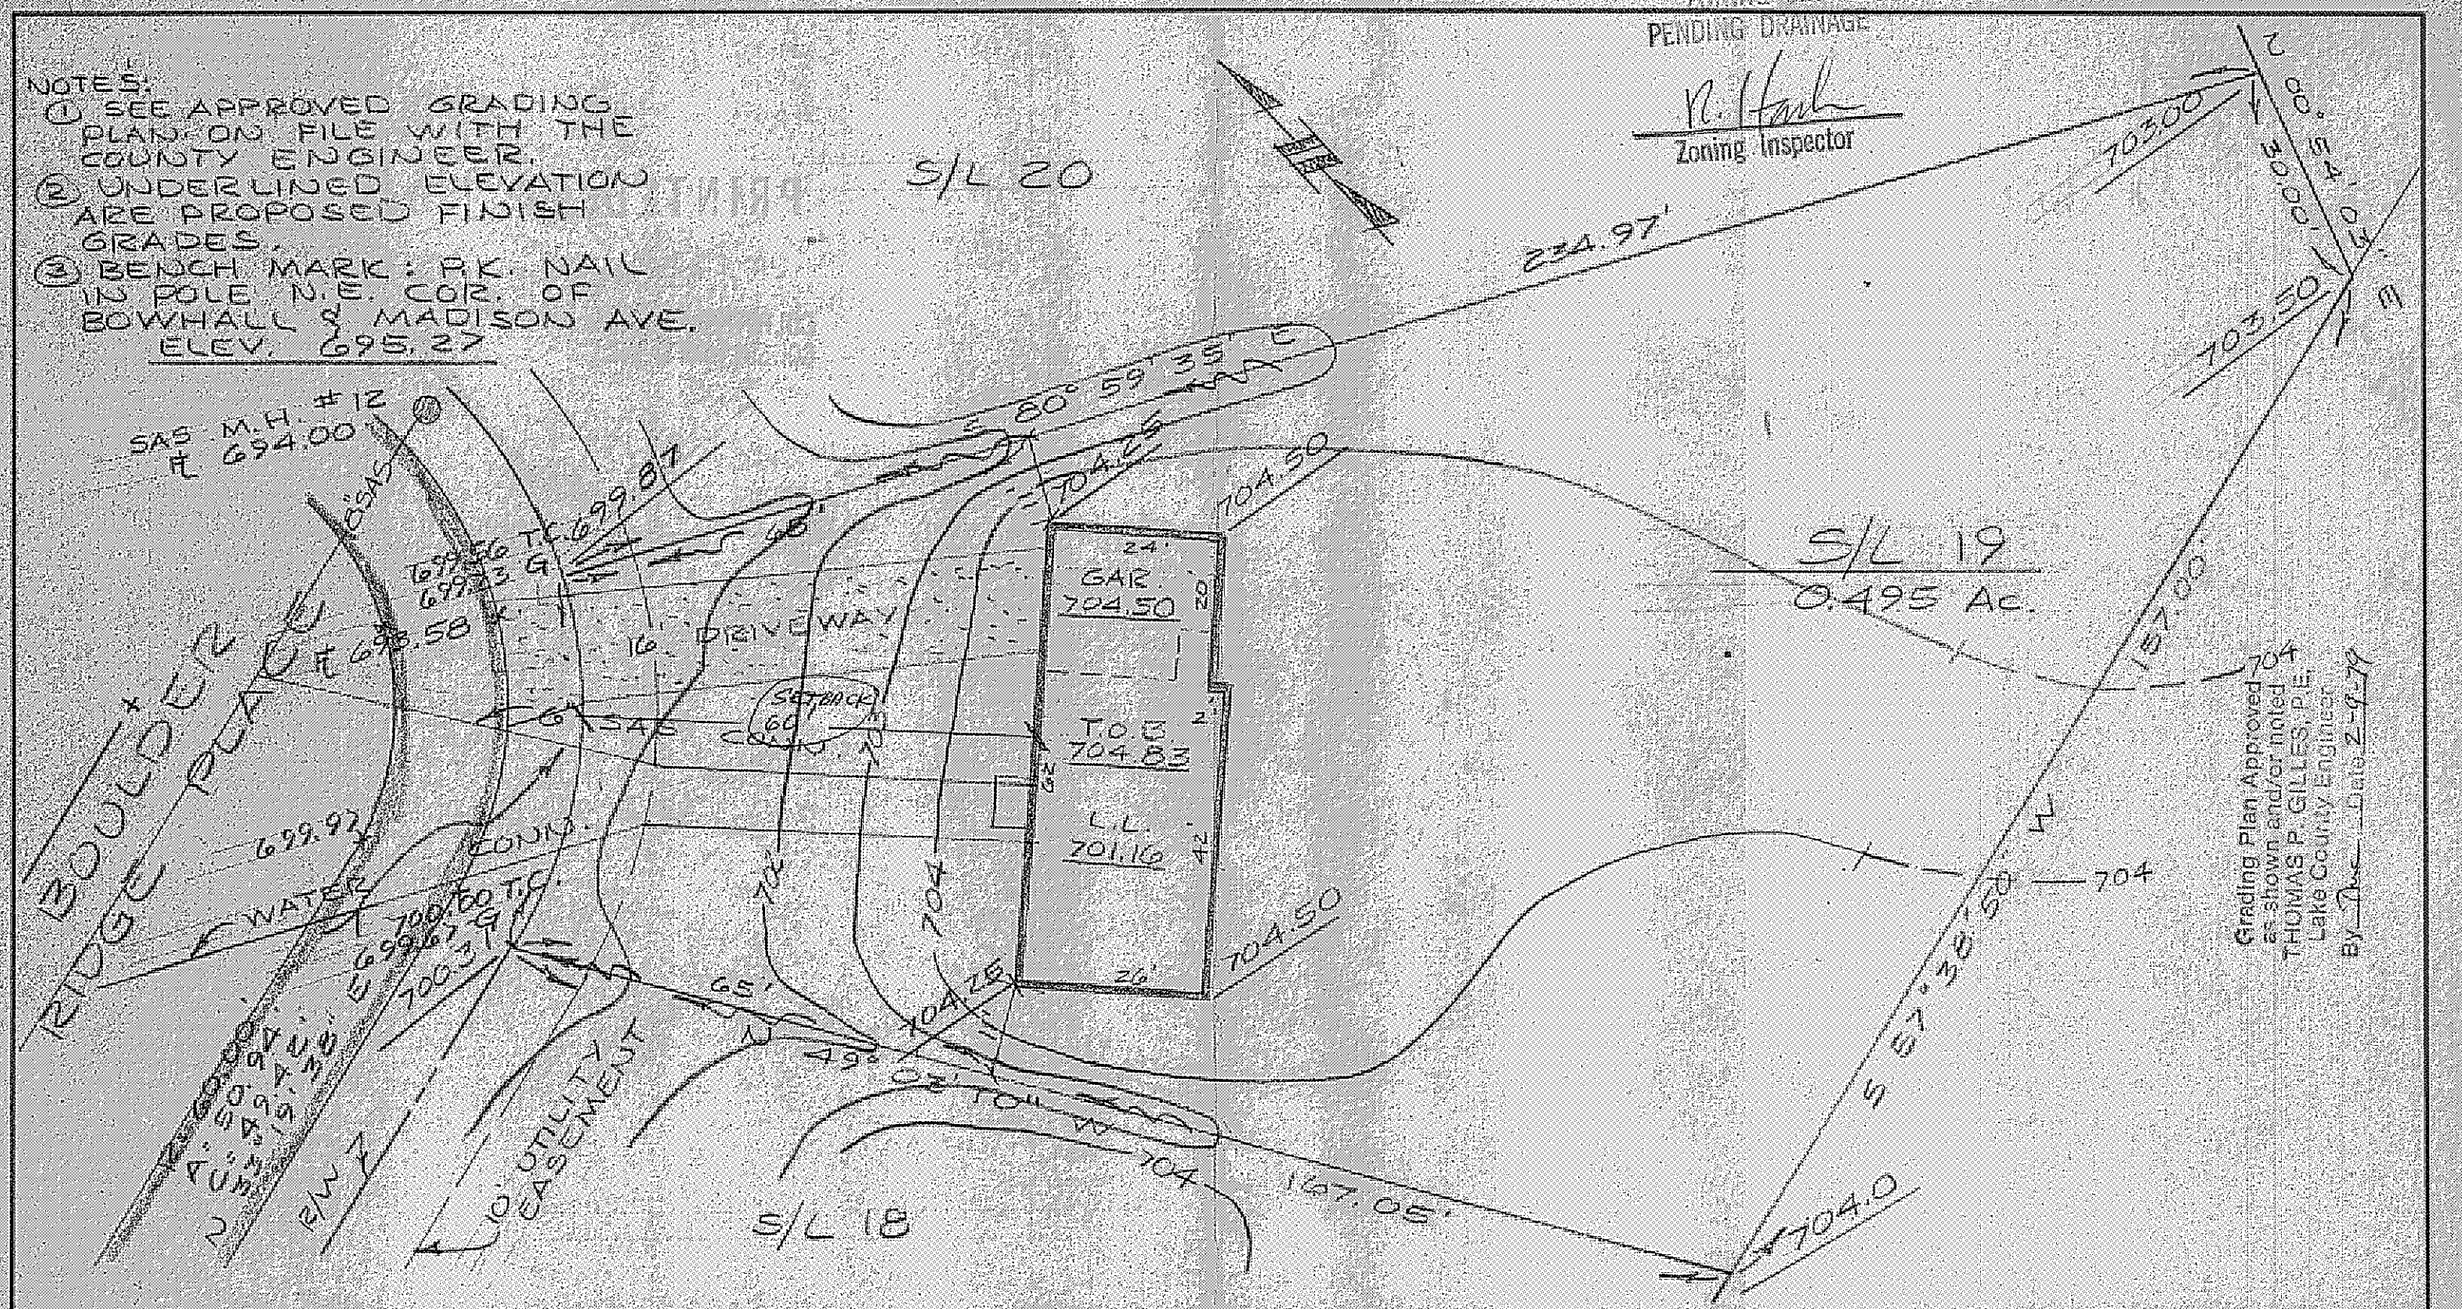

Grading Plan Approved as shown and/or noted
THOMAS P. GILLES, P.E.
Lake County Engineer
By [signature] Date 2-9-79

DESIGN CERTIFICATION	AS BUILT CERTIFICATION			
THIS PLAT WAS PREPARED BY ME, AND IS CORRECT TO THE BEST OF MY KNOWLEDGE AND BELIEF. [signature] REG. SURVEYOR NO. 4785	I HEREBY CERTIFY THAT THE CIRCLED GRADES ARE EXISTING FINISH GRADES CHECKED IN THE FIELD ON _____ AND THAT SURVEY IS CORRECT TO THE BEST OF MY KNOWLEDGE AND BELIEF. REG. SURVEYOR NO. _____	COLPETZER · WOODS CONSULTANTS, INC. 180 SOUTH STATE STREET • PAINESVILLE, OHIO 44077 • (216) 357-7569	DATE JAN. 79 SCALE 1"=20' DRWN BY [initials] CHKD BY [initials] JOB NO 78 282 FB 321 PG 72	SITE PLAN FOR: CASEMENT HOMES 1251 MADISON AVE PAINESVILLE, OHIO SUBLOT 19 BOULDER RIDGE SUBD. PAINESVILLE TWP., LA. CO., OHIO