PAINESVILLE TOWNSHIP
ZONING O.K.
PENDING DRAINAGE

R. Hark
Zoning Inspector

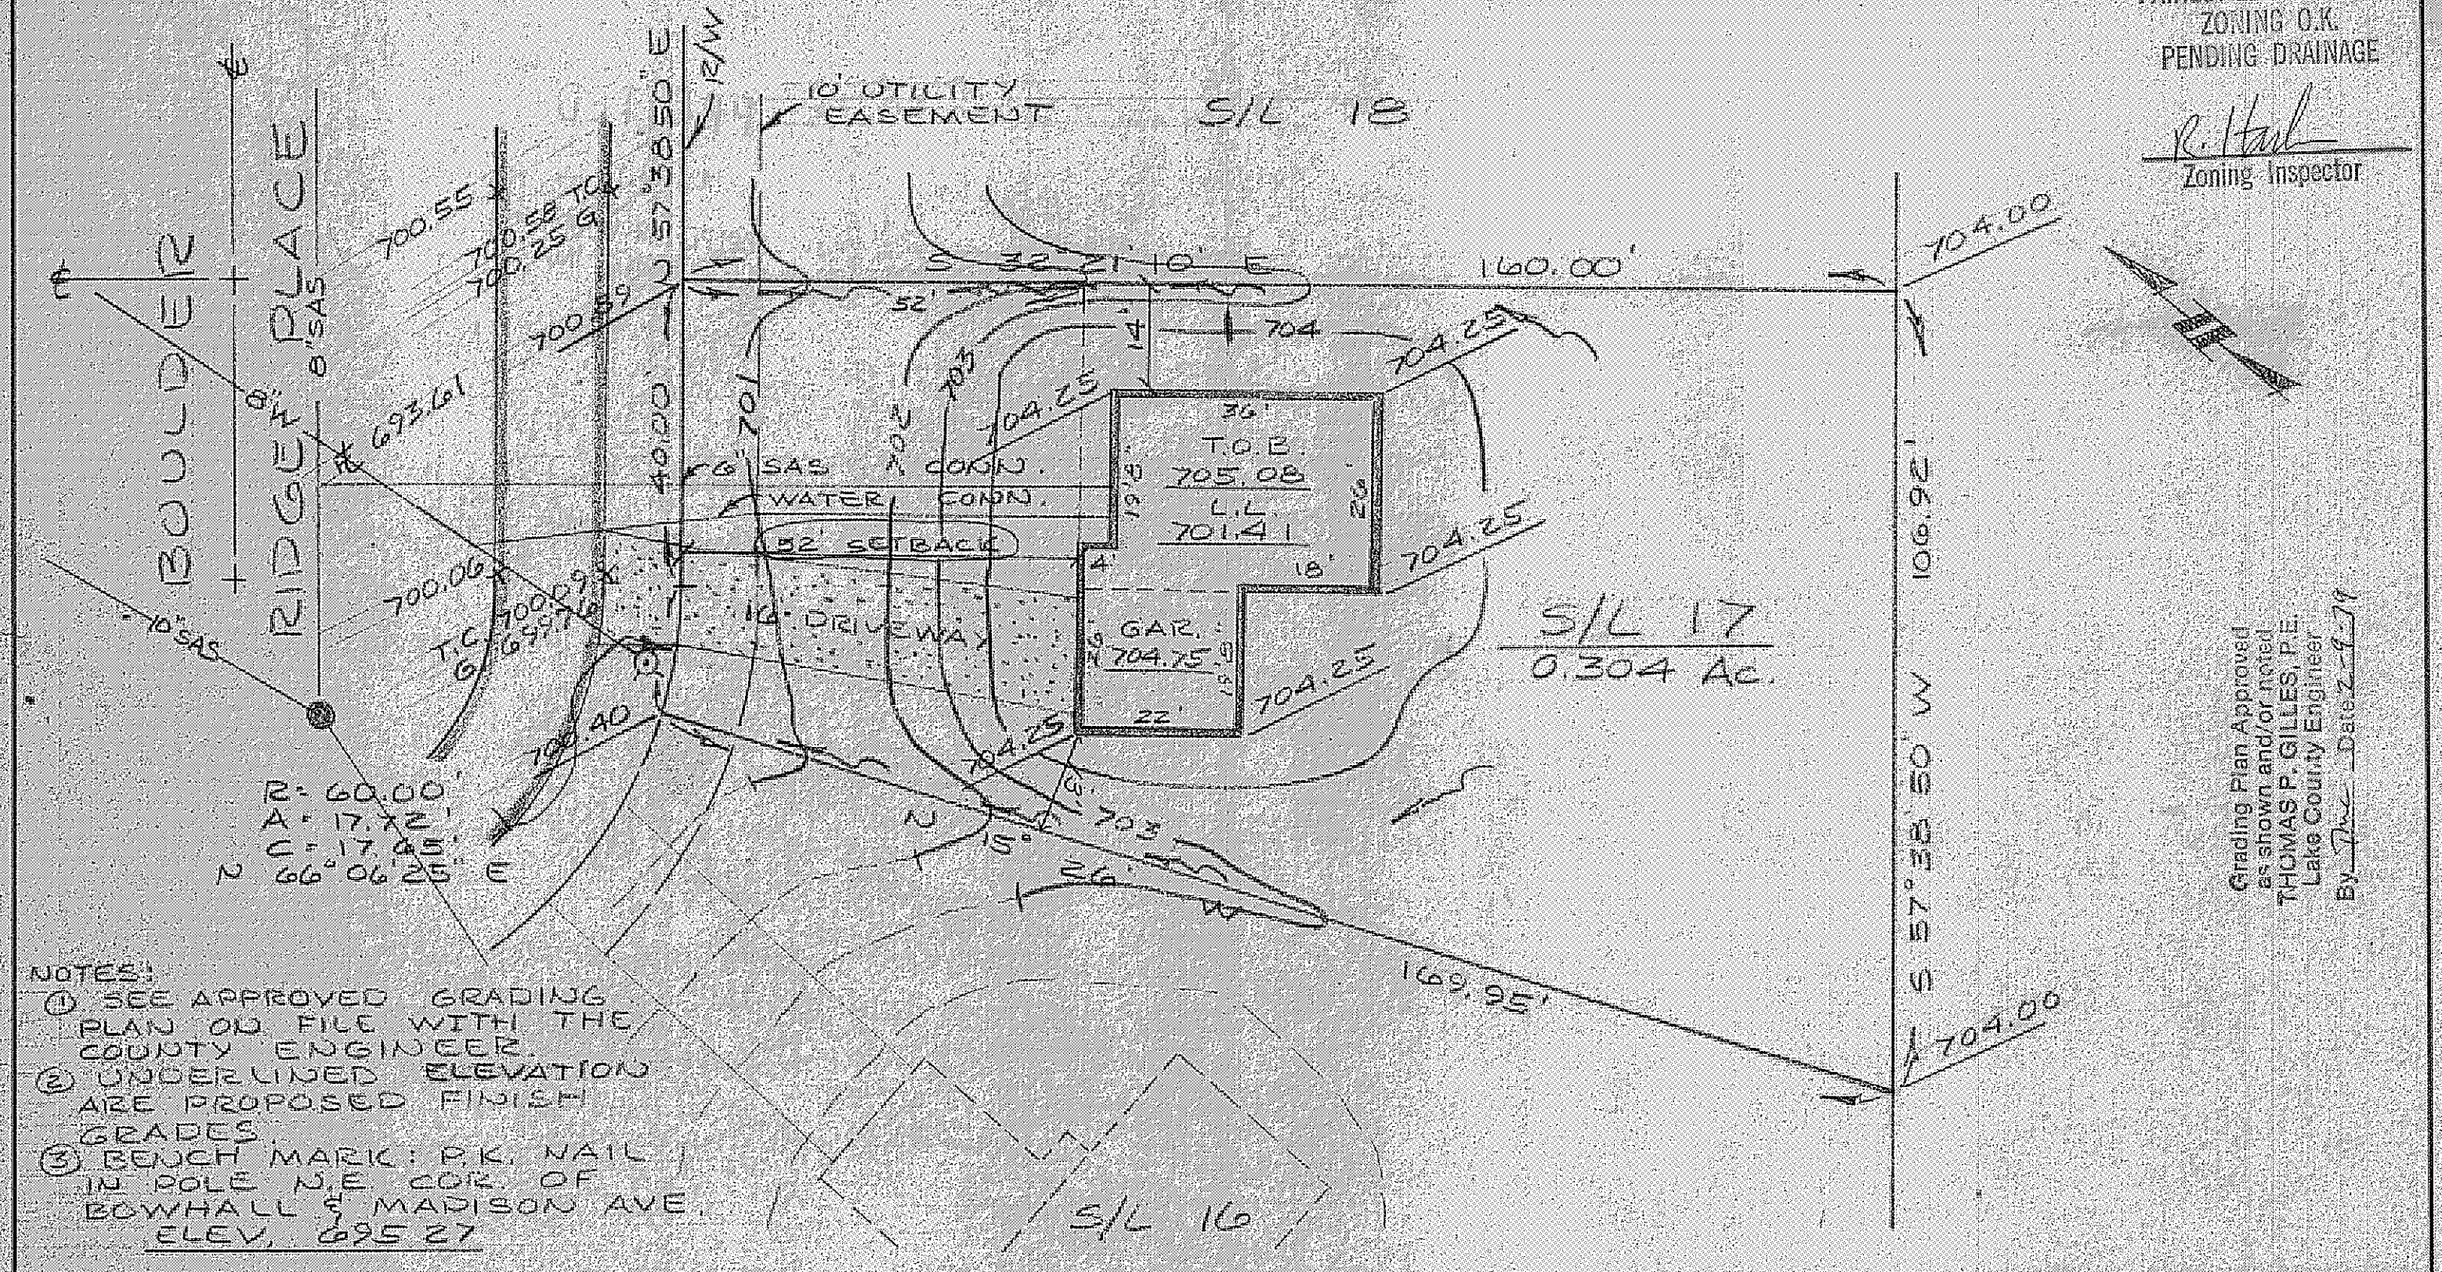

NOTES:
1. SEE APPROVED GRADING PLAN ON FILE WITH THE COUNTY ENGINEER.
2. UNDERLINED ELEVATIONS ARE PROPOSED FINISH GRADES.
3. BENCH MARK: P.K. NAIL IN POLE N.E. COR. OF BOWHALL & MADISON AVE. ELEV. 695.27

Grading Plan Approved as shown and/or noted
THOMAS P. GILLES, P.E.
Lake County Engineer
By _____ Date 2-4-79

DESIGN CERTIFICATION

THIS PLAT WAS PREPARED BY ME AND IS CORRECT TO THE BEST OF MY KNOWLEDGE AND BELIEF.

REG. SURVEYOR NO. 4785

AS BUILT CERTIFICATION

I HEREBY CERTIFY THAT THE CIRCLED GRADES ARE EXISTING FINISH GRADES CHECKED IN THE FIELD ON _____ AND THAT SURVEY IS CORRECT TO THE BEST OF MY KNOWLEDGE AND BELIEF.

REG. SURVEYOR NO. _____

COLPETZER · WOODS
CONSULTANTS, INC.
180 SOUTH STATE STREET • PAINESVILLE, OHIO 44077 • (216) 357-7569

DATE JAN. '79
SCALE 1" = 20'
DRWN BY
CHKD BY
JOB NO. 78-282
FB 321 PG 72

SITE PLAN FOR:
CASEMENT HOMES
1251 MADISON AVE. PAINESVILLE, OHIO
SUBLOT 17 BOULDER RIDGE SUBD.
PAINESVILLE TWP., LA. CO., OHIO