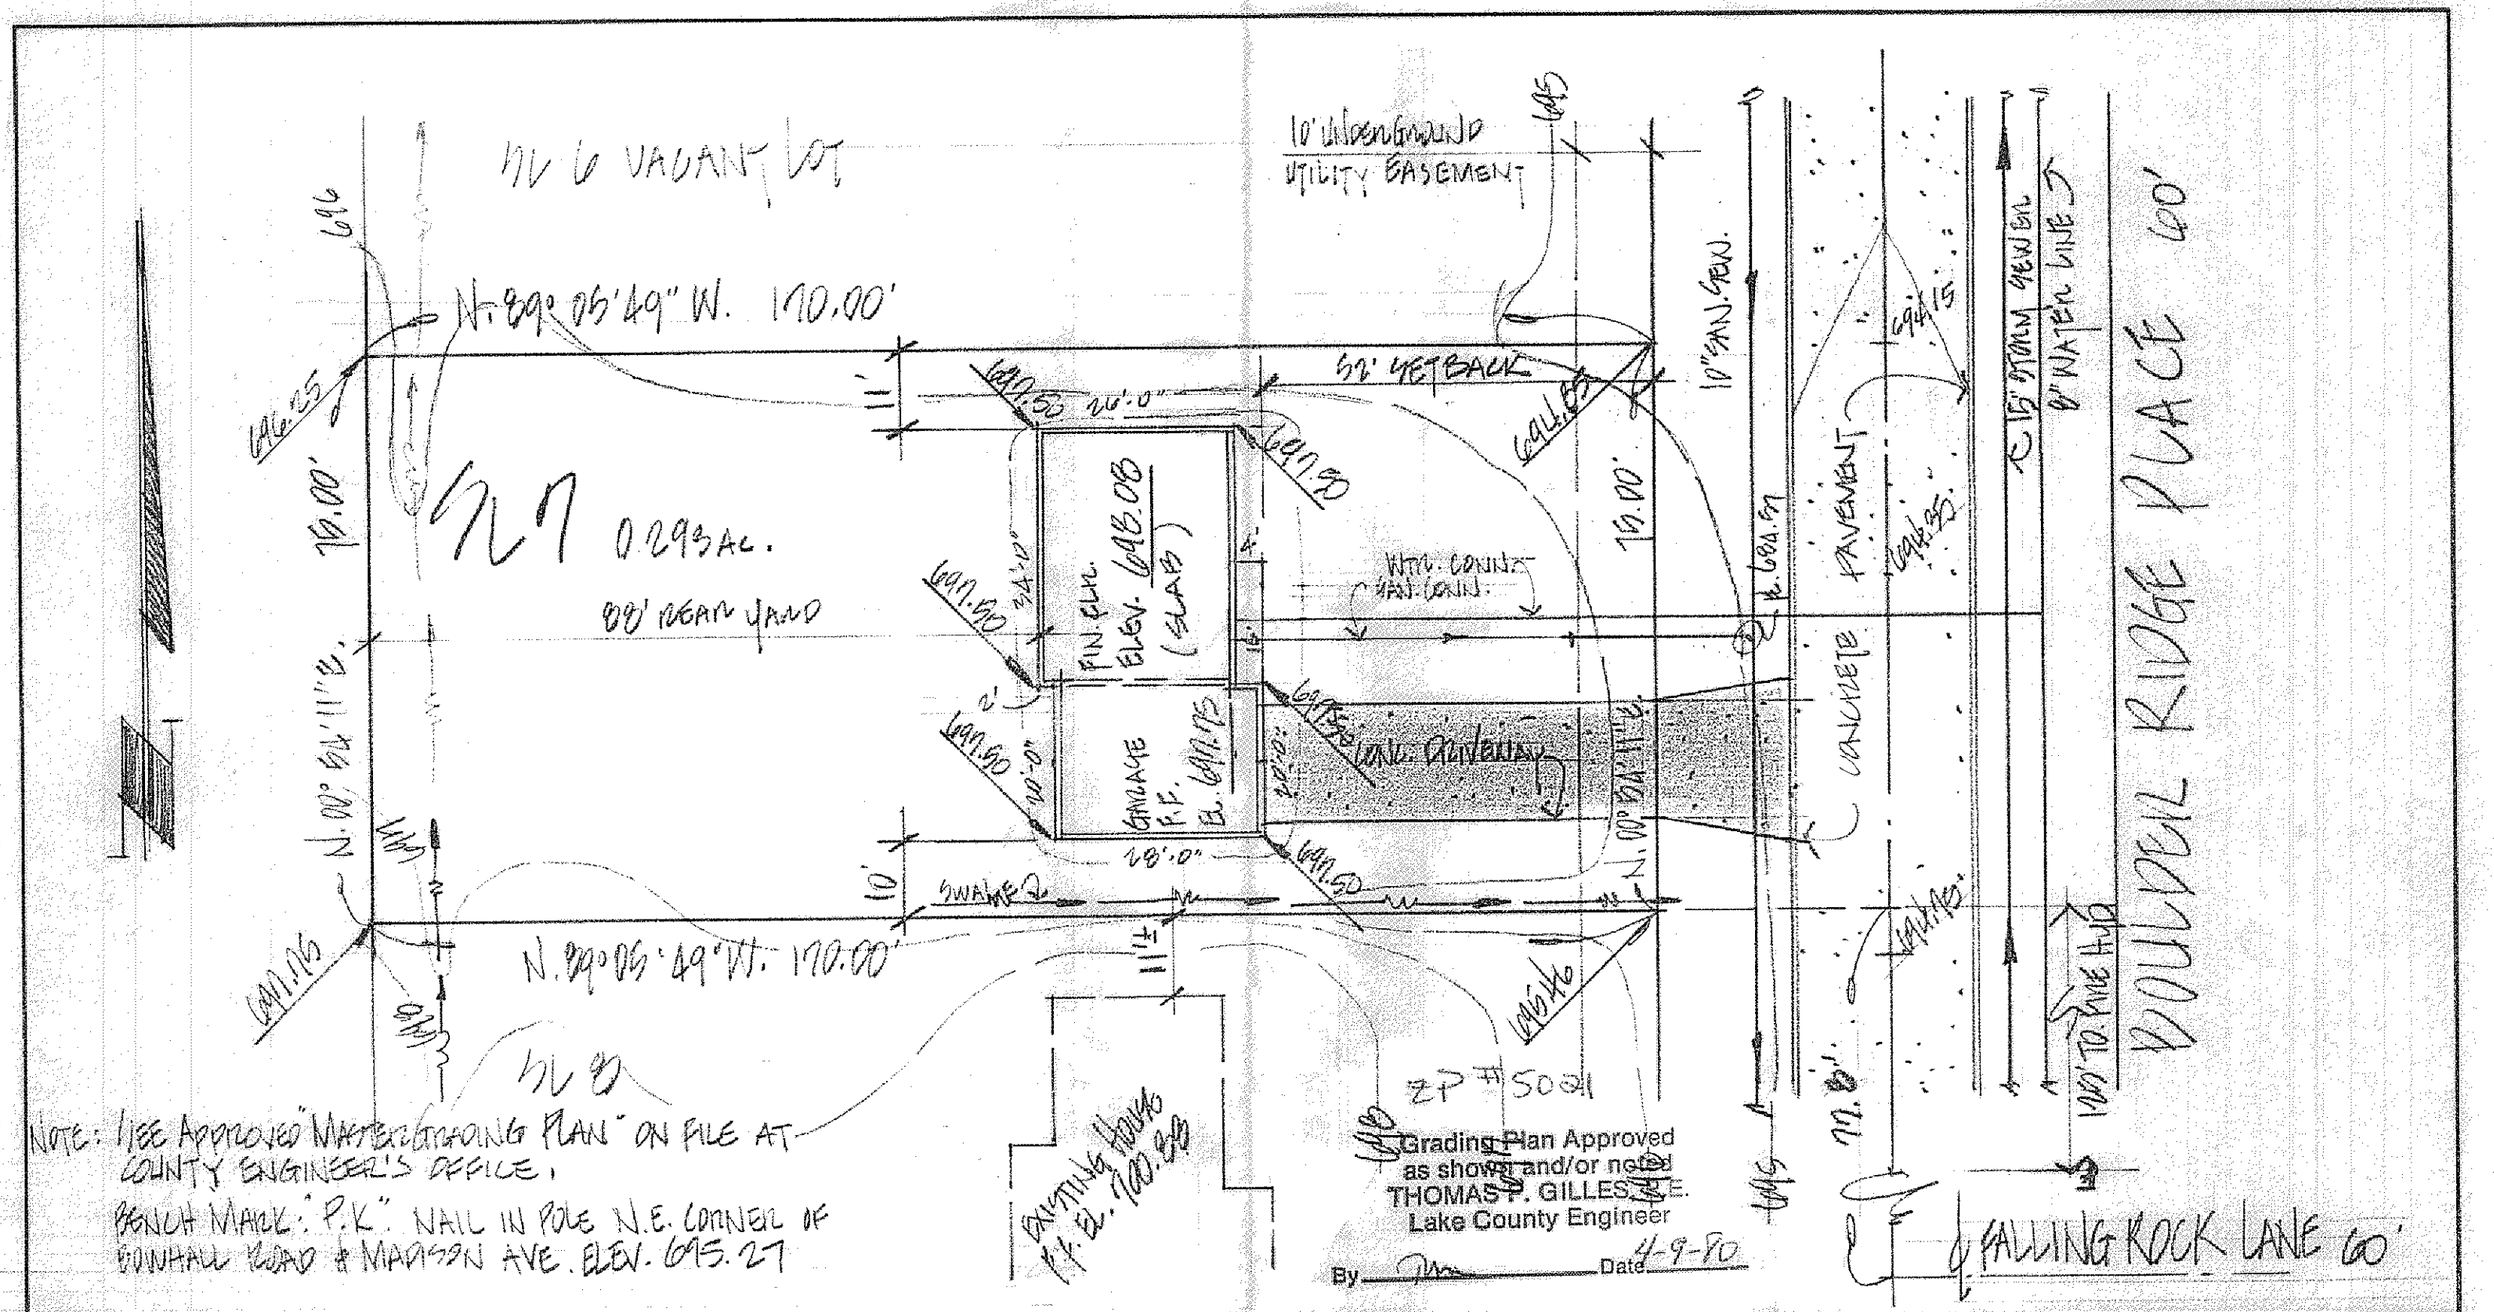

DESIGN CERTIFICATION

THIS PLAT WAS PREPARED BY ME, AND IS CORRECT TO THE BEST OF MY KNOWLEDGE AND BELIEF.

REG. SURVEYOR NO. 4785

AS BUILT CERTIFICATION

I HEREBY CERTIFY THAT THE CIRCLED GRADES ARE EXISTING FINISH GRADES CHECKED IN THE FIELD ON _____ AND THAT SURVEY IS CORRECT TO THE BEST OF MY KNOWLEDGE AND BELIEF.

REG. SURVEYOR NO. _____

COLPETZER · WOODS
CONSULTANTS, INC.
9470 MENTOR AVENUE • MENTOR, OHIO 44066 • (216) 357-7569

DATE FEB. 25, 1980
SCALE 1" = 20'
DRWN BY
CHKD BY
JOB NO. 78282
FB 321 PG 72

SITE PLAN FOR:
CARMENT HOMES
1251 MADISON AVENUE, PAINESVILLE, OH.
BEING SUBLOT 7 IN BOULDER RIDGE SUBDIVISION
PAINESVILLE TWP. OHIO.