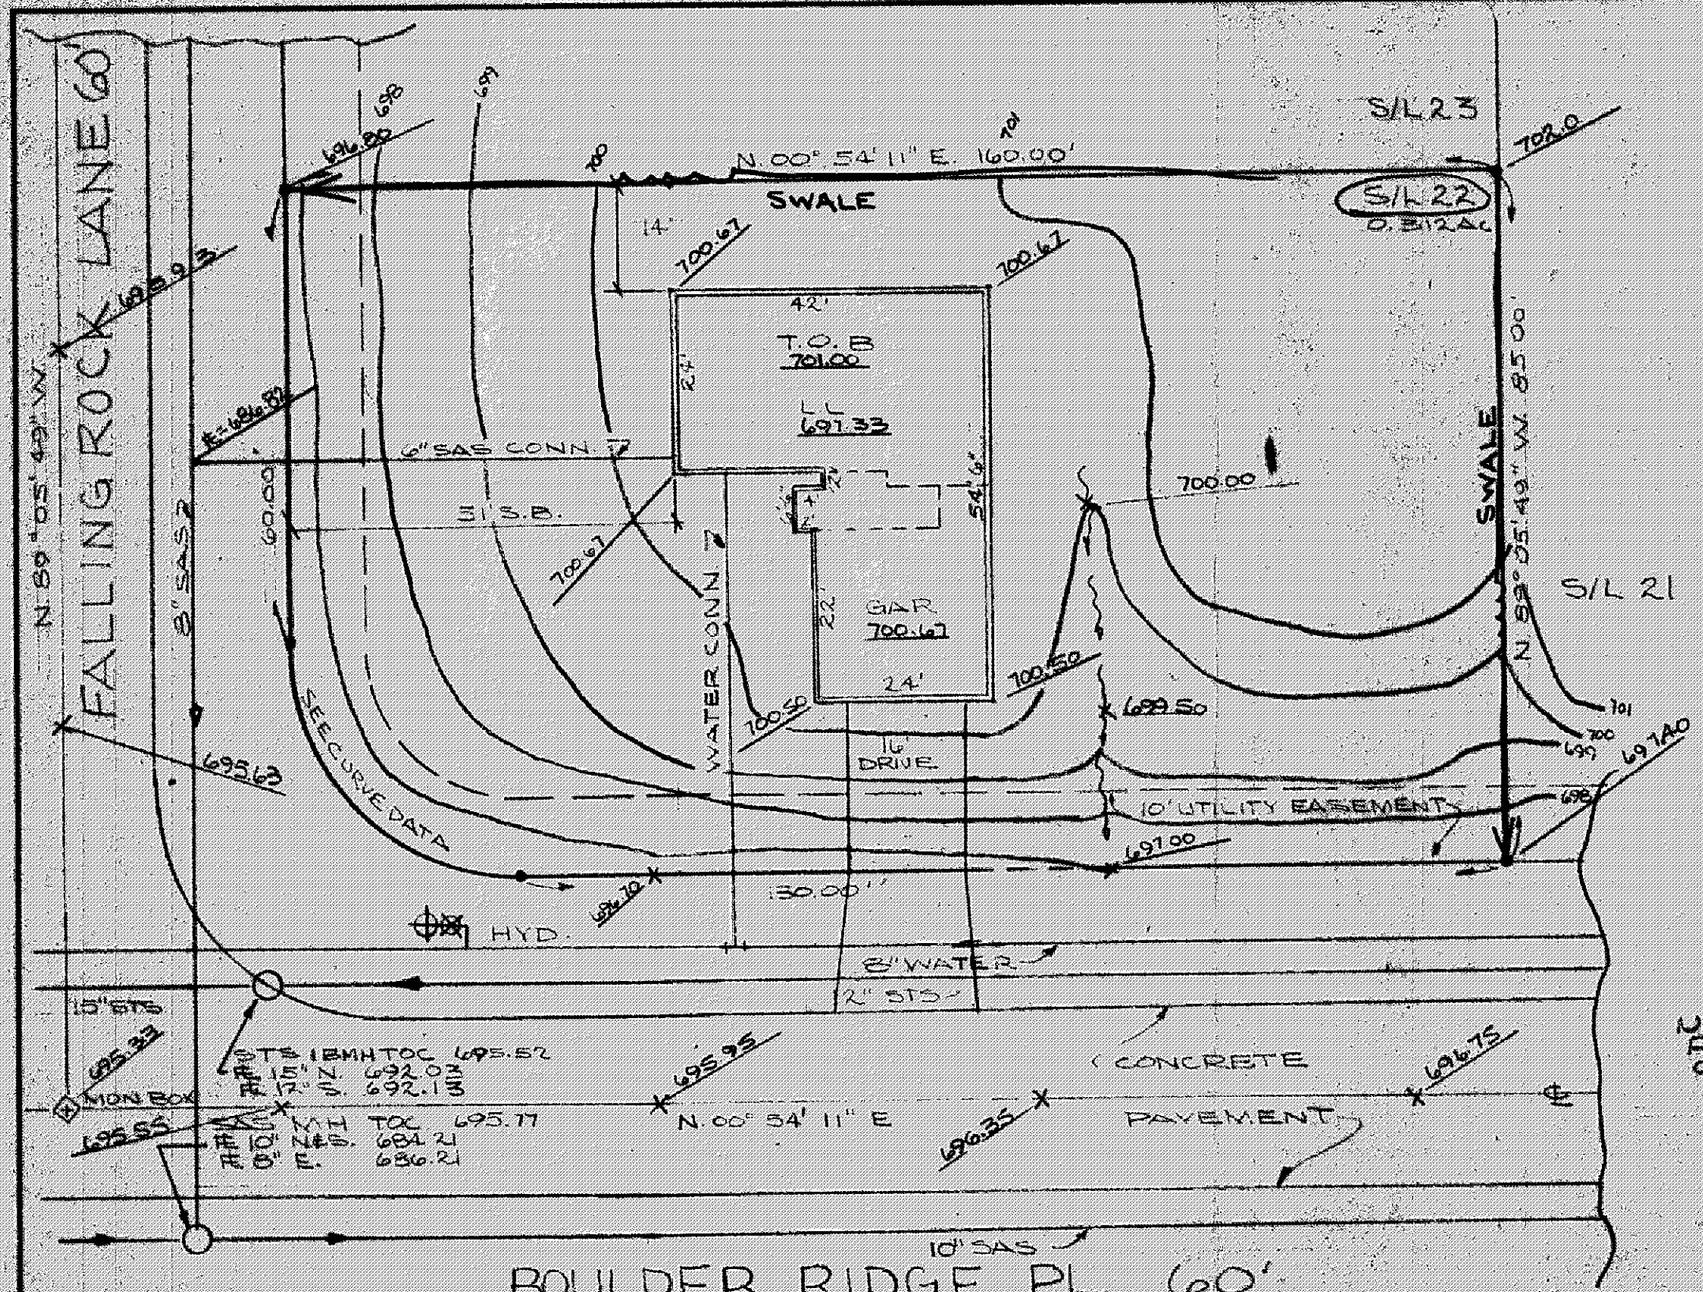

CURVE DATA

R = 30.00'
A = 47.12'
Δ = 90° 00' 00"
T = 30.00'
C = 42.43'
N. 45° 54' 11" E.

PAINESVILLE TOWNSHIP
ZONING O.K.
PENDING DRAINAGE
R. M. Hall
Zoning Inspector

AUG 8 1978
COLPETZER-WOODS
CONSULTANTS, INC.

NOTE: SEE APPROVED GRADING PLAN ON FILE WITH THE COUNTY ENGINEER.

Grading Plan Approved as shown and/or noted
THOMAS P. GILLES, P.E.
Lake County Engineer
By _____ 9-13-78

NOTE:
UNDERLINED ELEVATIONS ARE PROPOSED FINISH GRADES

DESIGN CERTIFICATION
THIS PLAT WAS PREPARED BY ME AND IS CORRECT TO THE BEST OF MY KNOWLEDGE AND BELIEF.
REG. SURVEYOR NO. 9285

AS BUILT CERTIFICATION
I HEREBY CERTIFY THAT THE CIRCLED GRADES ARE EXISTING FINISH GRADES CHECKED IN THE FIELD ON _____ AND THAT SURVEY IS CORRECT TO THE BEST OF MY KNOWLEDGE AND BELIEF.
REG. SURVEYOR NO. _____

COLPETZER · WOODS
CONSULTANTS, INC.
• (216) 357-7569

DATE 17AUG 78
SCALE 1" = 20'
DRWN BY KAL
CHKD BY _____
JOB NO. 78282
PB _____ PG _____

GRADING PLAN FOR:
CASEMENT HOMES
12511 MADISON AVE. PAINESVILLE, OHIO

BEING S/L 22, BOULDER RIDGE SUBDIVISION
PAINESVILLE TWP. LAKE COUNTY, OHIO