SITE PLAN
FOR
OROSZ BLDR's

BEING S/L 97 BLOCK No. 6 PAINESVILLE ON THE LAKE
PAINESVILLE TOWNSHIP, LAKE COUNTY, OHIO.
PP. 11B-0416-0038
Vol 865-994
11B-04168-0038

SCALE: 1" = 20'

N

EXIST PROP

EXIST PROP

Grading Plan Approved
as shown and/or noted
THOMAS P. GILLES, P.E.
Lake County Engineer
By GJH Date 3/3/94

APPROVED
PAINESVILLE TOWNSHIP
ZONING DEPARTMENT
#8698 DIRLOT
3/28/94

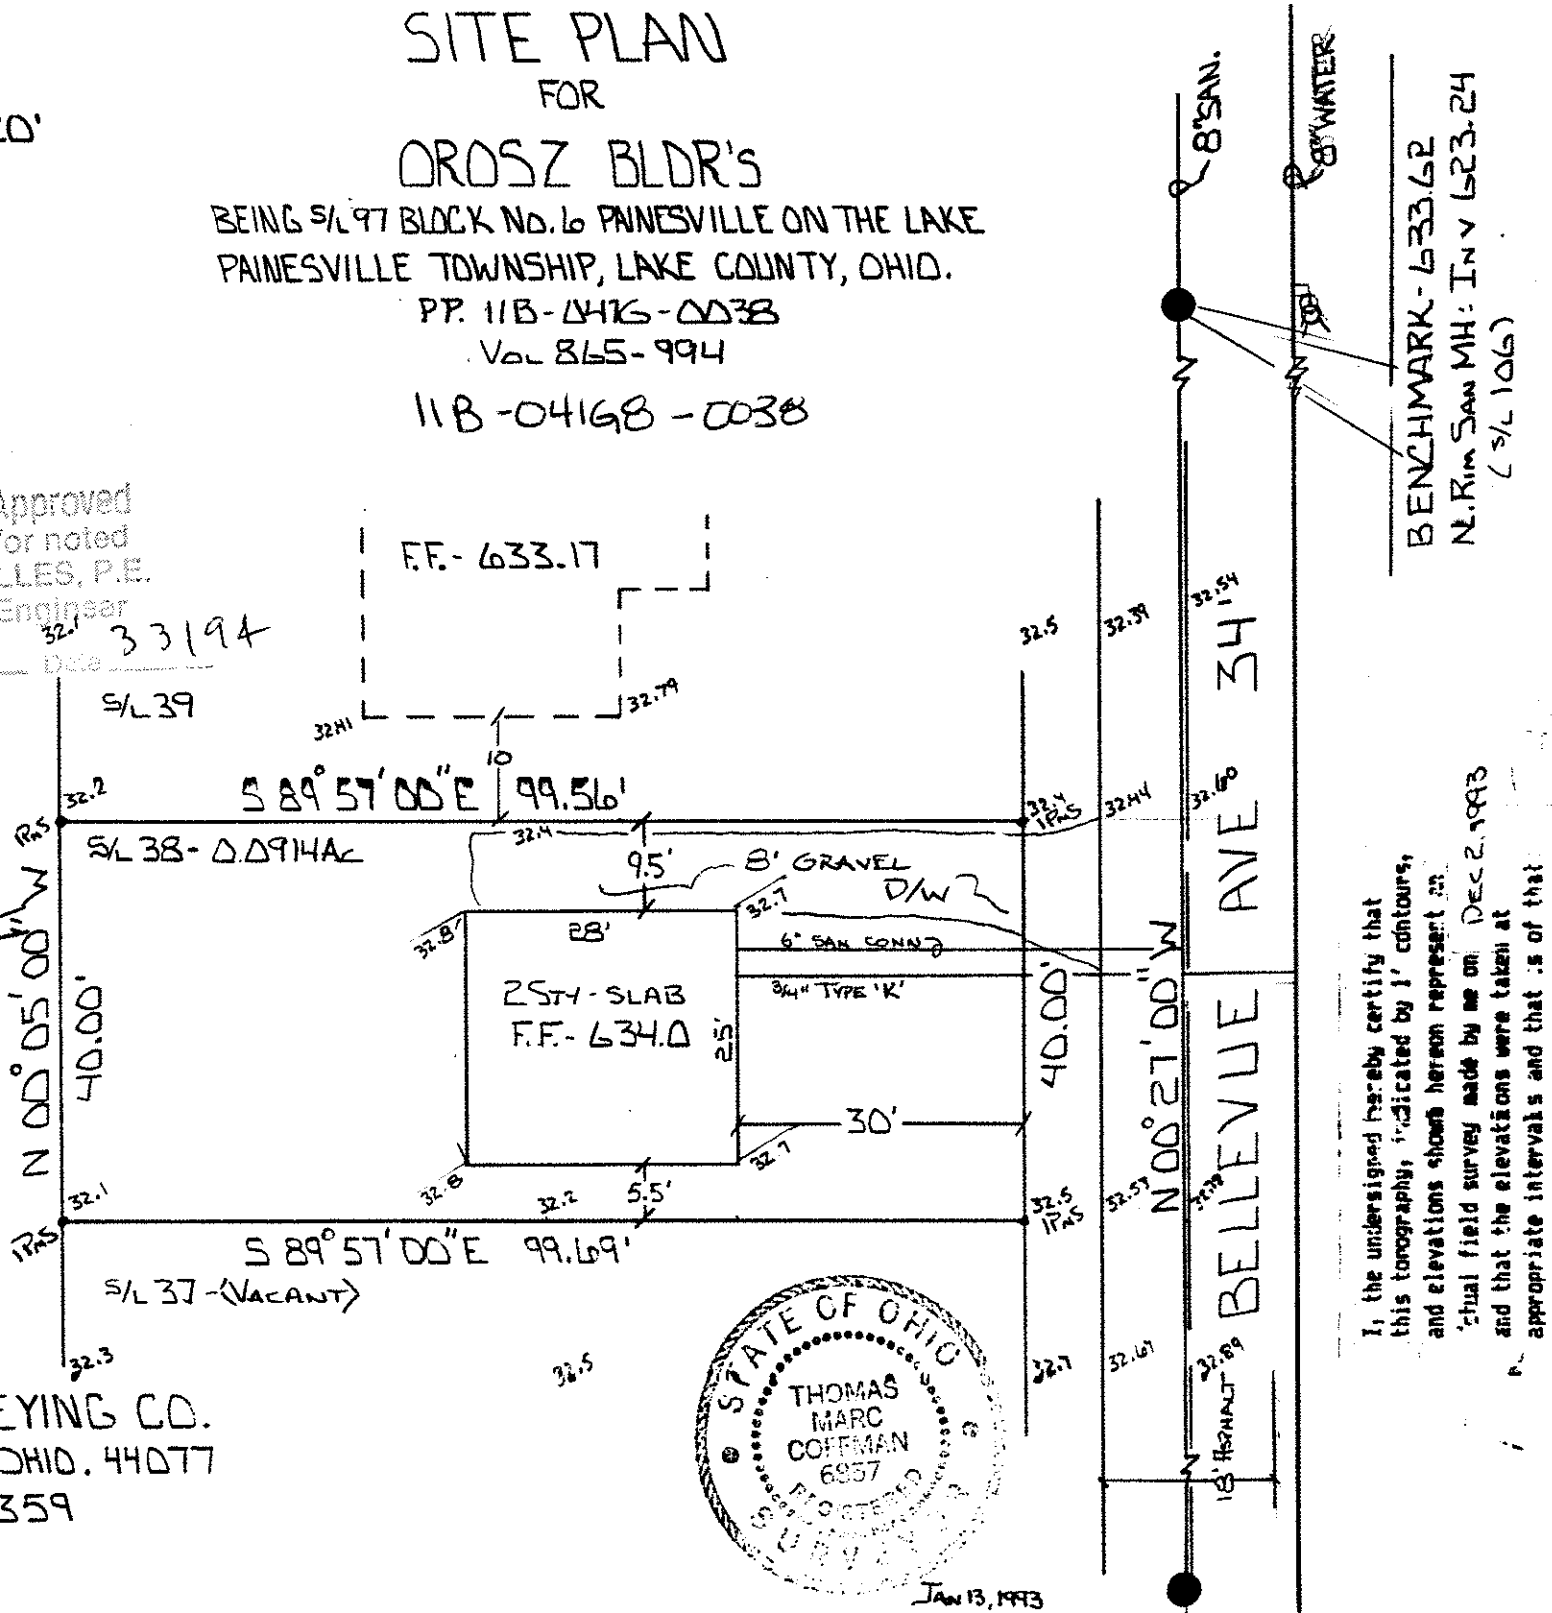

I, the undersigned hereby certify that this topography, indicated by 1' contours, and elevations shown hereon represent an actual field survey made by me on Dec 2, 1993 and that the elevations were taken at appropriate intervals and that is of that date they existed as indicated hereon.

J. M. Coffman PS No 6857

STATE OF OHIO
THOMAS MARC COFFMAN
6857
REGISTERED SURVEYOR

JAN 13, 1993

VILLAGE SURVEYING CO.
FAIRPORT HARBOR, OHIO. 44077
(216) 357-1359