FOR

TOM REED

BEING SUBLOT No. 59 & THE SOUTHERLY 20 FEET OF SUBLOT No. 61, IN THE PAINESVILLE-ON-THE-LAKE SUBDIVISION, IN THE TOWNSHIP OF PAINESVILLE, LAKE COUNTY, OHIO.

SCALE: 1"=20'

N

EXIST. PROP.

EXIST. PROP.

11B-416-7 (55)

Grading Plan Approved as shown and/or noted
THOMAS P. GILLES, P.E.
Lake County Engineer

By TAK Date 4/12/2000

APPROVED PAINESVILLE TOWNSHIP ZONING DEPARTMENT 2000-29 D Rust

swale as shown install yard drain (Example shown)

UNLESS NOTED: ALL LOTS

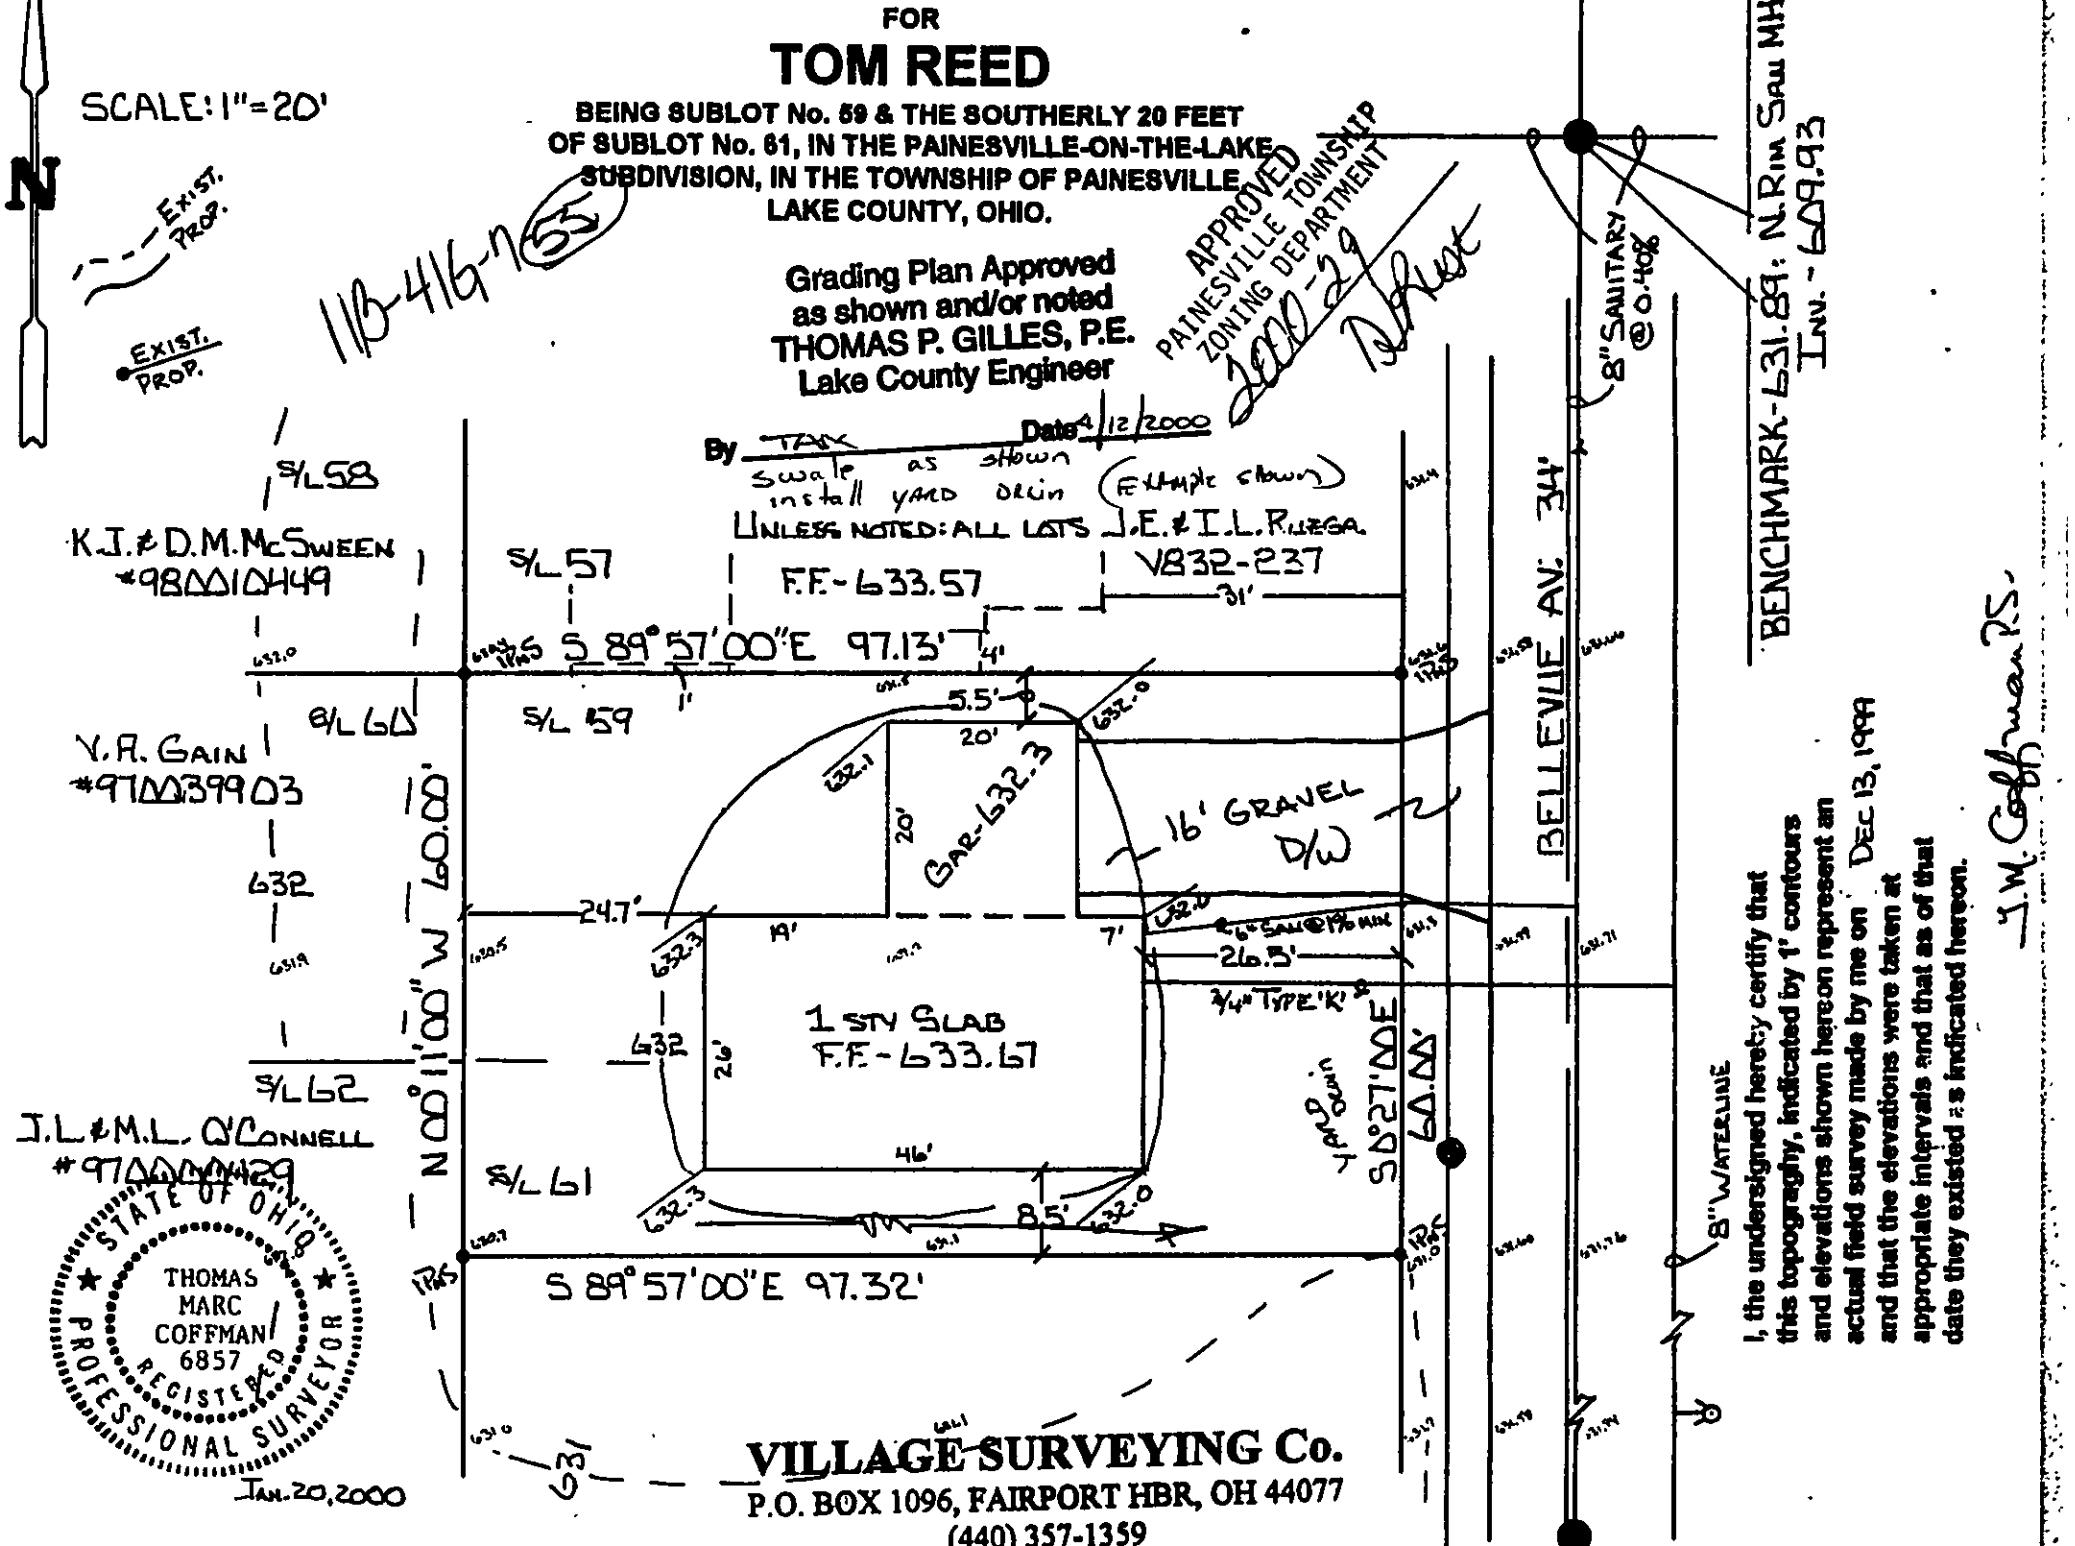

STATE OF OHIO
THOMAS MARC COFFMAN 6857
REGISTERED PROFESSIONAL SURVEYOR

JAN. 20, 2000

I, the undersigned hereby certify that this topography, indicated by 1' contours and elevations shown hereon represent an actual field survey made by me on DEC 13, 1999 and that the elevations were taken at appropriate intervals and that as of that date they existed as indicated hereon.

J.M. Coffman P.S.

VILLAGE SURVEYING Co.
P.O. BOX 1096, FAIRPORT HBR, OH 44077
(440) 357-1359