


Grading Plan Approved
shown and/or noted
THOMAS P. GILLES, P.E.
Lake County Engineer

By Tan Date 6/13/99
Lower FG TO 693.0
Scale as shown

APPROVED
PAINESVILLE TOWNSHIP
ZONING DEPARTMENT
19990257
D. Rust

**ROOF DRAINS
SHALL DISCHARGE
TO SPLASH BLOCKS.**

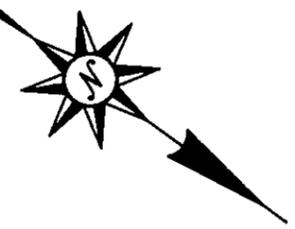

GENERAL NOTES:

1. DRIVEWAY APRON TO BE 6" THICK
2. BENCHMARK - TOP STEM OF FIRE HYDRANT LOCATED IN FRONT OF SUBLOT No. 51, ELEV. = 693.08

LEGEND

- EXISTING CONTOUR
- PROPOSED CONTOUR
- EXISTING ELEVATION
- PROPOSED ELEVATION


CERTIFICATION

"I THE UNDERSIGNED HEREBY CERTIFY THAT THIS TOPOGRAPHY INDICATED BY '1' CONTOURS AND ELEVATIONS SHOWN HEREON REPRESENTS AN ACTUAL SURVEY MADE BY ME ON THE 26TH DAY OF JULY, 1999 AND THE ELEVATIONS WERE TAKEN AT APPROPRIATE INTERVALS AND AS OF THAT DAY THEY EXISTED AS INDICATED HEREON.


"I HEREBY CERTIFY THAT THIS PLAN WAS PREPARED BY ME AND IS CORRECT TO THE BEST OF MY KNOWLEDGE"

DAVID W. NOVAK, P S No 7507

GRAPHIC SCALE

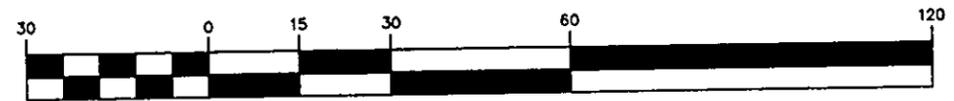

(IN FEET)
1 inch = 30 ft.

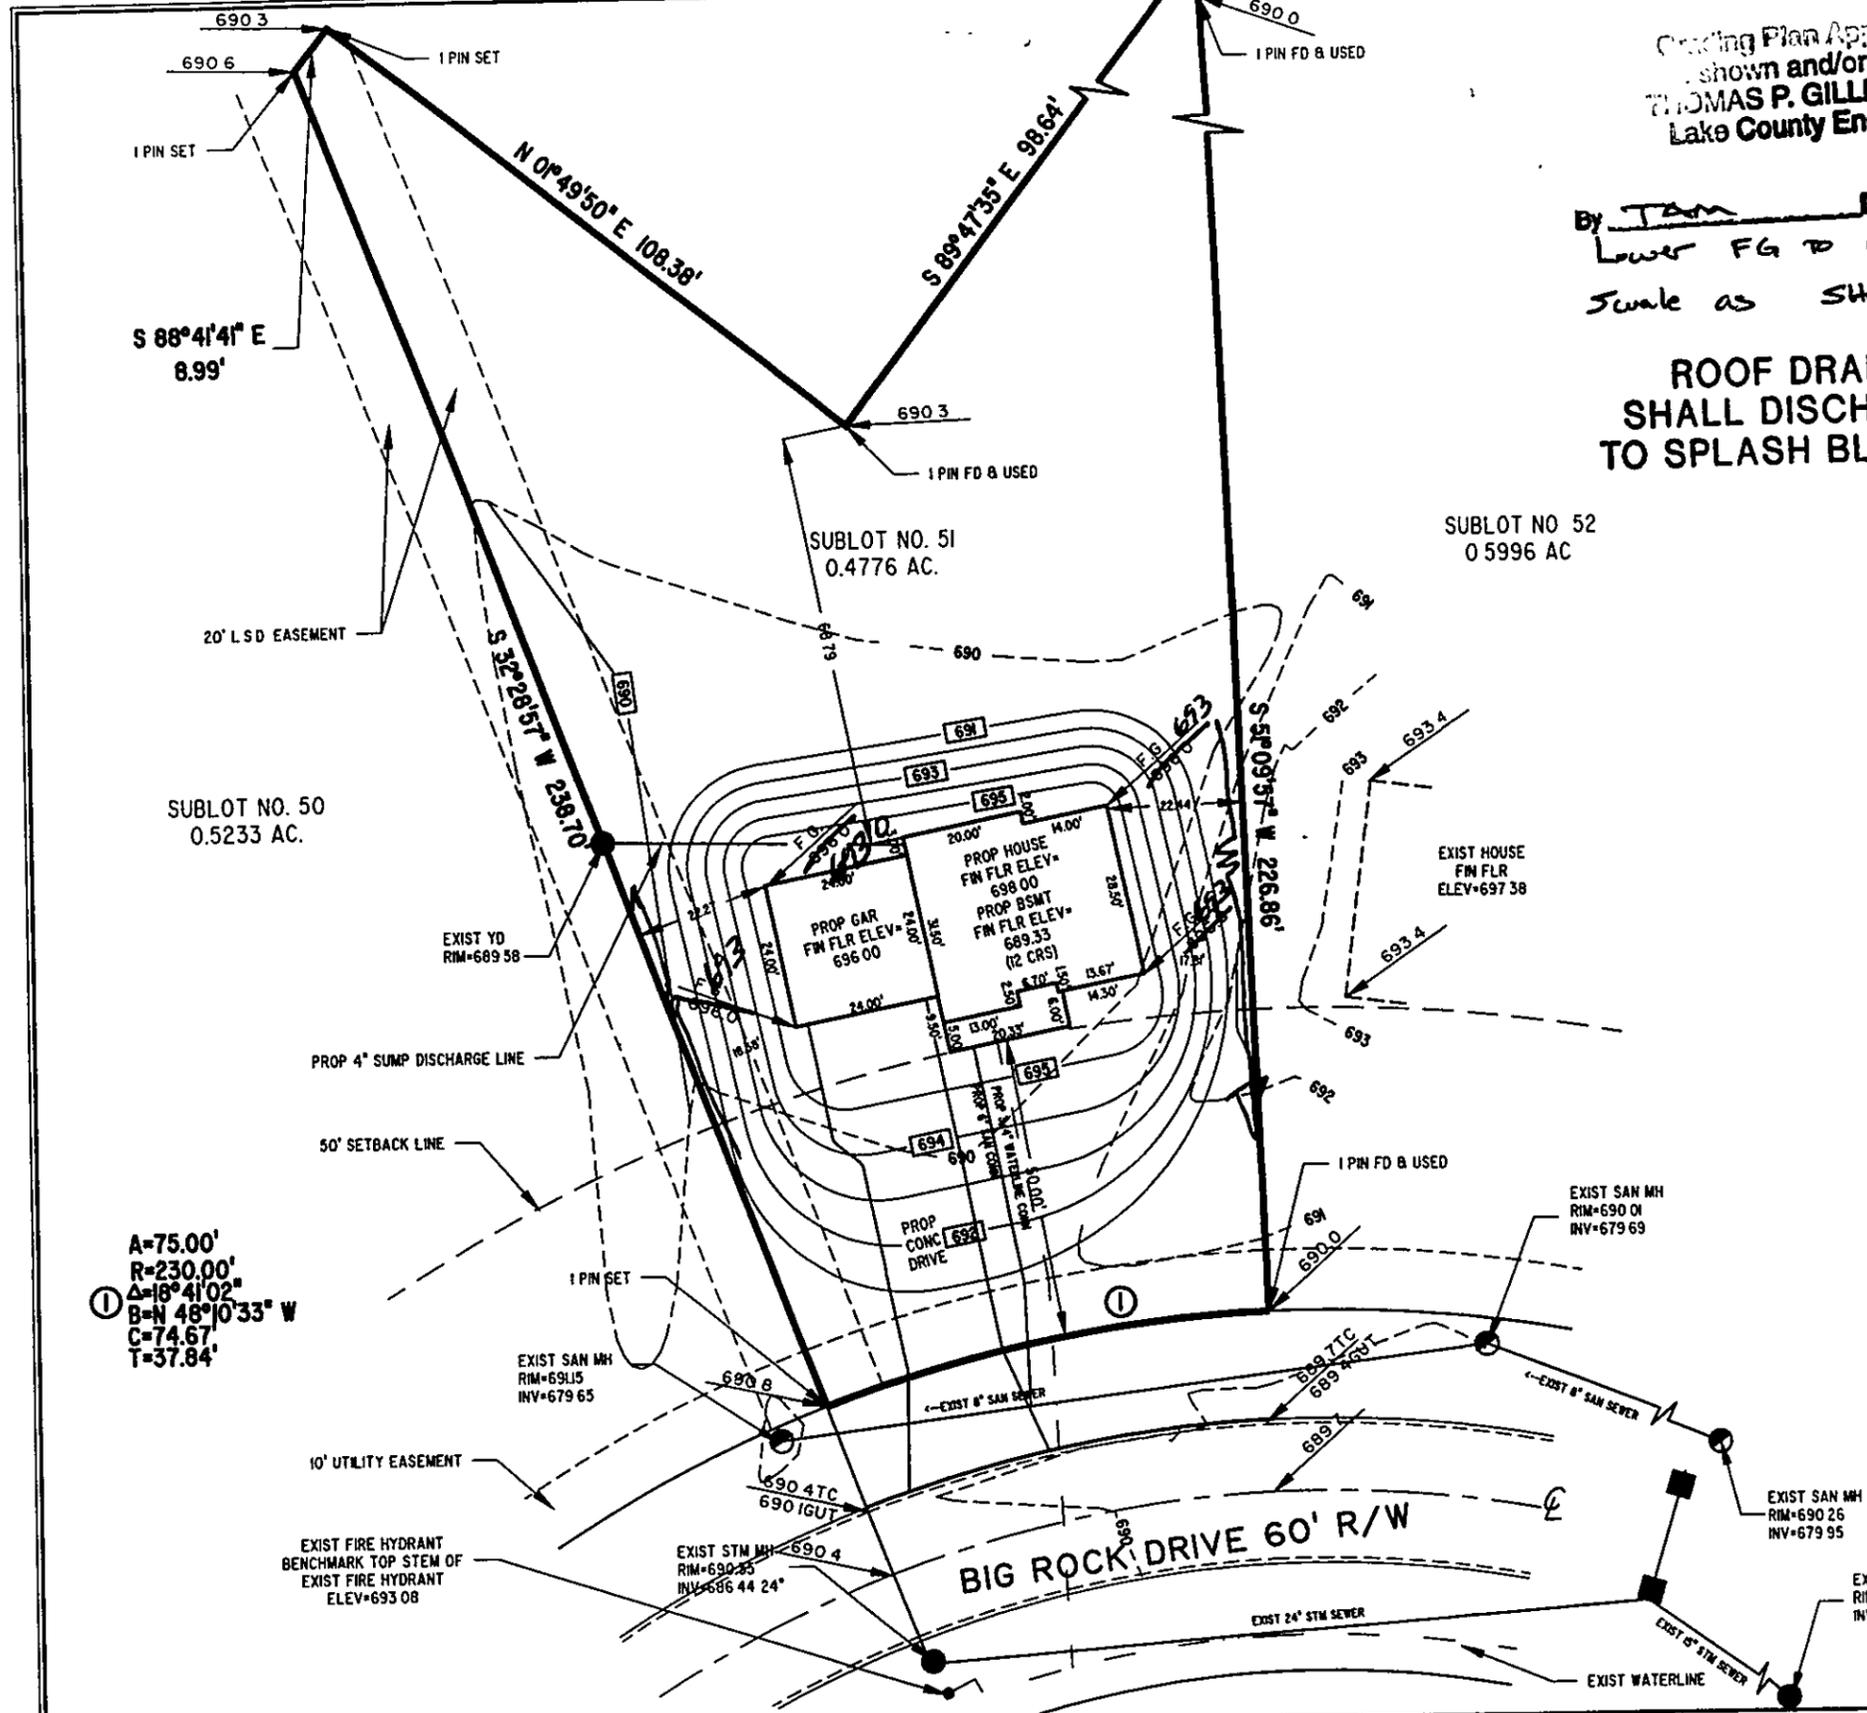

A=75.00'
R=230.00'
Δ=18°41'02"
B=N 48°10'33" W
C=74.67'
T=37.84'

REV No.	DESCRIPTION	DATE	BY	CHK'D.



Himebaugh and Novak
Surveyors and Site Consultants
38342 Western Parkway, Unit 10
Willoughby, Ohio 44094
(440) 946-1761, (440) 918-0486 Fax.

LITTLE MOUNTAIN HOMES INC.
1447 NORTH RIDGE ROAD, PAINESVILLE, OH. 44077

DATE: JULY 27, 1999
DRAWN BY: C.R. KRAFT
CHECKED BY: DWN
APPROVED BY: [Signature]

SITE PLAN
SUBLOT NO. 51 BIG ROCK DRIVE, EASTERN WOODLANDS SUB
PAINESVILLE, OHIO. 44077

SCALES	
HORIZ. 1" = 30'	
VERT. NONE	
CONTRACT No.	99022-51
SHEET No.	OF