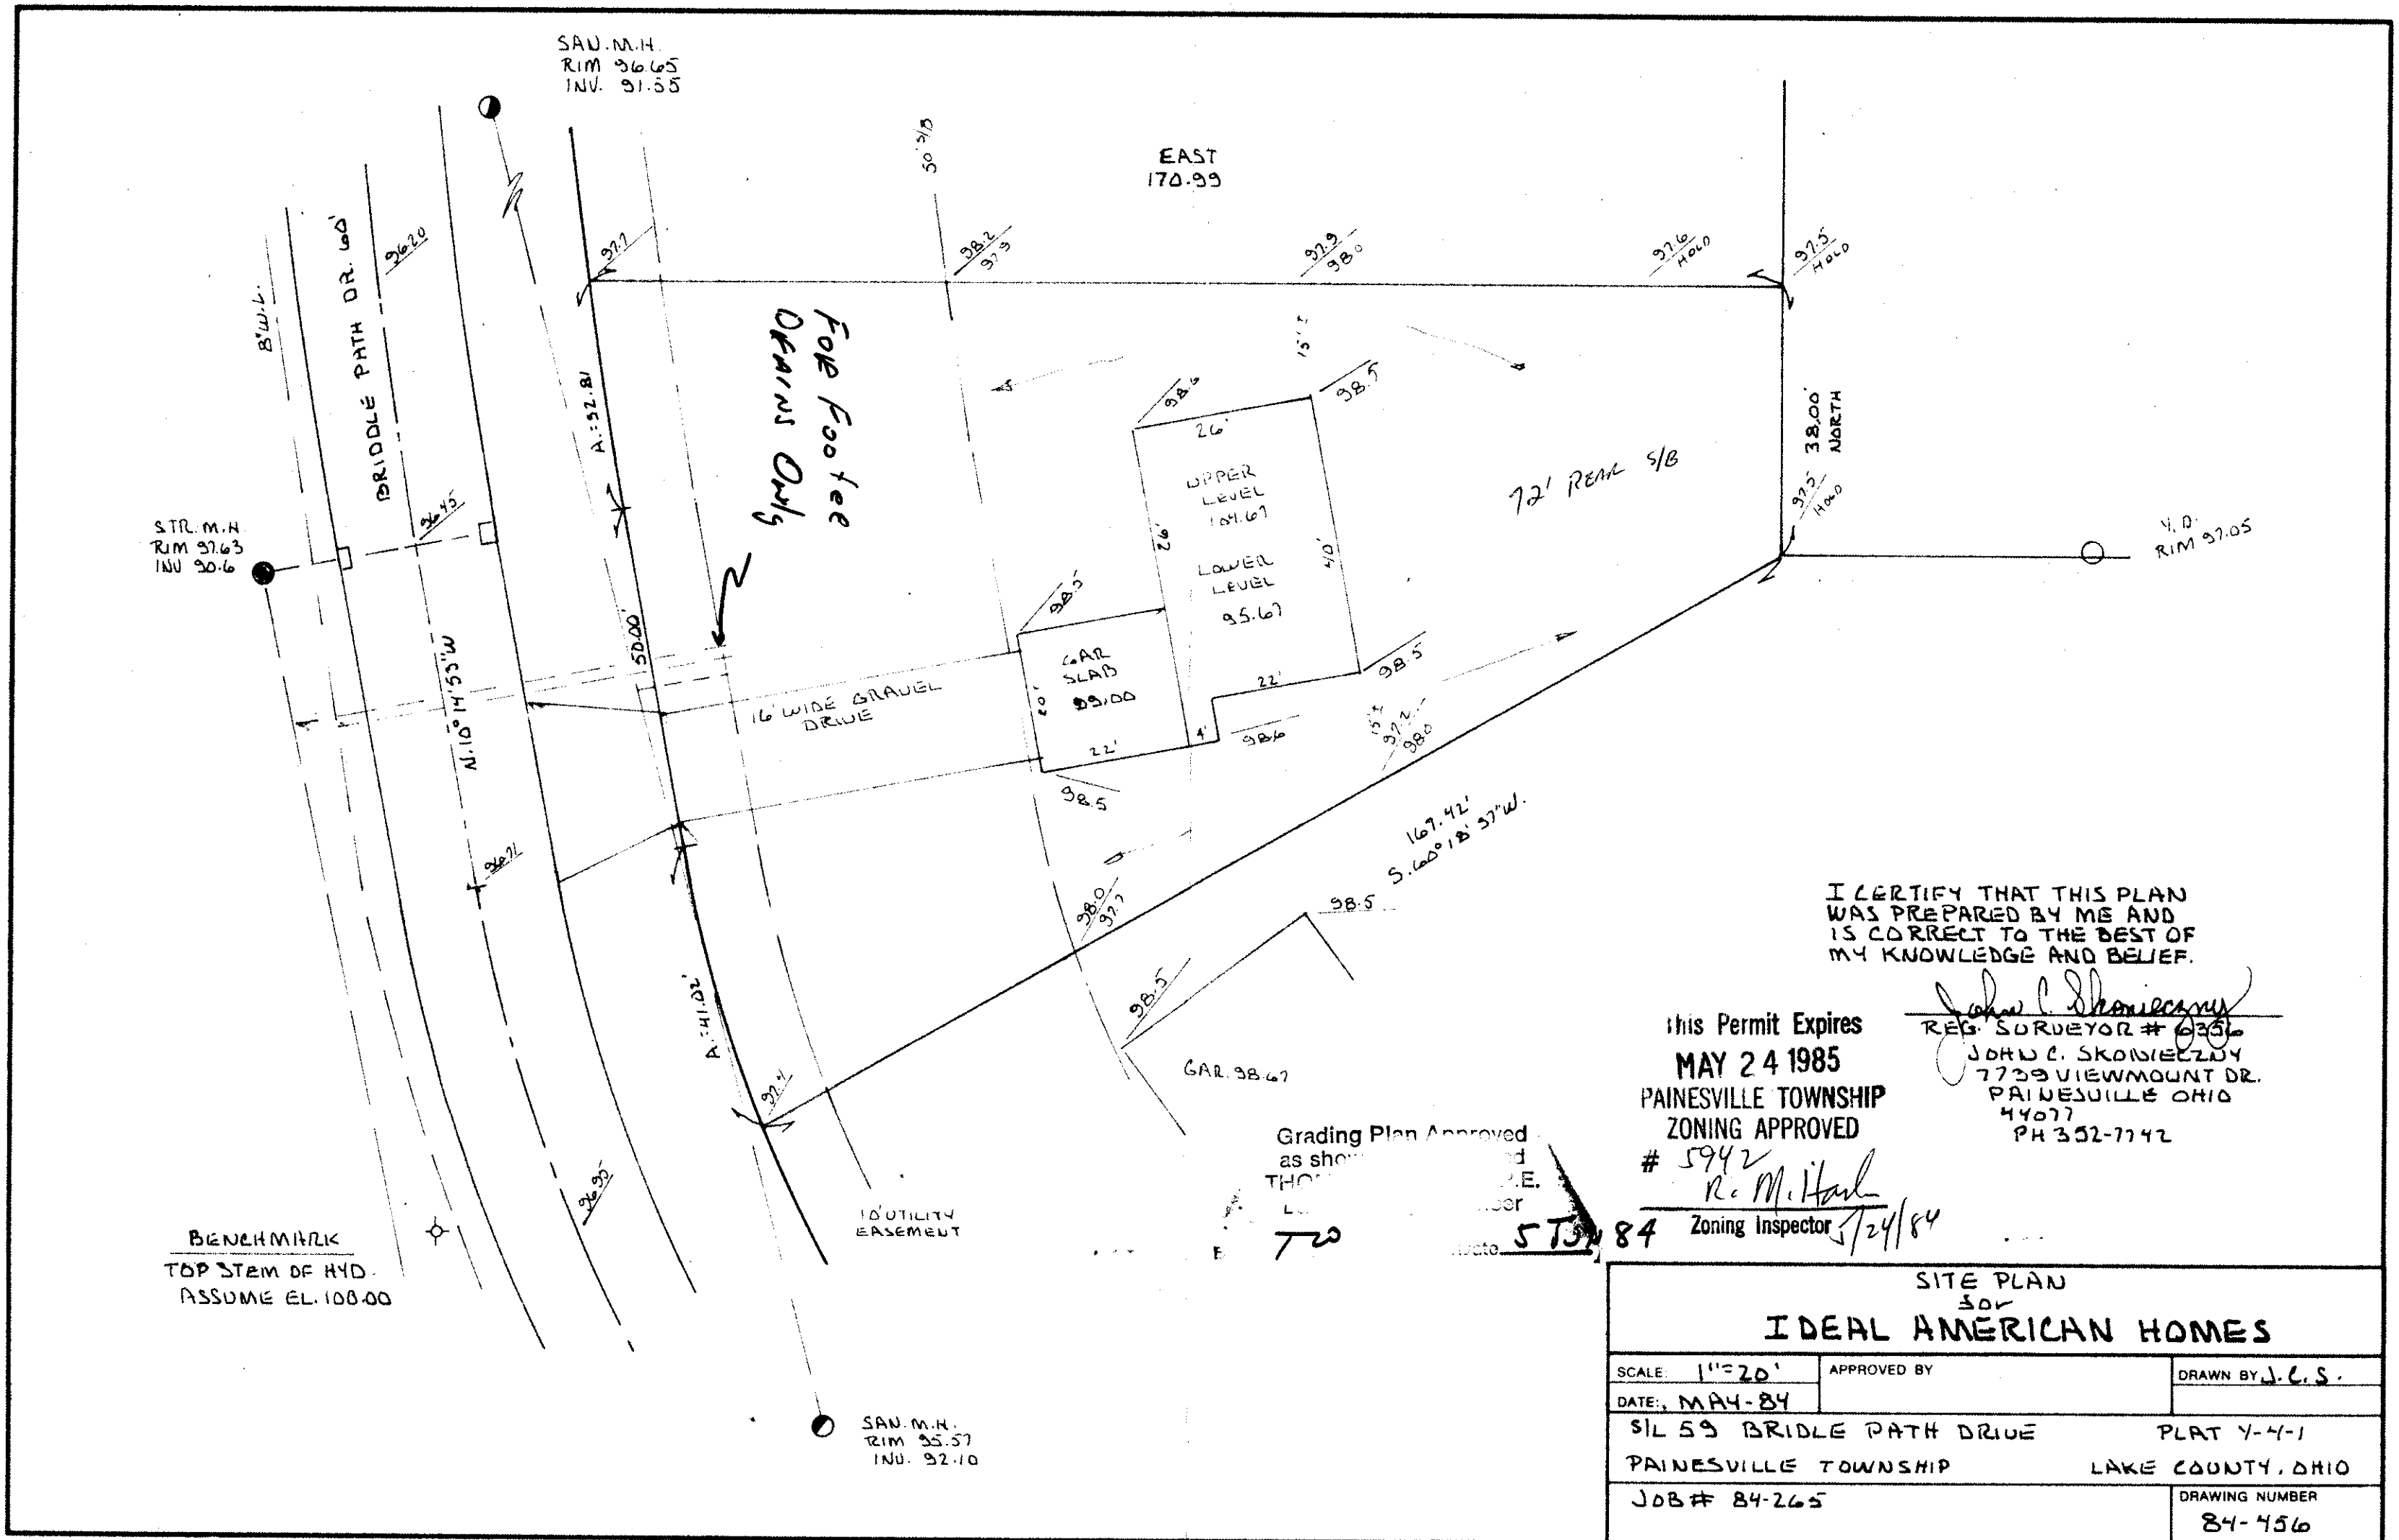

I CERTIFY THAT THIS PLAN WAS PREPARED BY ME AND IS CORRECT TO THE BEST OF MY KNOWLEDGE AND BELIEF.

John C. Skoniecznyj
REG. SURVEYOR # 6356
JOHN C. SKONIECZNY
7739 VIEWMOUNT DR.
PAINESVILLE OHIO
44077
PH 352-7742

This Permit Expires
MAY 24 1985
PAINESVILLE TOWNSHIP
ZONING APPROVED
5942
R. M. Hart
Zoning Inspector 5/24/84

Grading Plan Approved
as sho... ...d
THO... ...P.E.
L... ...ber
T20 ...ate 5 TJ 84

SITE PLAN
for
IDEAL AMERICAN HOMES

SCALE: 1"=20'	APPROVED BY	DRAWN BY J.C.S.
DATE: MAY-84		
S/L 59 BRIDLE PATH DRIVE		PLAT Y-4-1
PAINESVILLE TOWNSHIP		LAKE COUNTY, OHIO
JOB # 84-265		DRAWING NUMBER 84-456

TELEDYNE POST 18AB-10E