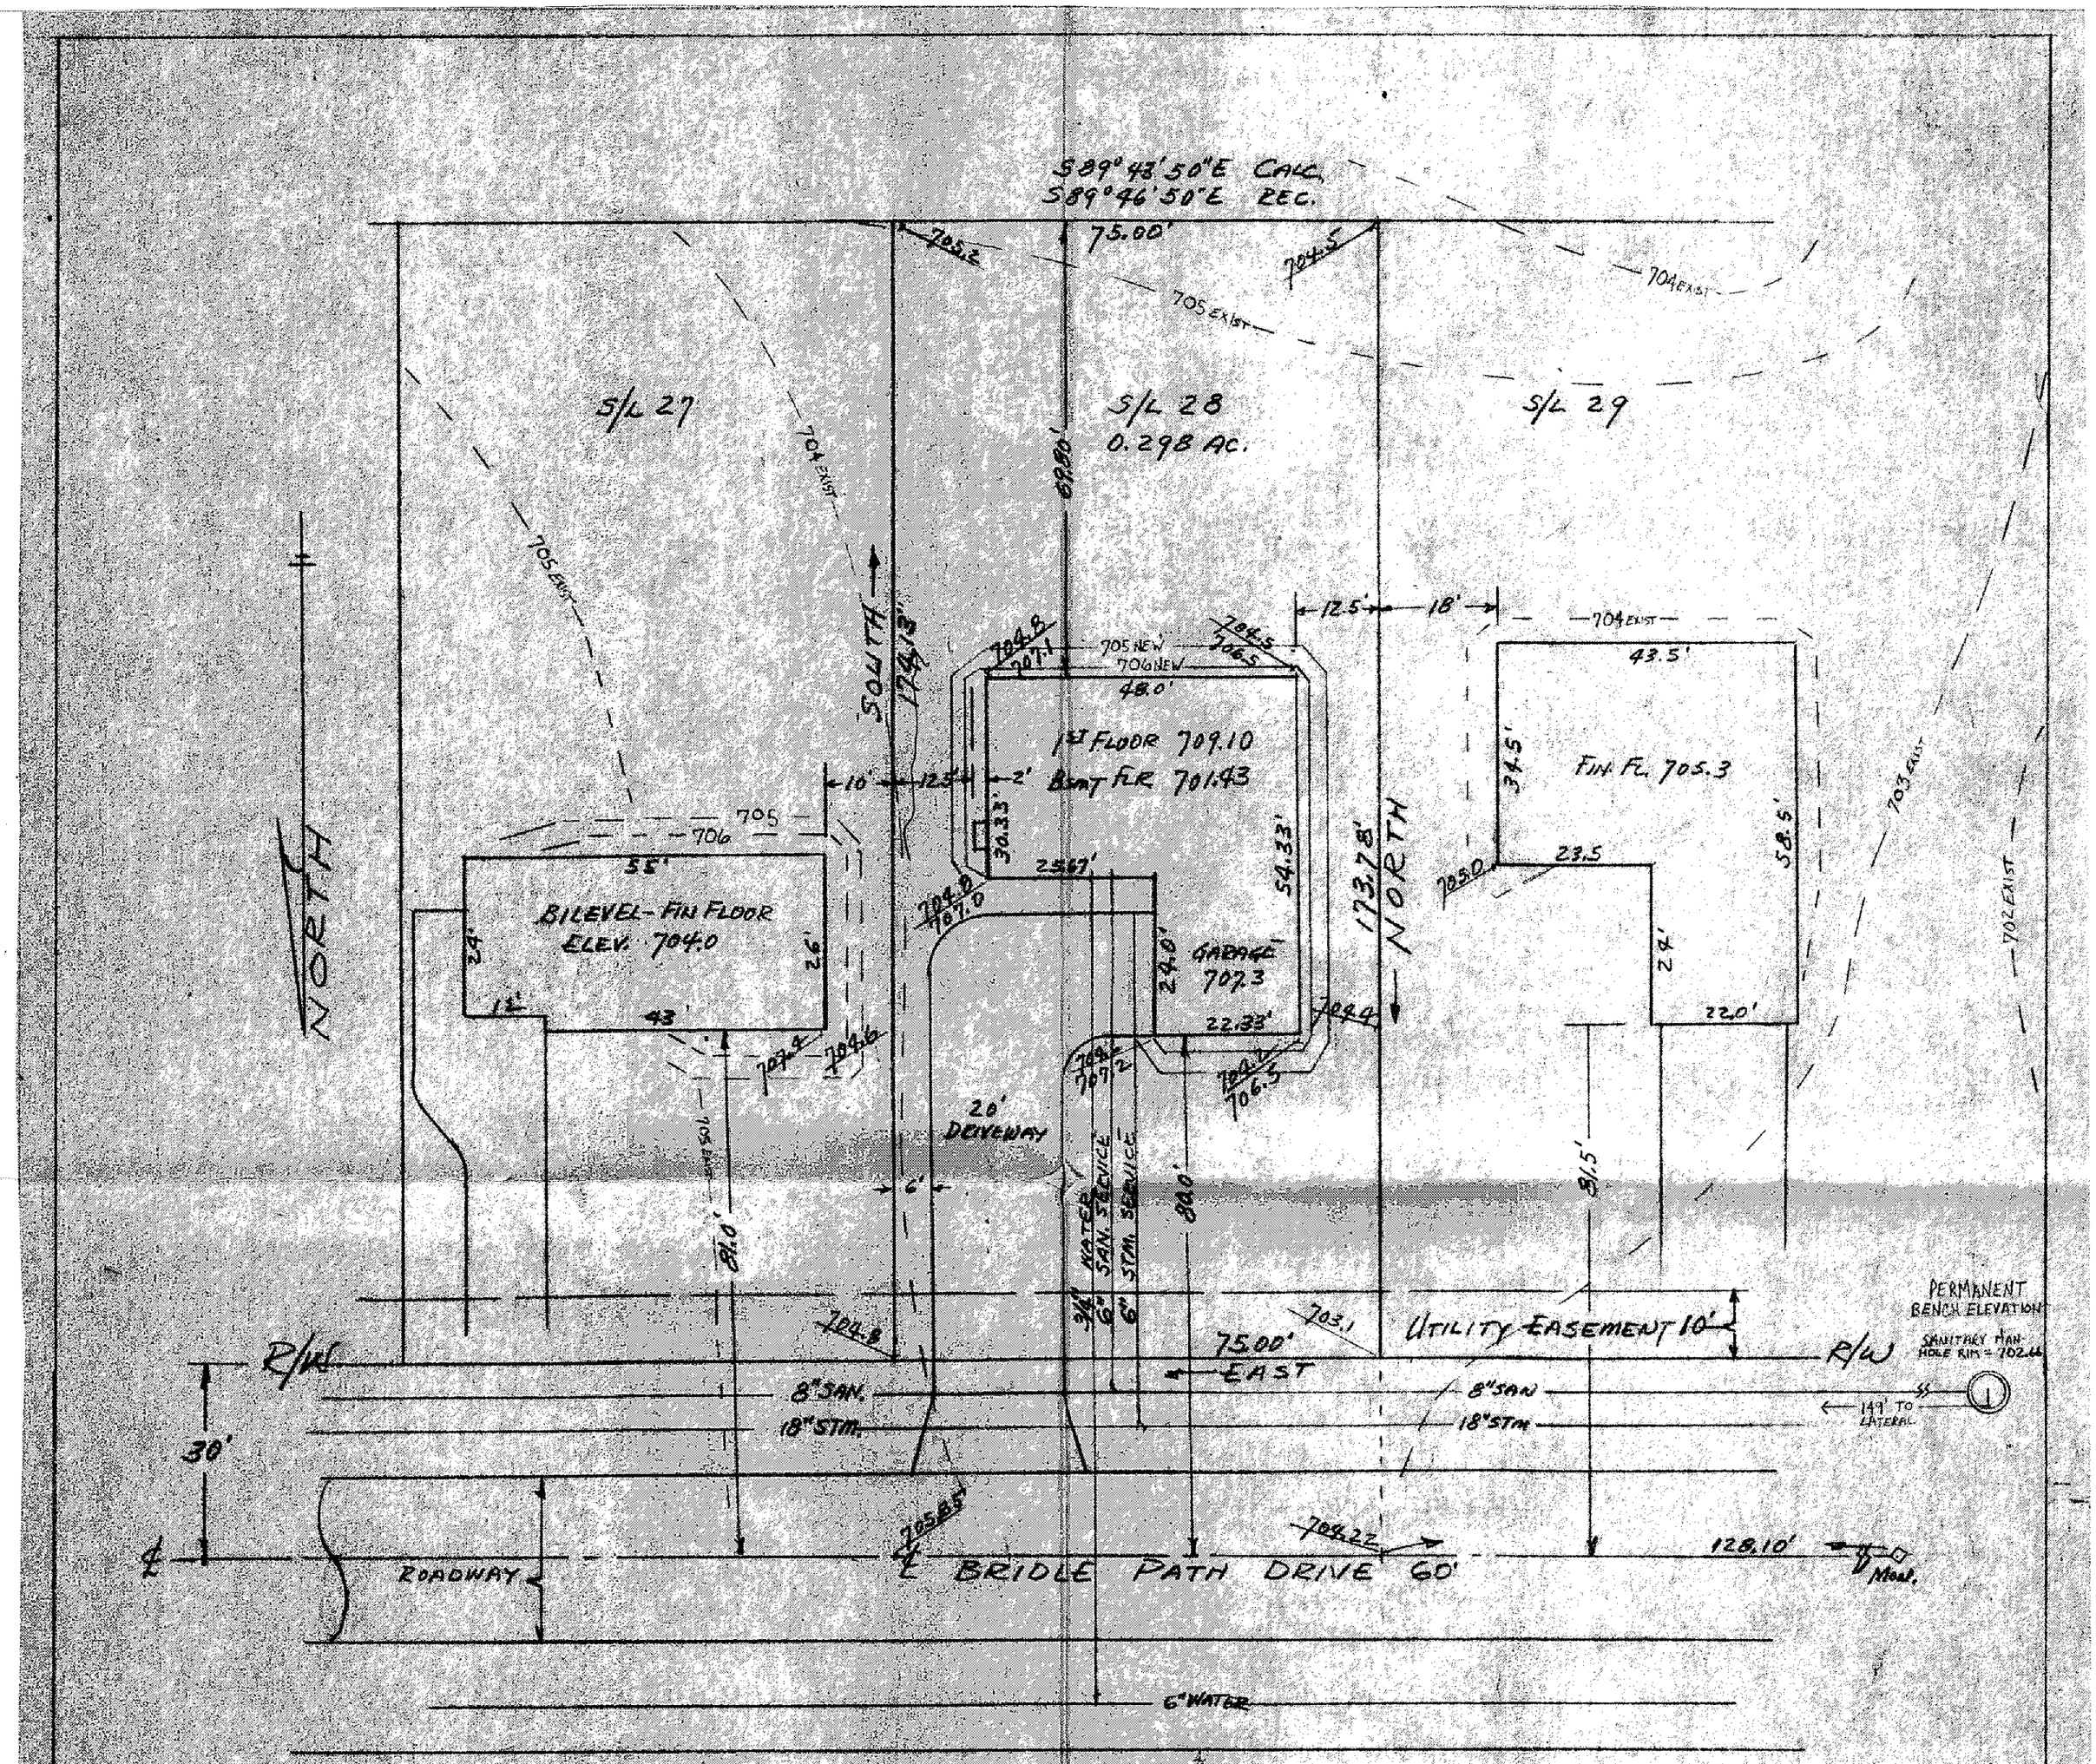

LEGEND:
EXIST. SPOT ELEV. 705.2
FINISH SPOT ELEV. 707.0
PINS FD. OR SET AT ALL CORNERS

TOPOGRAPHIC SURVEY & IMPROVEMENT PLAN
FOR THOMAS & REBECCA PECK
BEING SUBLOT 28 IN THE SIERRA SUBDIVISION OF
PART OF ORIGINAL PAINESVILLE TOWNSHIP LOT 30, TRACT 1
TOWNSHIP OF PAINESVILLE, COUNTY OF LAKE & STATE OF OHIO
SCALE 1" = 20'

ZONING PERMIT 7292

JUNE 12, 1989

Grading Plan Approved
as shown and/or noted
THOMAS P. GILLES, P.E.
Lake County Engineer
By GJH Date 7/27/89

1. FLOW LINES AS SHOWN.

Pat Salango
PAT SALANGO, REG SURV. No. 4504
6051 CATALANO DRIVE
MAYFIELD HTS. OHIO 44124

STATE OF OHIO
PAT SALANGO
4504
REGISTERED
SURVEYOR