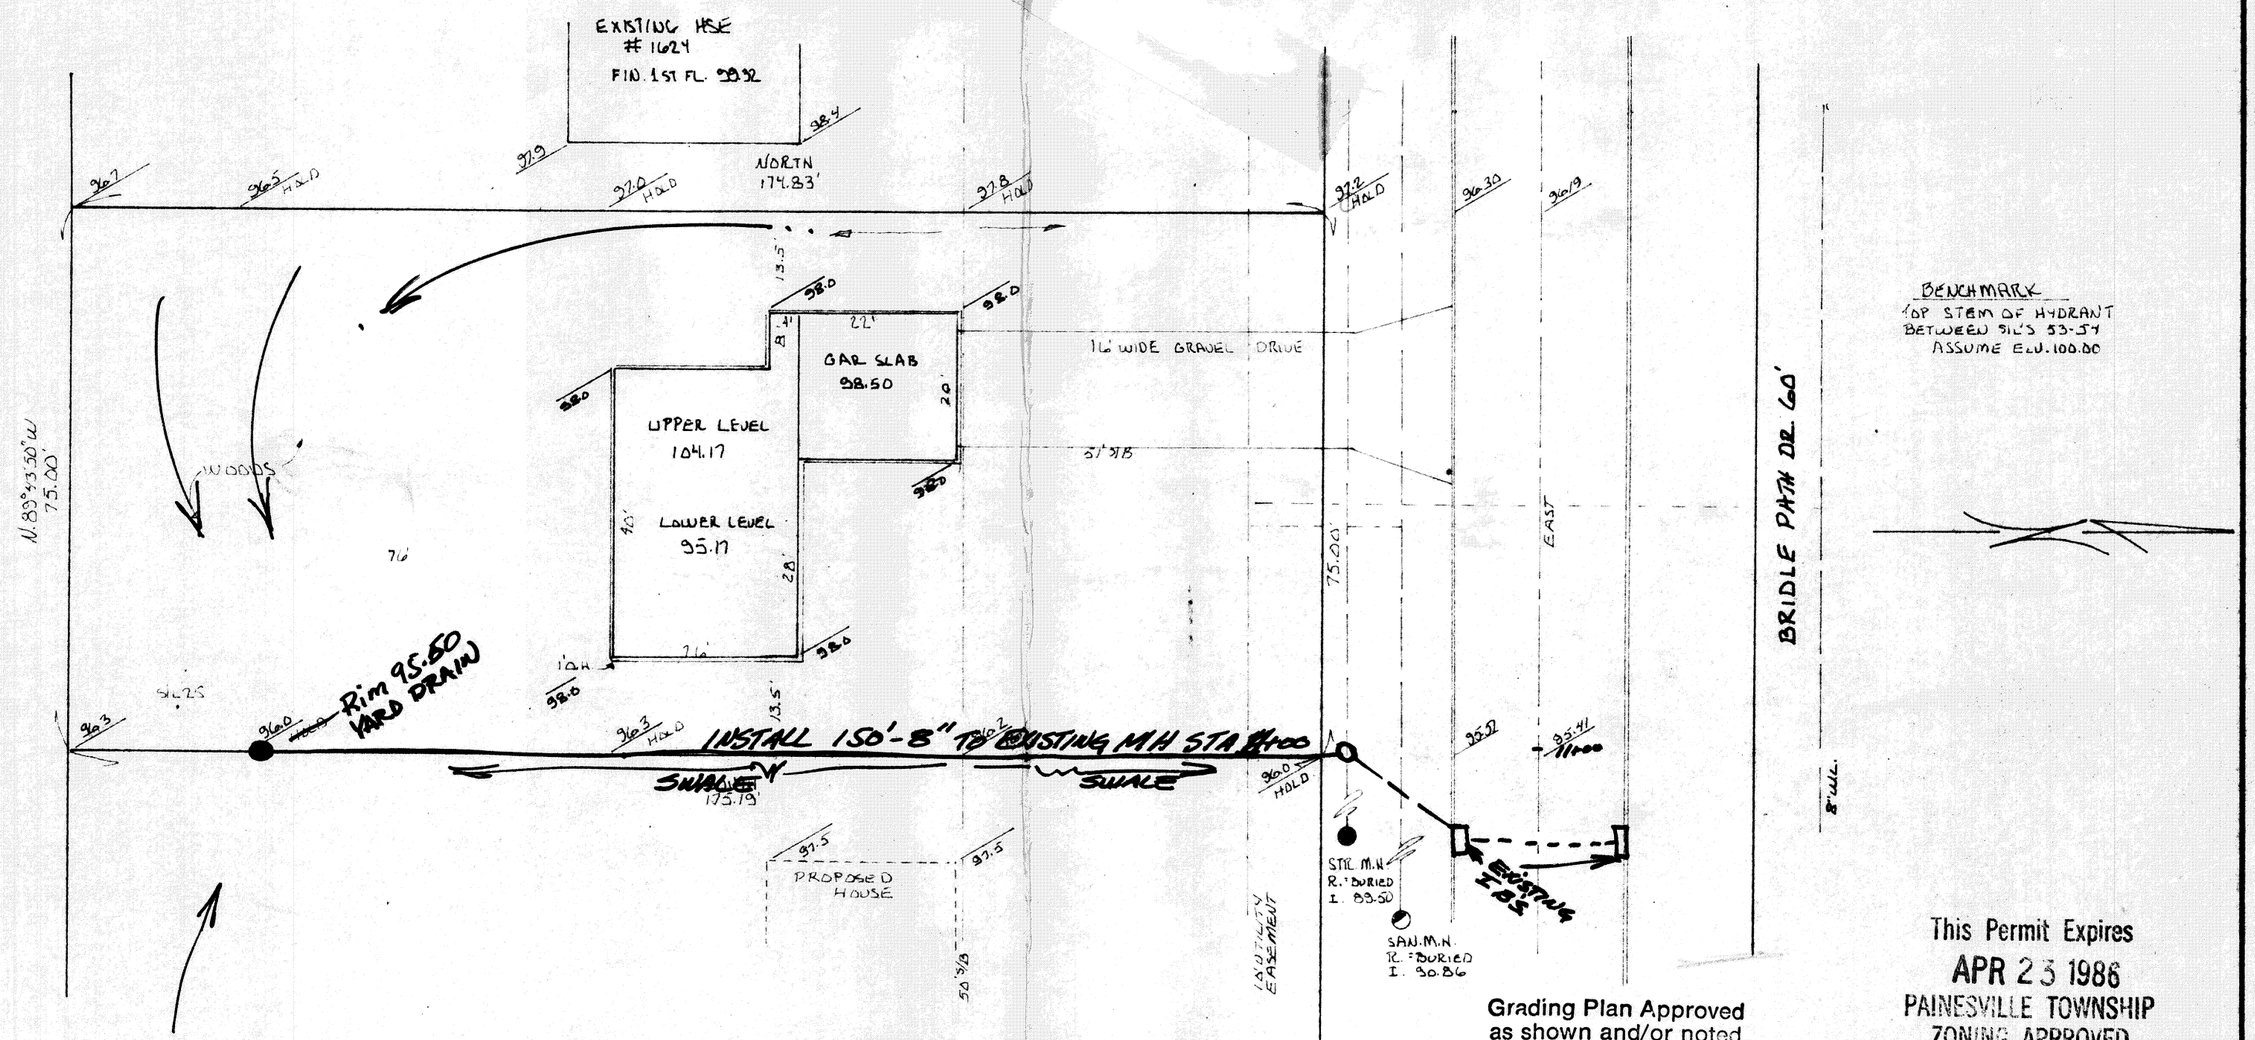

Grading Plan Approved
as shown and/or noted
THOMAS P. GILLES, P.E.
Lake County Engineer
By DMP Date 4-30-85

This Permit Expires
APR 23 1986
PAINESVILLE TOWNSHIP
ZONING APPROVED
6162
R. M. Hall
Zoning Inspector 4/24/85

I CERTIFY THAT THIS PLAN
WAS PREPARED BY ME AND
IS CORRECT TO THE BEST OF
MY KNOWLEDGE AND BELIEF

John C. Skonieczny
REG. SURVEYOR #6356

JOHN C. SKONIECZNY
7739 VIEWMOUNT DR
PAINESVILLE OHIO
44077
PH 352-7742

PROPOSED / EXISTING GRADES
SWALE

SITE PLAN
FOR
IDEAL AMERICAN HOMES

SCALE: 1" = 20'	APPROVED BY	DRAWN BY J.C.S.
DATE: APR-85		PLAT Y-4-1

BEING S/L 25 BRIDLE PATH DRIVE
ADDRESS: 1630 BRIDLE PATH
PAINESVILLE TOWNSHIP LAKE COUNTY, OHIO

JOB# 85-374

DRAWING NUMBER
85-503

TELEDYNE POST 18AB-10