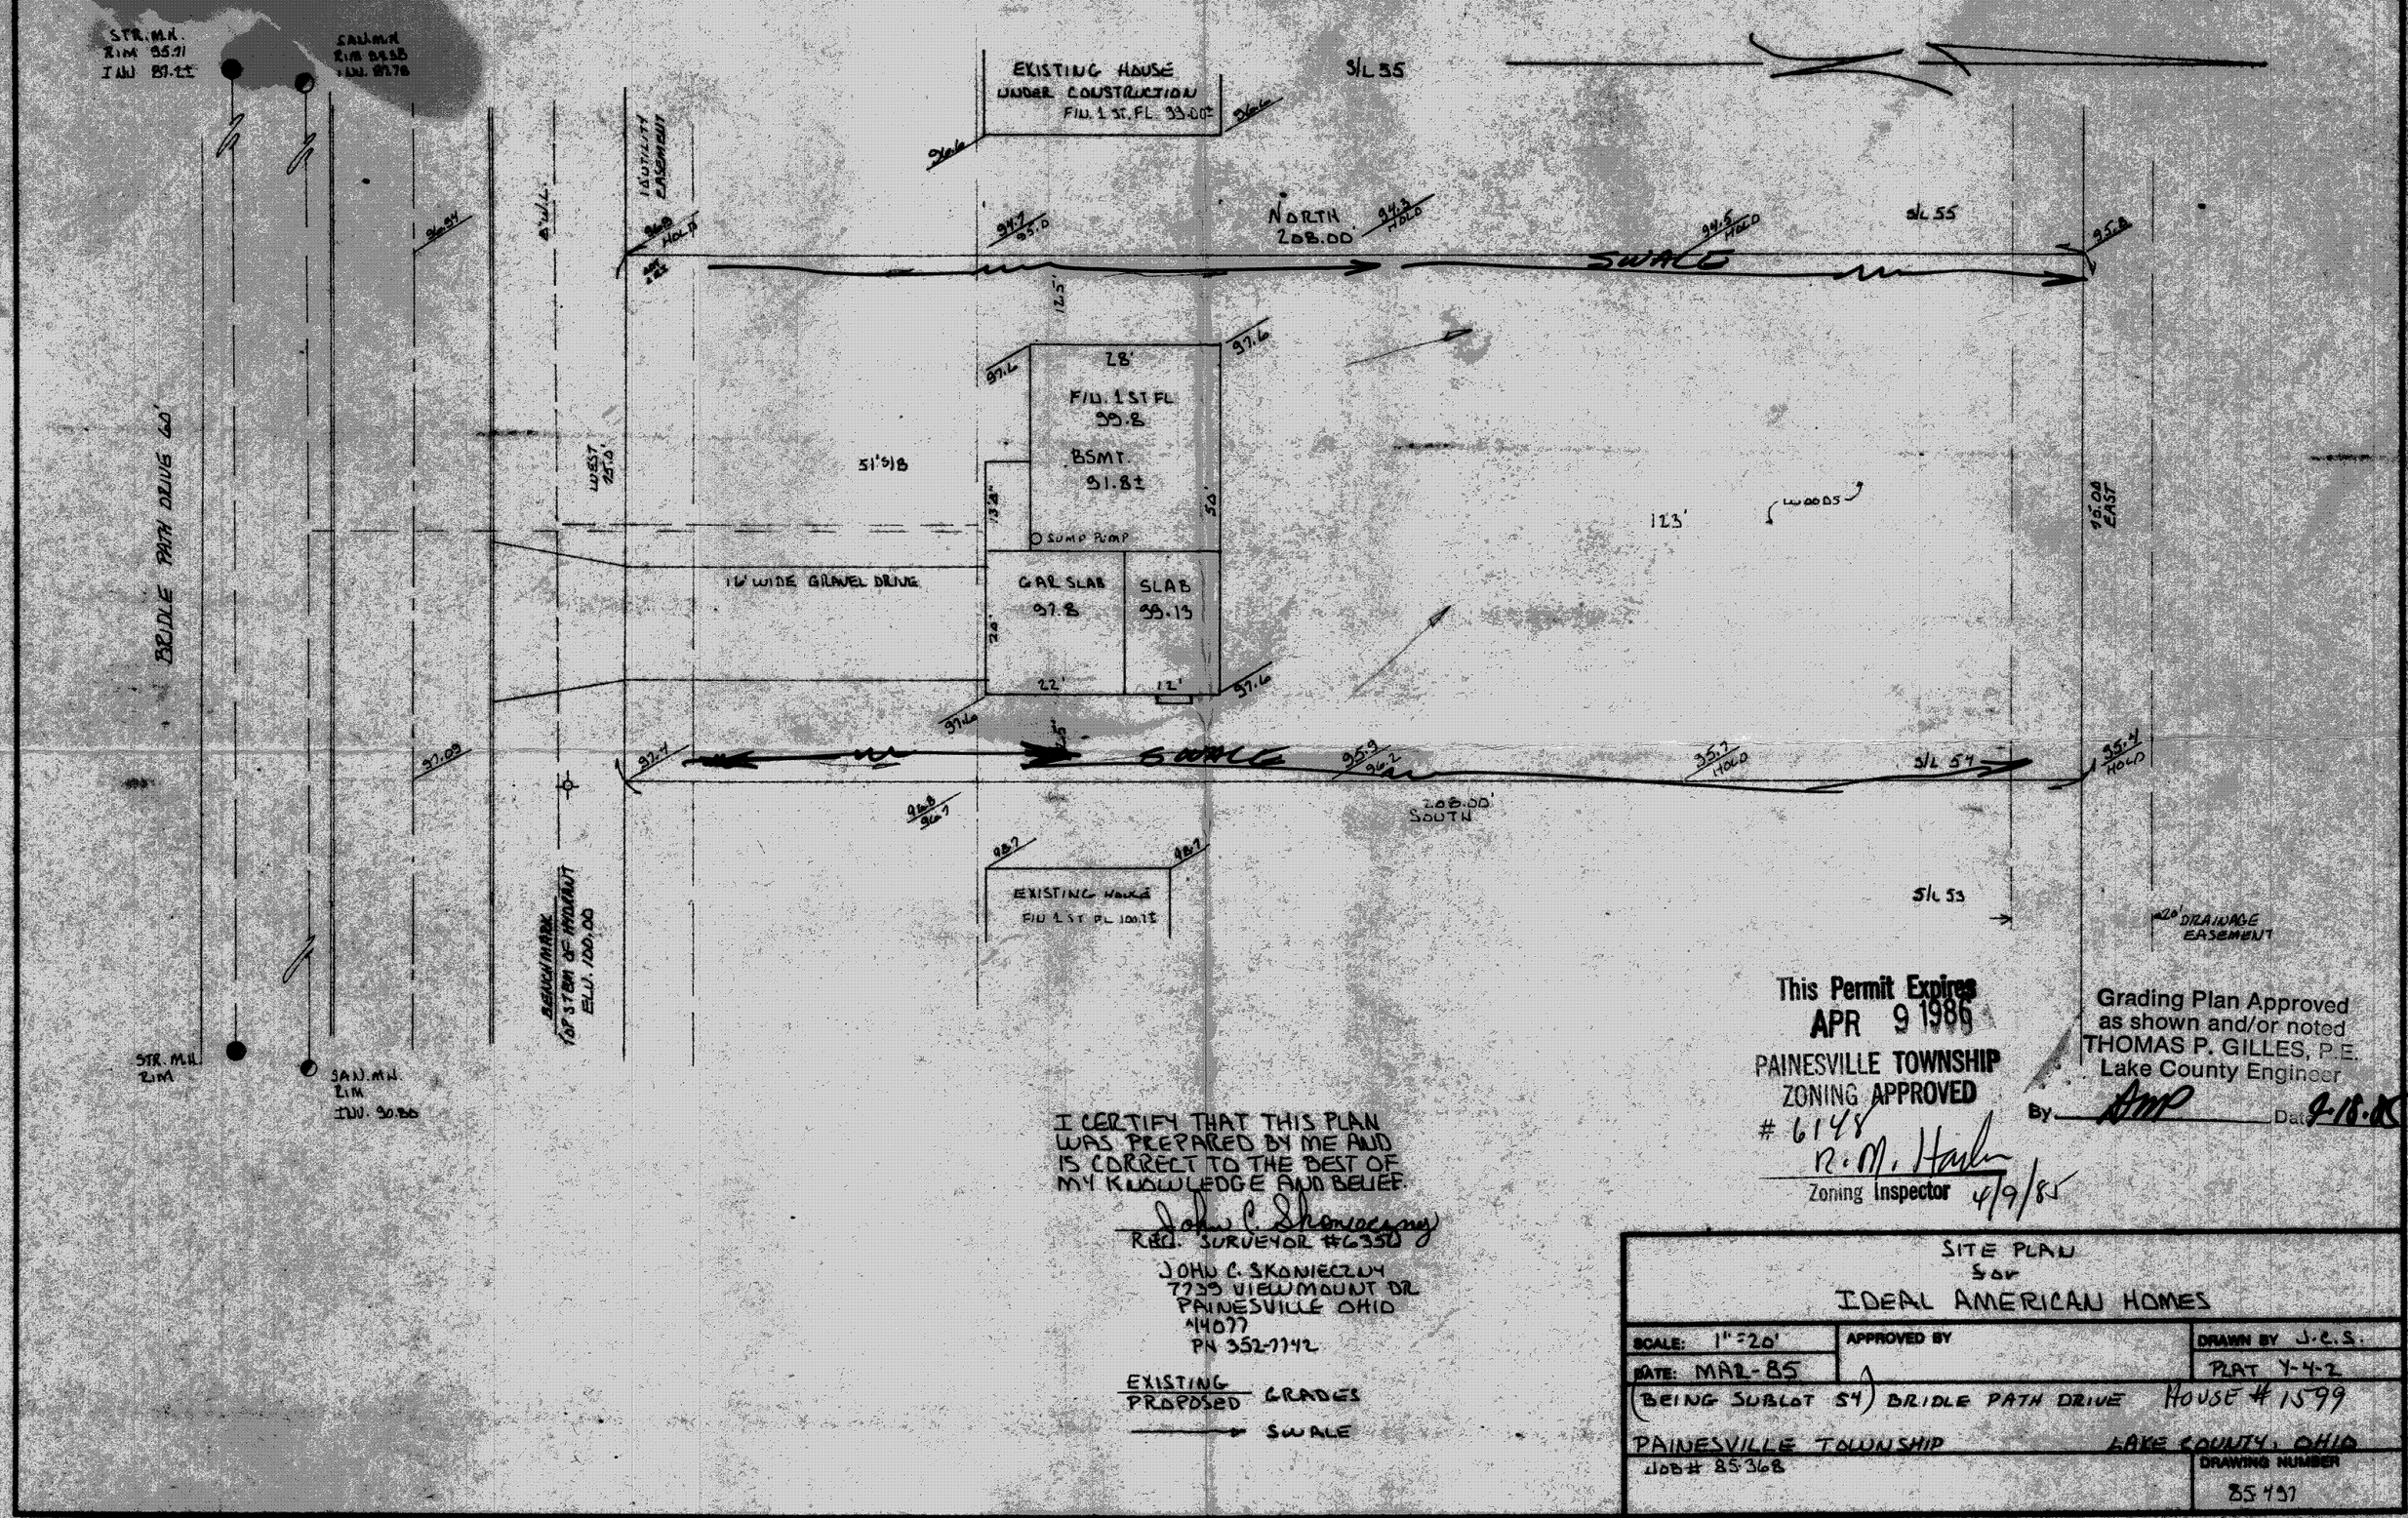

This Permit Expires
APR 9 1986
PAINESVILLE TOWNSHIP
ZONING APPROVED
6148
R. M. Hart
Zoning Inspector 4/9/86

Grading Plan Approved
as shown and/or noted
THOMAS P. GILLES, P.E.
Lake County Engineer
By AMP Date 4-18-86

I CERTIFY THAT THIS PLAN
WAS PREPARED BY ME AND
IS CORRECT TO THE BEST OF
MY KNOWLEDGE AND BELIEF.

John C. Skoniecznj
REG. SURVEYOR #6350

JOHN C. SKONIECZNY
7739 VIEWMOUNT DR
PAINESVILLE OHIO
44077
PH 352-7742

EXISTING / PROPOSED GRADES
SWALE

SITE PLAN
FOR
IDEAL AMERICAN HOMES

SCALE: 1"=20'	APPROVED BY	DRAWN BY J.C.S.
DATE: MAR-85		PLAT Y-4-2

(BEING SUBLOT 54) BRIDLE PATH DRIVE HOUSE # 1599
PAINESVILLE TOWNSHIP LAKE COUNTY, OHIO
JOB # 85368
DRAWING NUMBER 85491