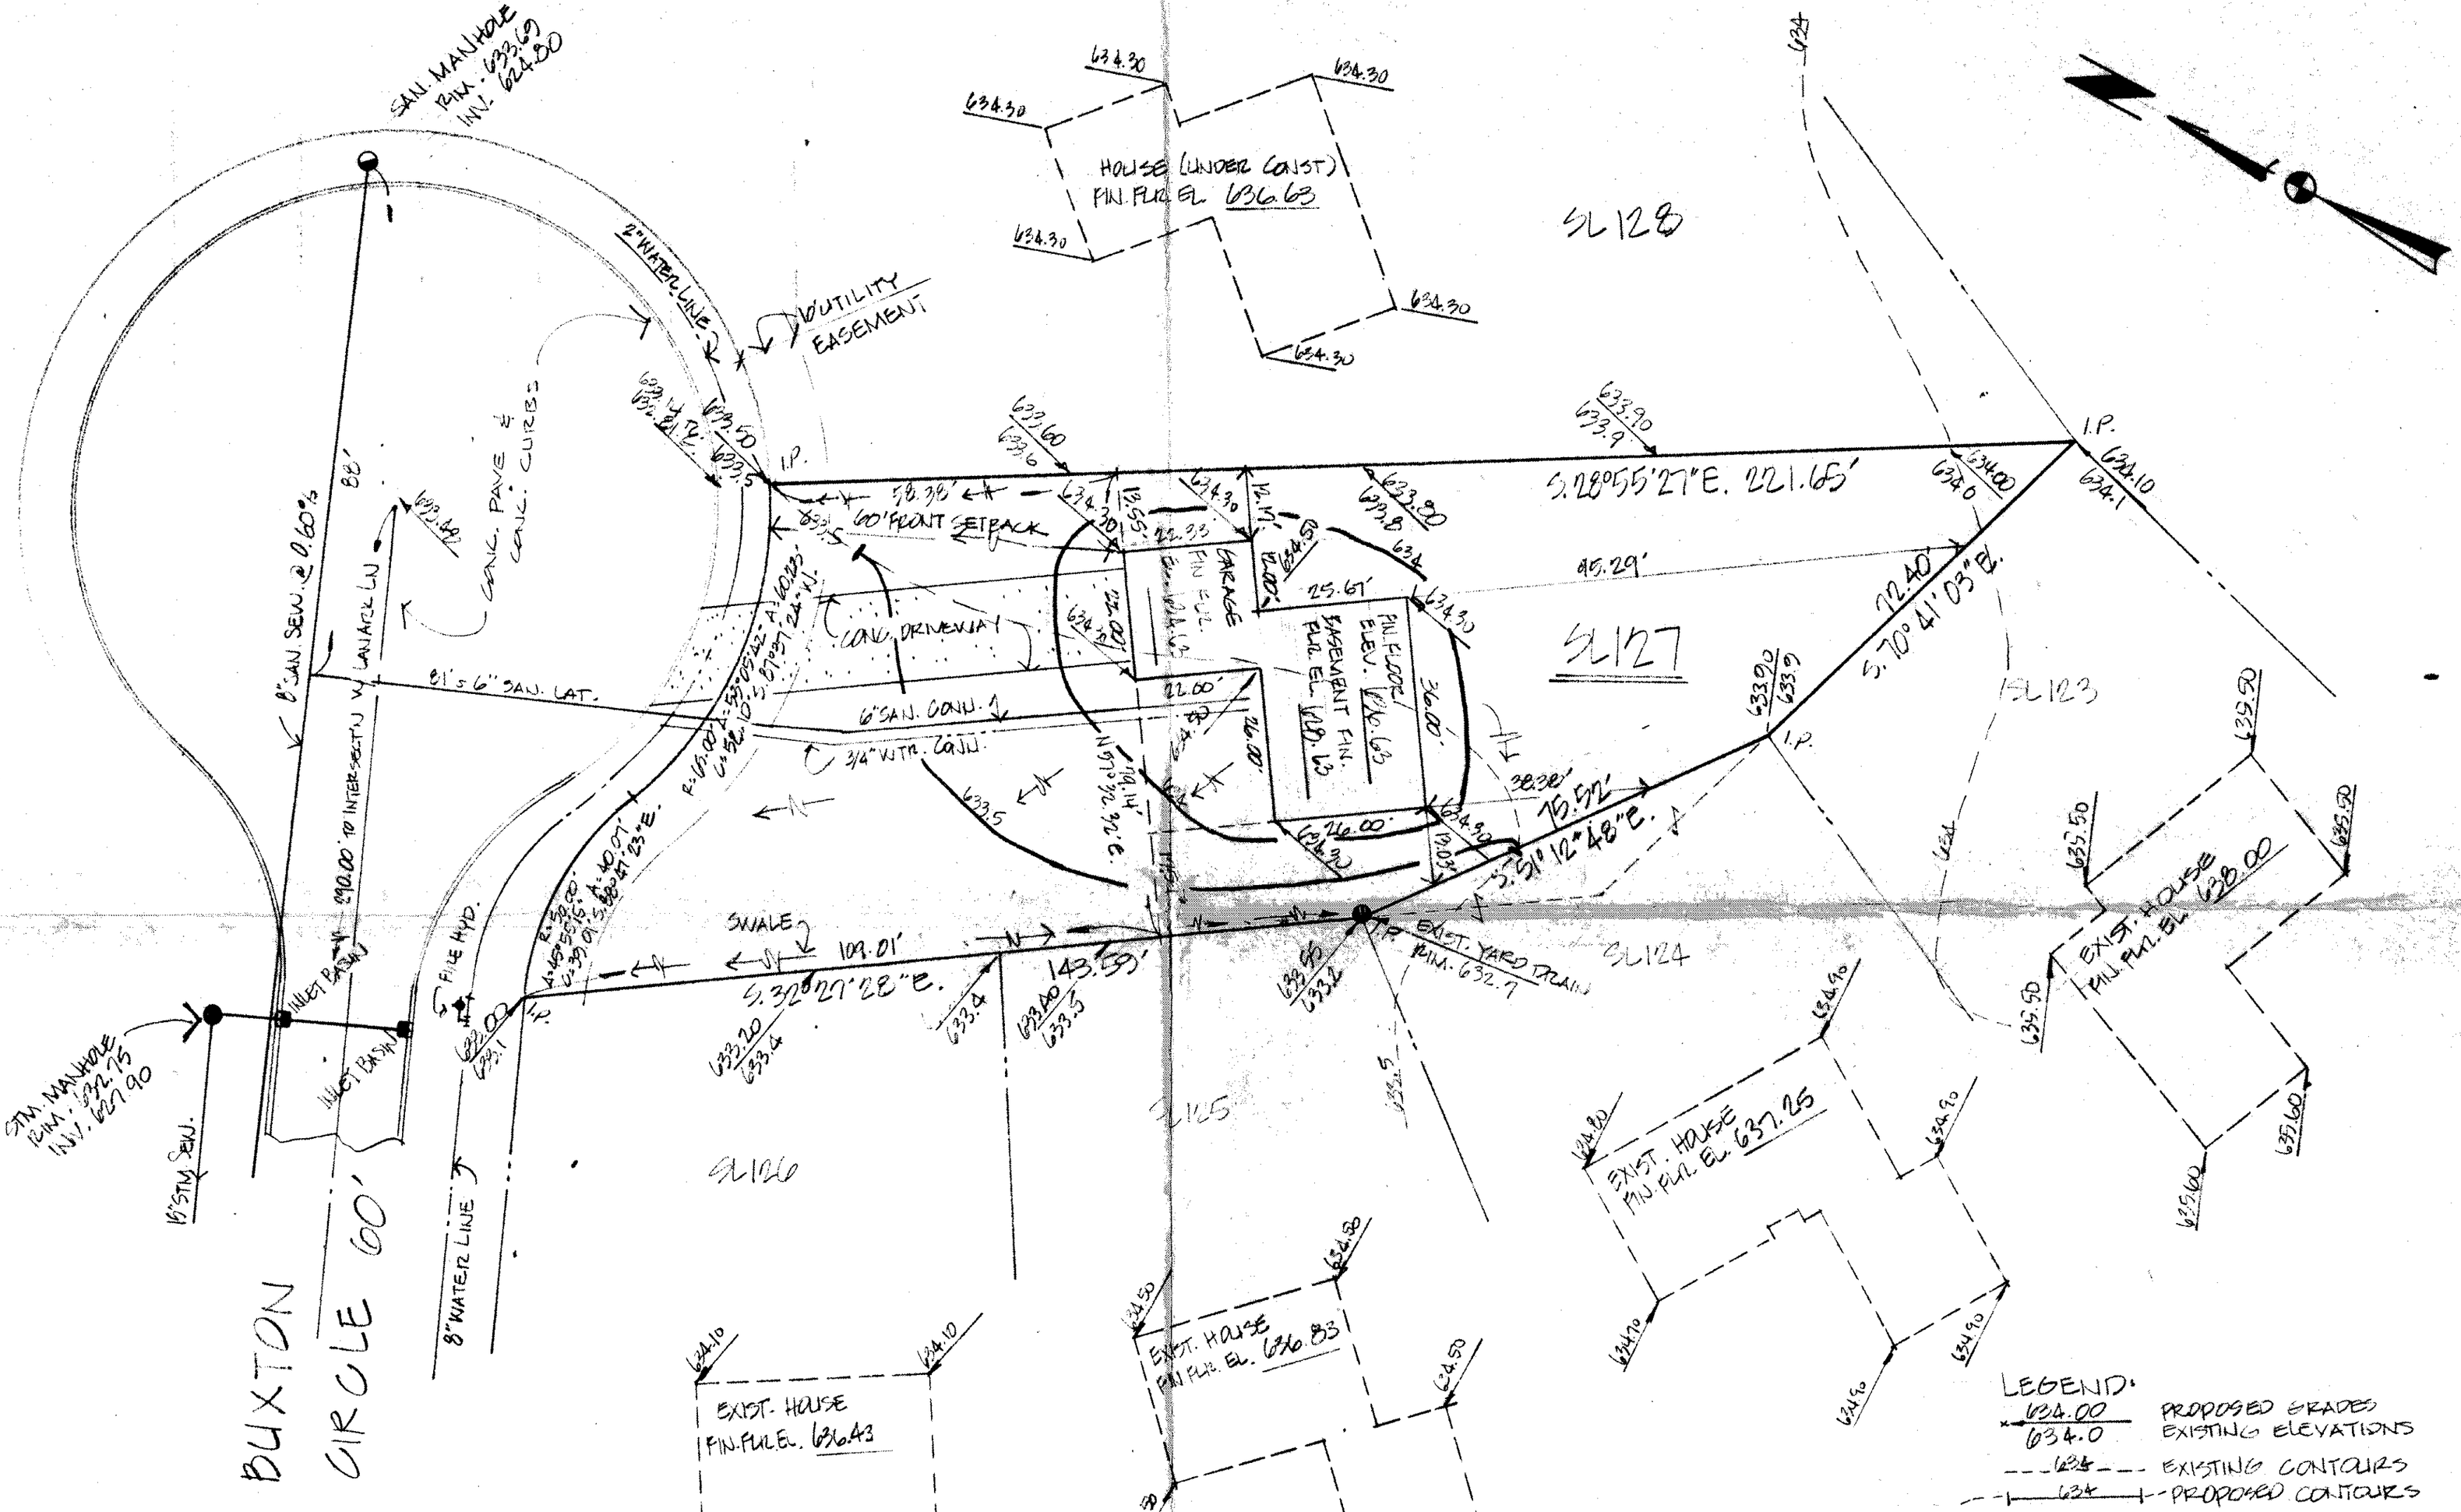

This Permit Expires 6/1/92
PAINESVILLE TOWNSHIP ZONING APPROVED
#7841
Zoning Inspector

Grading Plan Approved as shown and/or noted
THOMAS P. GILLES, P.E.
Lake County Engineer
By GJH Date 6/24/91

DISCHARGE Sump Pump TO YARD DRAIN.

STATE OF OHIO
RICHARD BIESKI
5244

CERTIFICATION:
I HEREBY CERTIFY THAT THIS PLAT WAS PREPARED BY ME, AND IS CORRECT TO THE BEST OF MY KNOWLEDGE AND BELIEF.
BY: [signature] 5244
REGISTERED SURVEYOR NO.

REVISED - ADDED EX. YARD DRAIN - 6-10-91 CB

SITE PLAN FOR: EDWARD H. TRESSER, INC.
8100 DEERWOOD BLVD., MENTOR, OHIO 44060
BEING SUBLOT NO. 127 IN THE PINES SUBDIVISION PHASE III-B IN PAINESVILLE TOWNSHIP, OHIO.

DATE JUNE 4, 1991
SCALE 1" = 20'
DRAWN BY CB
CH'K'D BY
F.B.# 107 PG. 91

CT Consultants, Inc.
Engineers • Architects • Planners
Willoughby • Mentor • Columbus • Lorain • North Canton • Steubenville

SHEET 1 OF 1
CONTRACT NO. 89-478