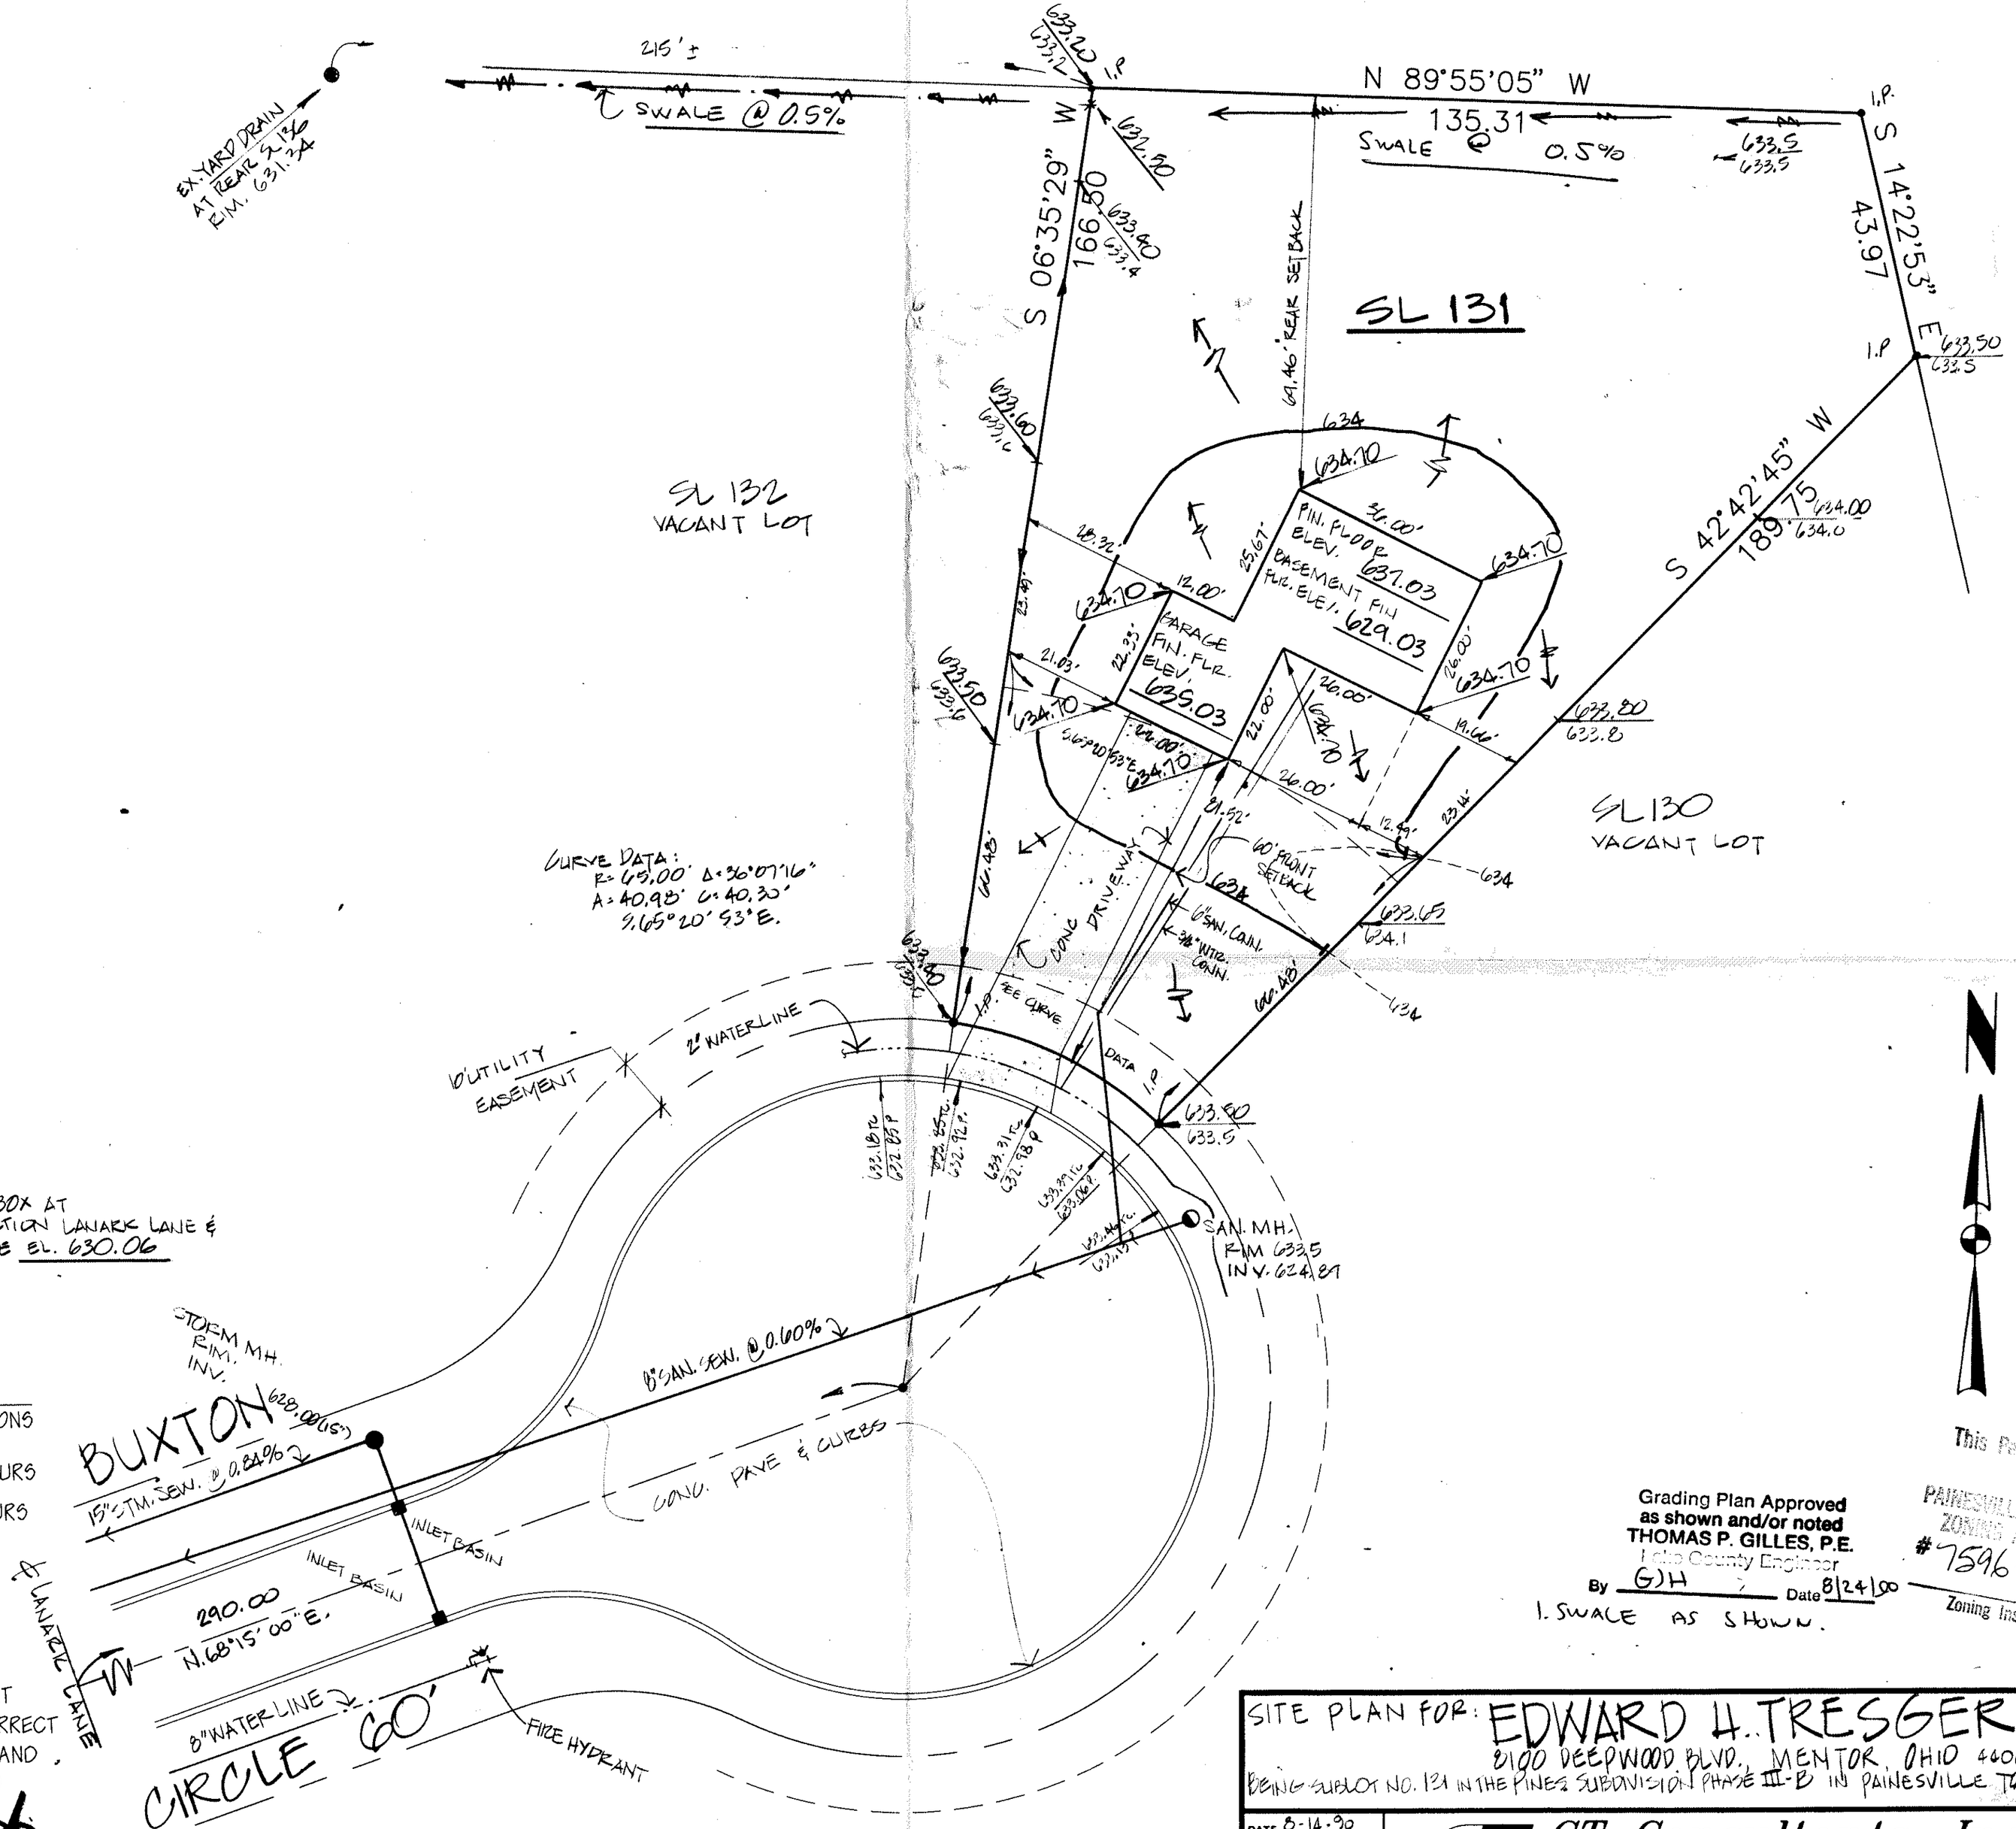

CURVE DATA:
R= 65.00' Δ=36°07'16"
A=40.98' C=40.30'
S.65°20'53"E.

STATE OF OHIO
RICHARD BILSKI
5244
REGISTERED
SURVEYOR

BENCH MARK: TOP OF MON. BOX AT ℄ & INTERSECTION LANARK LANE & WICKHAM PLACE EL. 630.06

LEGEND:

637.00	PROPOSED GRADES
637.0	EXISTING ELEVATIONS
637	PROPOSED CONTOURS
637	EXISTING CONTOURS

CERTIFICATION:

I HEREBY CERTIFY THAT THIS PLAT WAS PREPARED BY ME AND IS CORRECT TO THE BEST OF MY KNOWLEDGE AND BELIEF.

BY: Richard Bilski

RICHARD J. BILSKI REG. NO. 5244

Grading Plan Approved as shown and/or noted
THOMAS P. GILLES, P.E.
Lake County Engineer
By GJH Date 8/24/00

1. SWALE AS SHOWN.

This Permit Expires 8/20/98
PAINESVILLE TOWNSHIP ZONING APPROVED
#7596
Zoning Inspector

SITE PLAN FOR: EDWARD H. TRESGER, INC.
8100 DEEPWOOD BLVD., MENTOR, OHIO 44060
BEING SUBLOT NO. 131 IN THE PINES SUBDIVISION PHASE III-B IN PAINESVILLE TOWNSHIP, OHIO.

DATE	8-14-90
SCALE	1" = 60'
DRAWN BY	CDB

CT Consultants, Inc.
Engineers • Archi ts • Planners

SHEET 1 OF 1