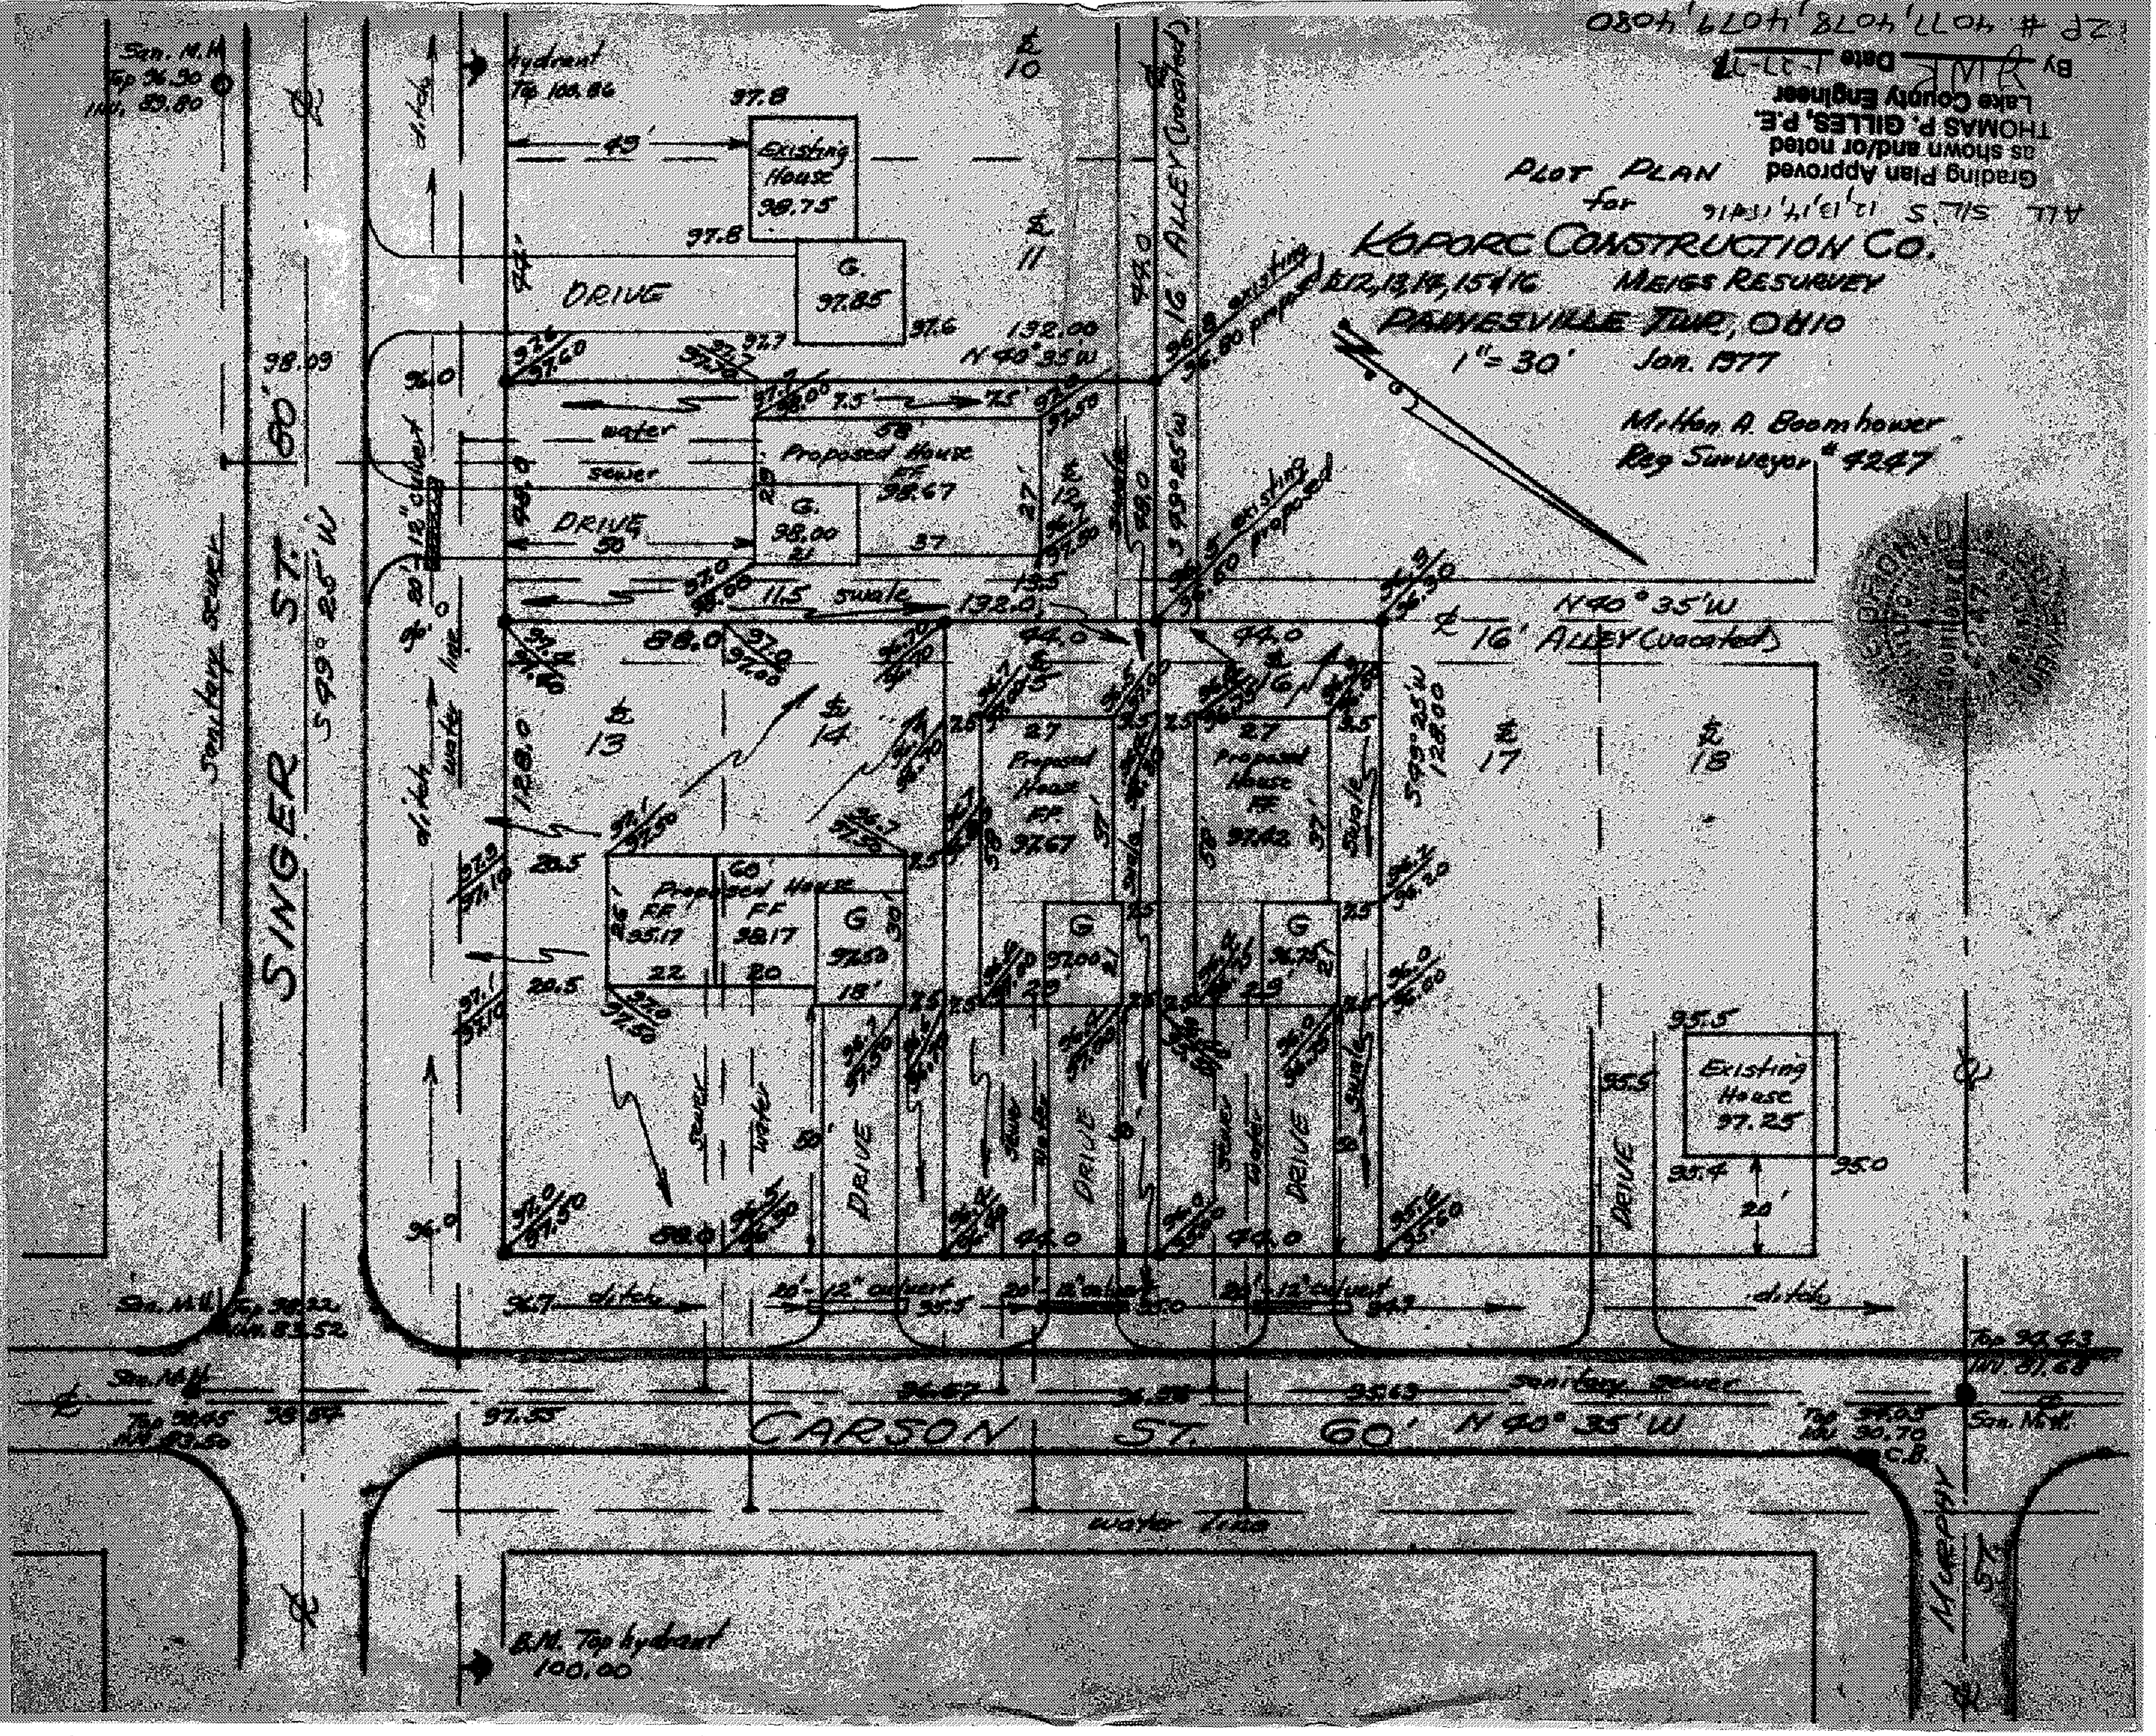
PLOT PLAN
for
KOPORC CONSTRUCTION CO.
L12, 13, 14, 15 & 16 MEIGS RESURVEY
PAINESVILLE TWP., OHIO
1" = 30' Jan. 1977
Milton A. Boomhower
Reg. Surveyor # 4247
Grading Plan Approved
as shown and/or noted
THOMAS P. GILLES, P.E.
Lake County Engineer
By JMR Date 1-27-77
ALL S/L'S 12, 13, 14, 15 & 16
ZP # 4077, 4078, 4079, 4080
SINGER ST. S 49° 25' W
CARSON ST. 60' N 40° 35' W
MURPHY ST.
16' ALLEY (vacated)
N 40° 35' W
Existing House 98.75
Existing House 97.25
Proposed House FF 98.67
Proposed House FF 95.17 FF 98.17
Proposed House FF 97.67
Proposed House FF 97.42
DRIVE
water
sewer
sanitary sewer
water line
ditch
swale
20'-12" culvert
San. M.H. Top 96.30 INV. 89.80
Hydrant Top 100.86
B.M. Top hydrant 100.00
Top 95.43 INV. 87.68
C.B.