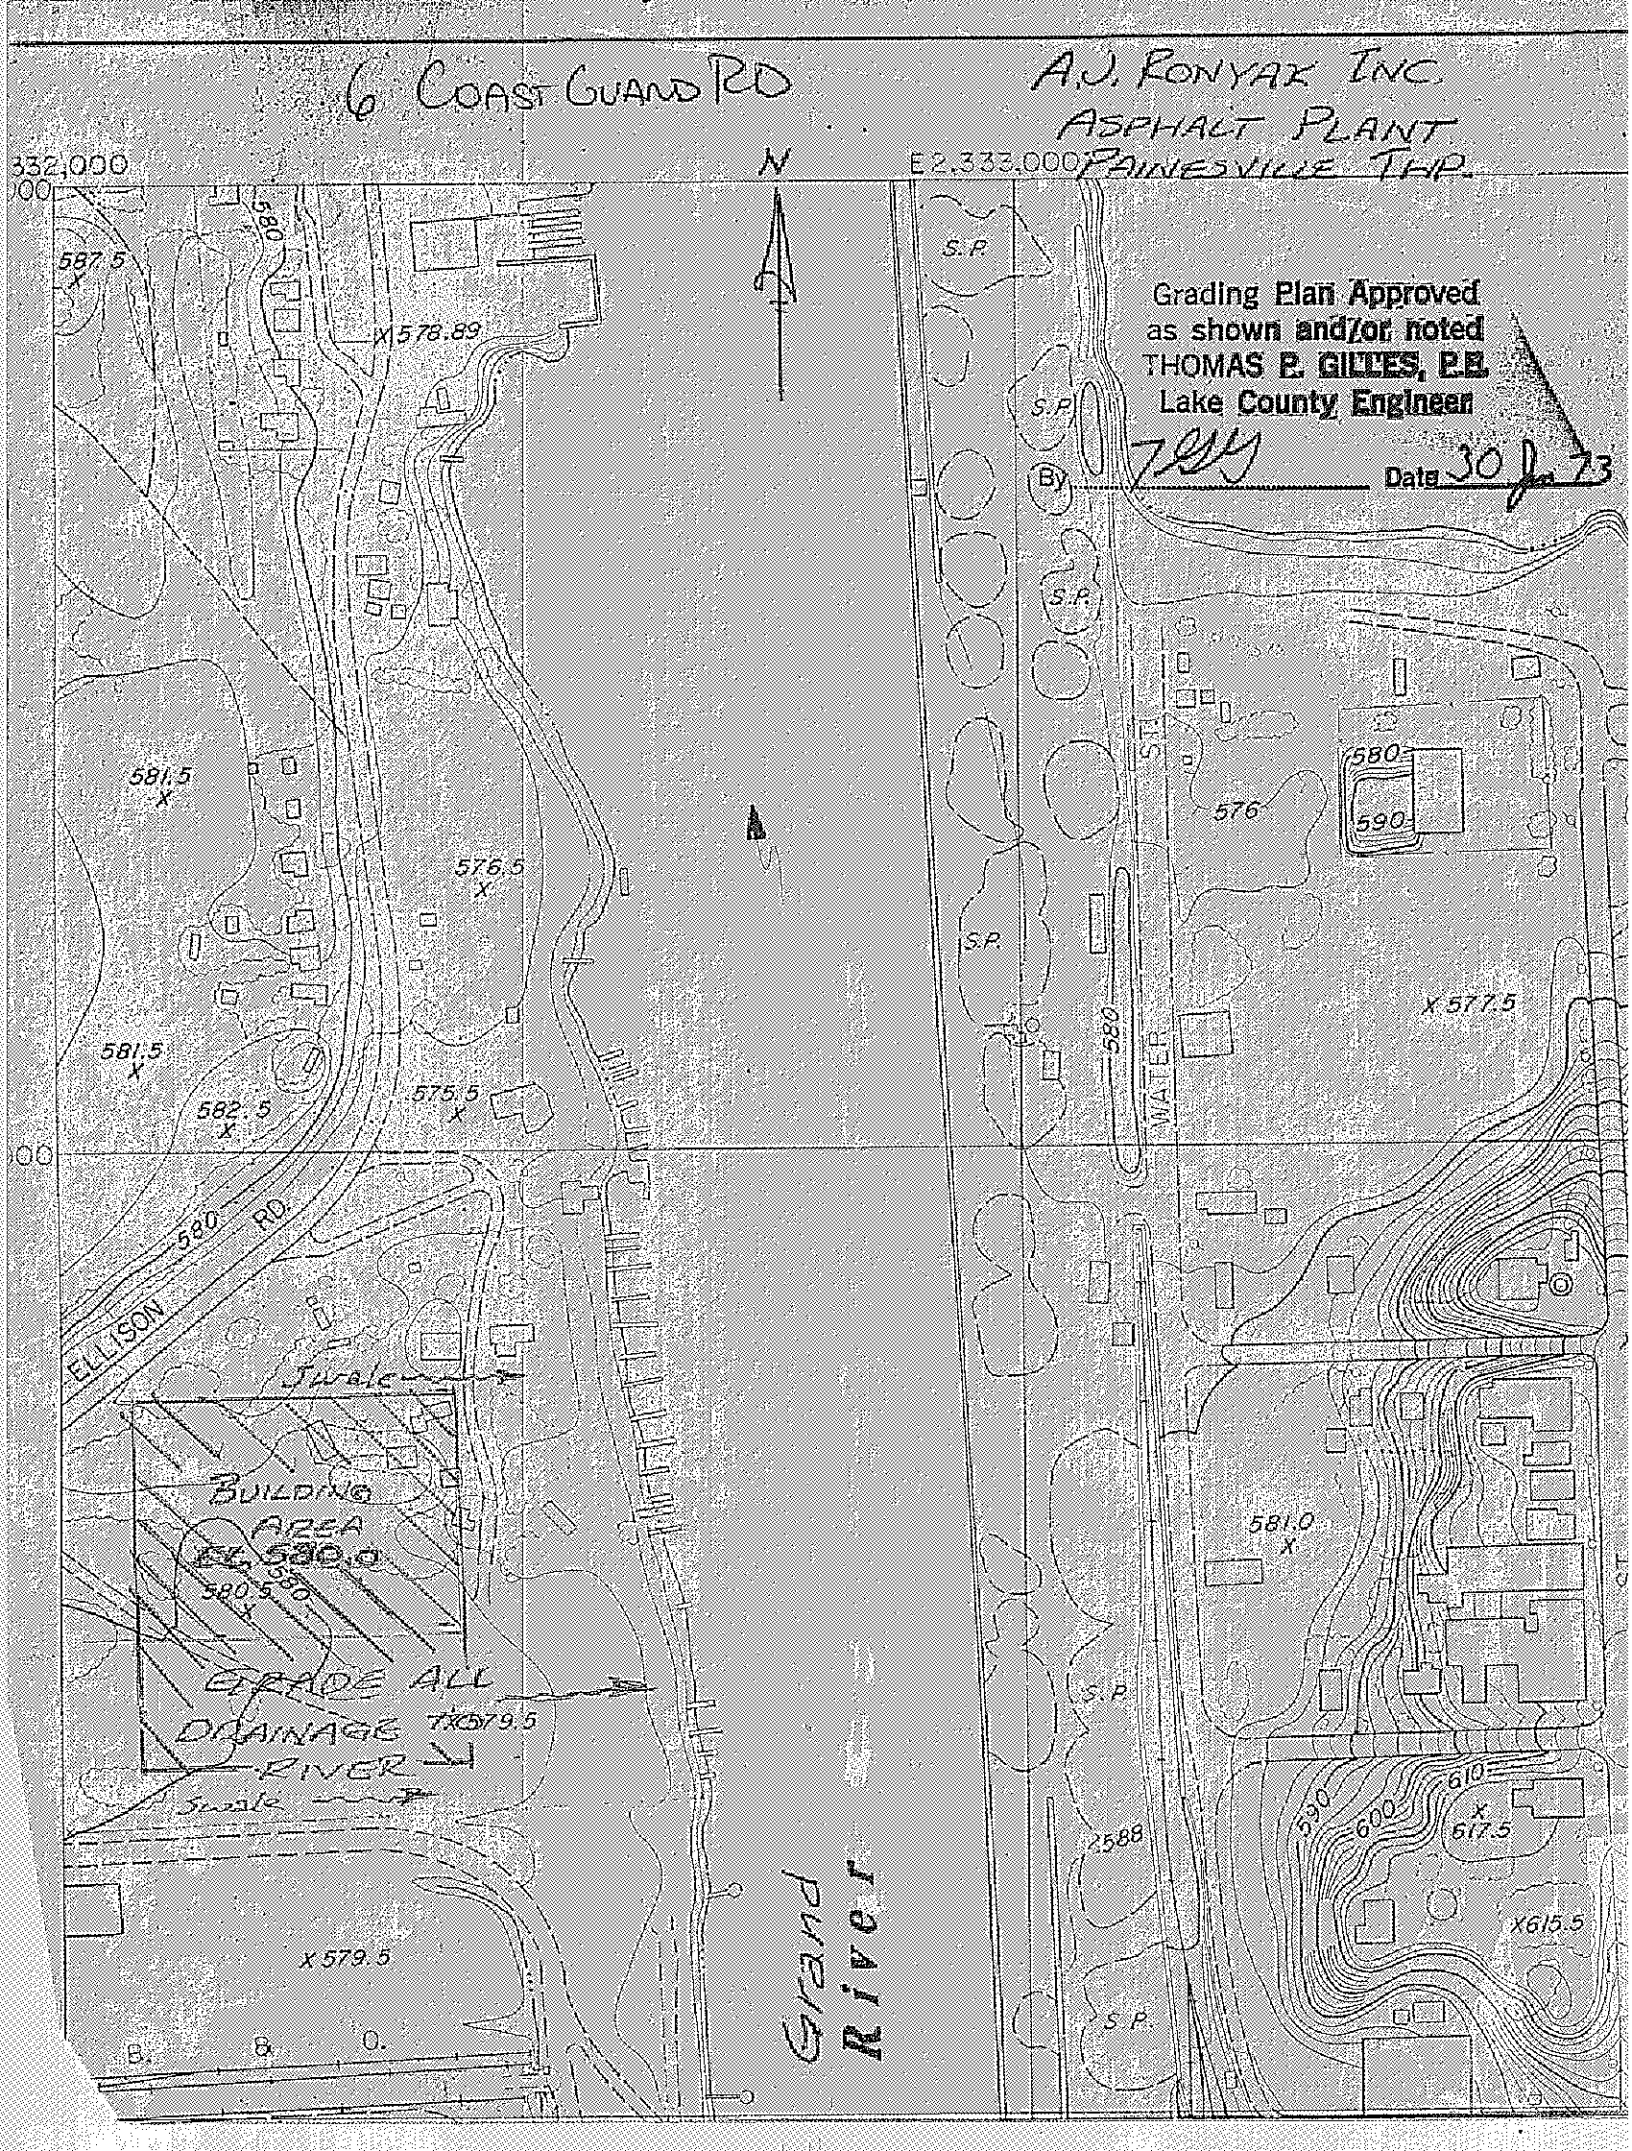
6 COAST GUARD RD
A.J. RONYAK INC.
ASPHALT PLANT
PAINESVILLE TWP.
E 2,333,000
N
Grading Plan Approved
as shown and/or noted
THOMAS B. GILLES, P.E.
Lake County Engineer
By
Date 30 Jan 73
S.P.
587.5
578.89
581.5
576.5
581.5
582.5
575.5
580
590
576
577.5
581.0
588
579.5
615.5
ELLISON RD.
WATER ST.
PAINESVILLE
BUILDING AREA
ELEV. 580.0
580.5
REGRADE ALL
DRAINAGE
RIVER
Swale
B. & O.