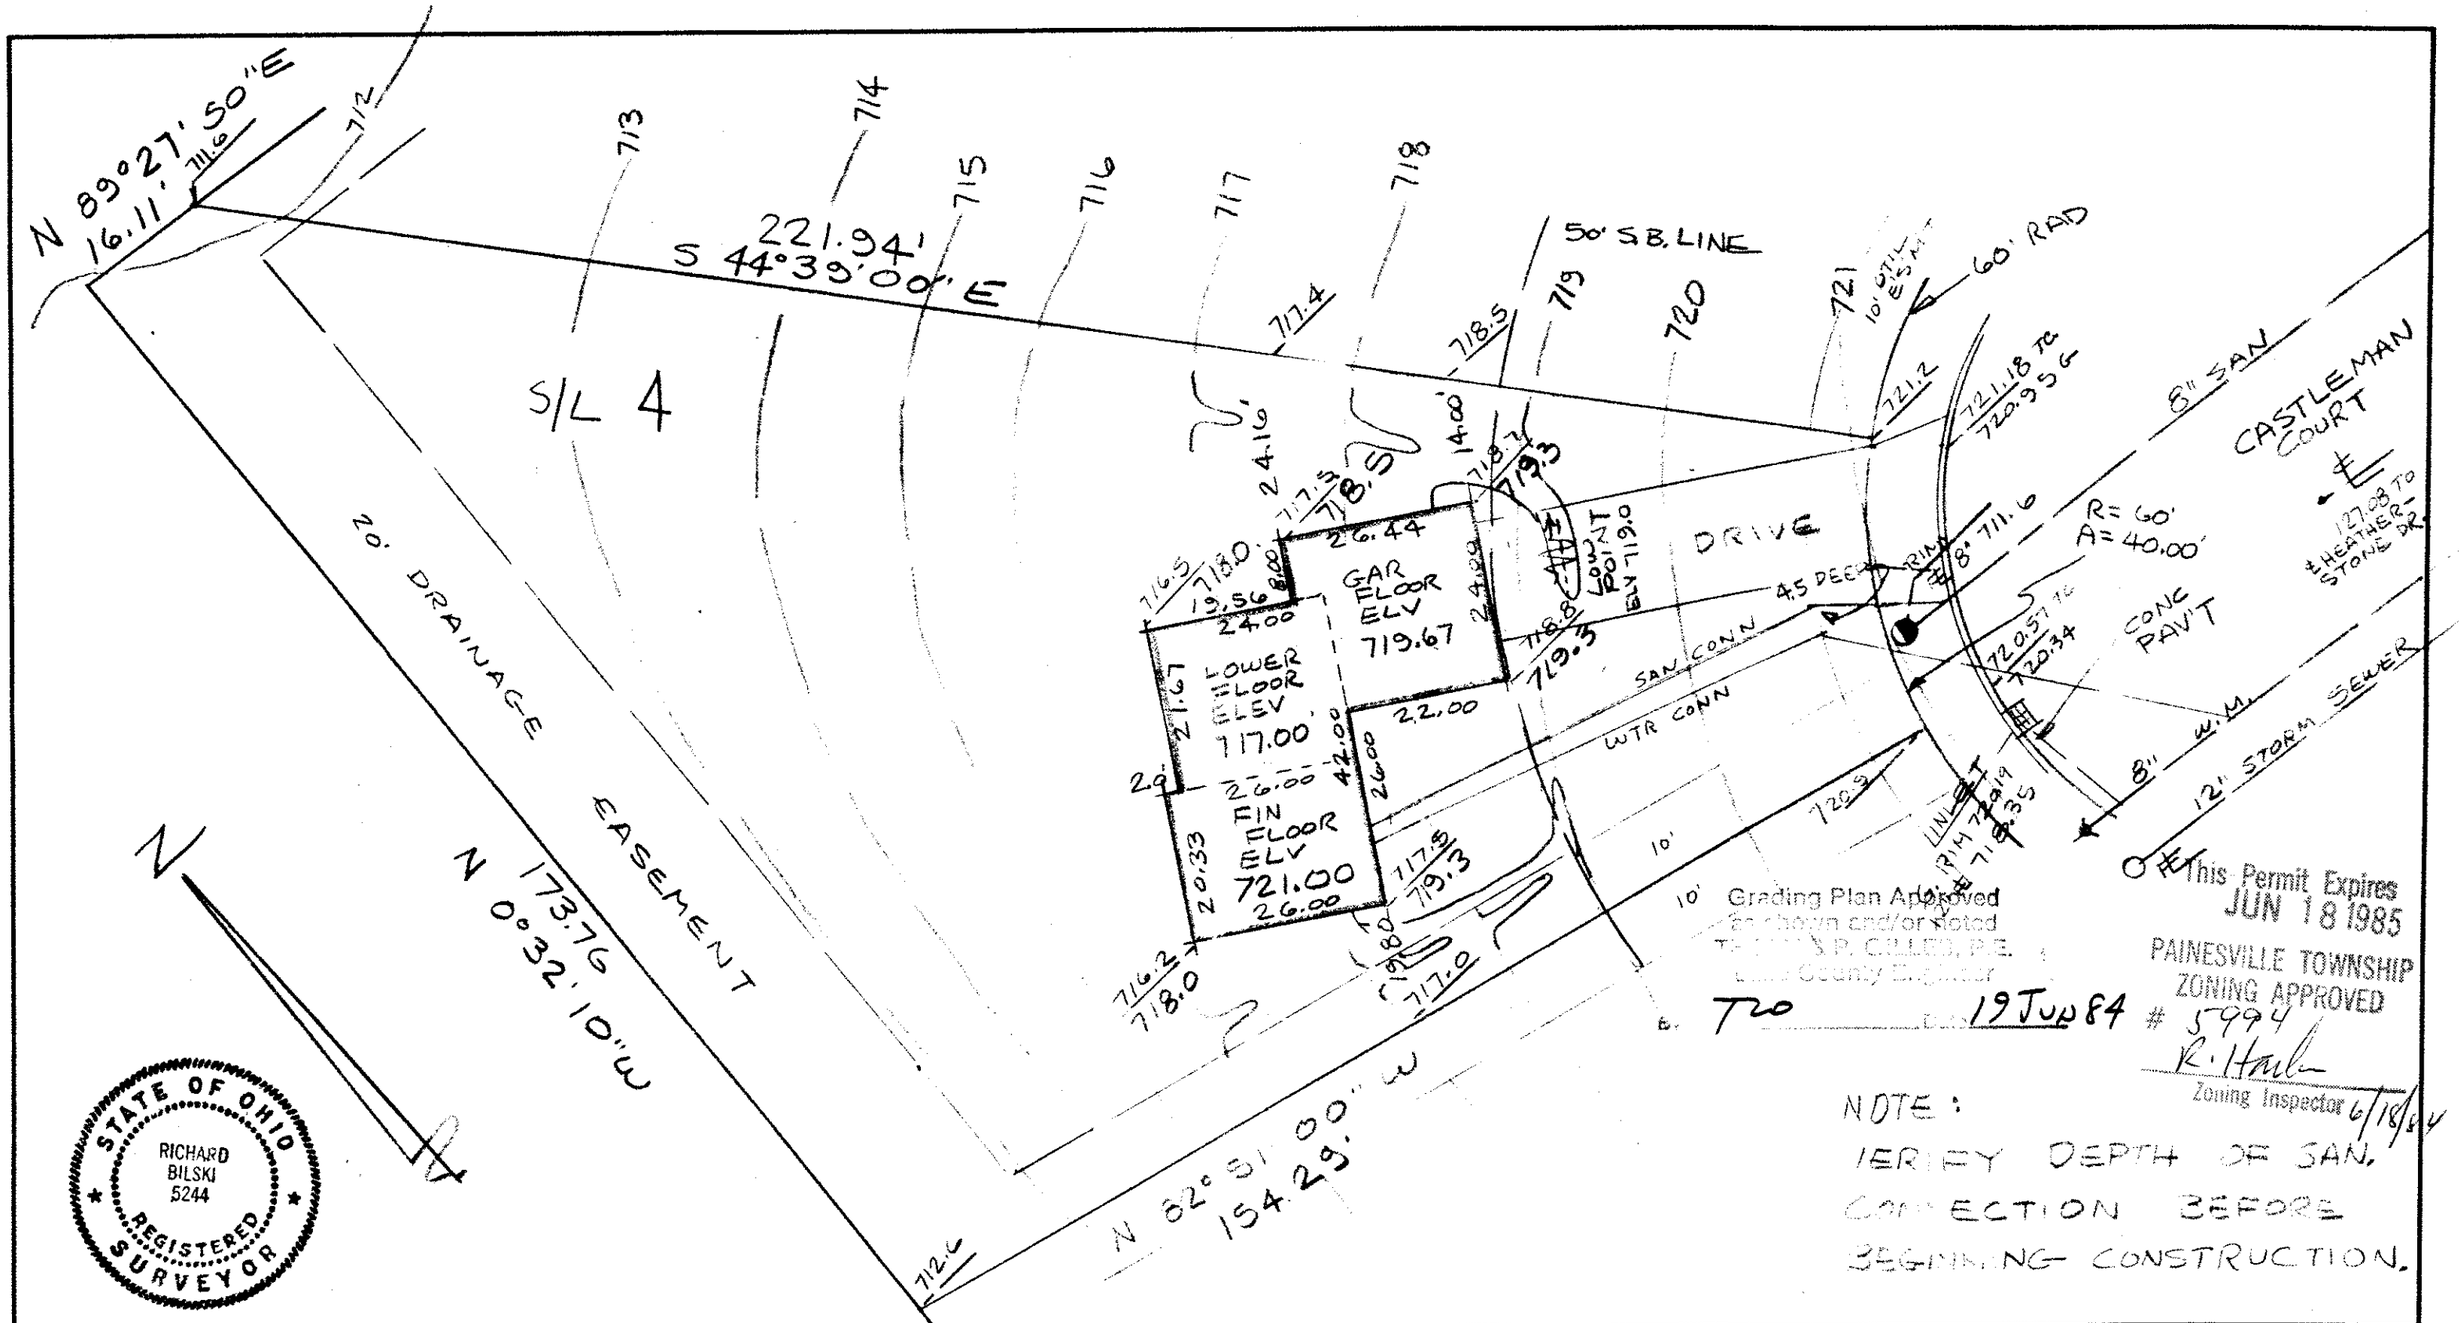

DESIGN CERTIFICATION	AS BUILT CERTIFICATION			
THIS PLAT WAS PREPARED BY ME, AND IS CORRECT TO THE BEST OF MY KNOWLEDGE AND BELIEF.	I HEREBY CERTIFY THAT THE CIRCLED GRADES ARE EXISTING FINISH GRADES CHECKED IN THE FIELD ON _____ AND THAT SURVEY IS CORRECT TO THE BEST OF MY KNOWLEDGE AND BELIEF.	**COLPETZER · WOODS** CONSULTANTS, INC. 9470 MENTOR AVENUE • MENTOR, OHIO 44060 • (216) 357-7569	DATE JUNE 7, 84 SCALE 1" = 20 DRWN BY RJB CHKD BY RJB JOB NO. 84-144 FB ____ PG ____	SITE PLAN for HOMICO CONSTRUCTION of S/L 4 HEATHERSTONE SUBD No 1 VOL 2 PG 35 PAINESVILLE TWP, LAKE COUNTY, O.
REG. SURVEYOR NO. 5244	REG. SURVEYOR NO. _____			