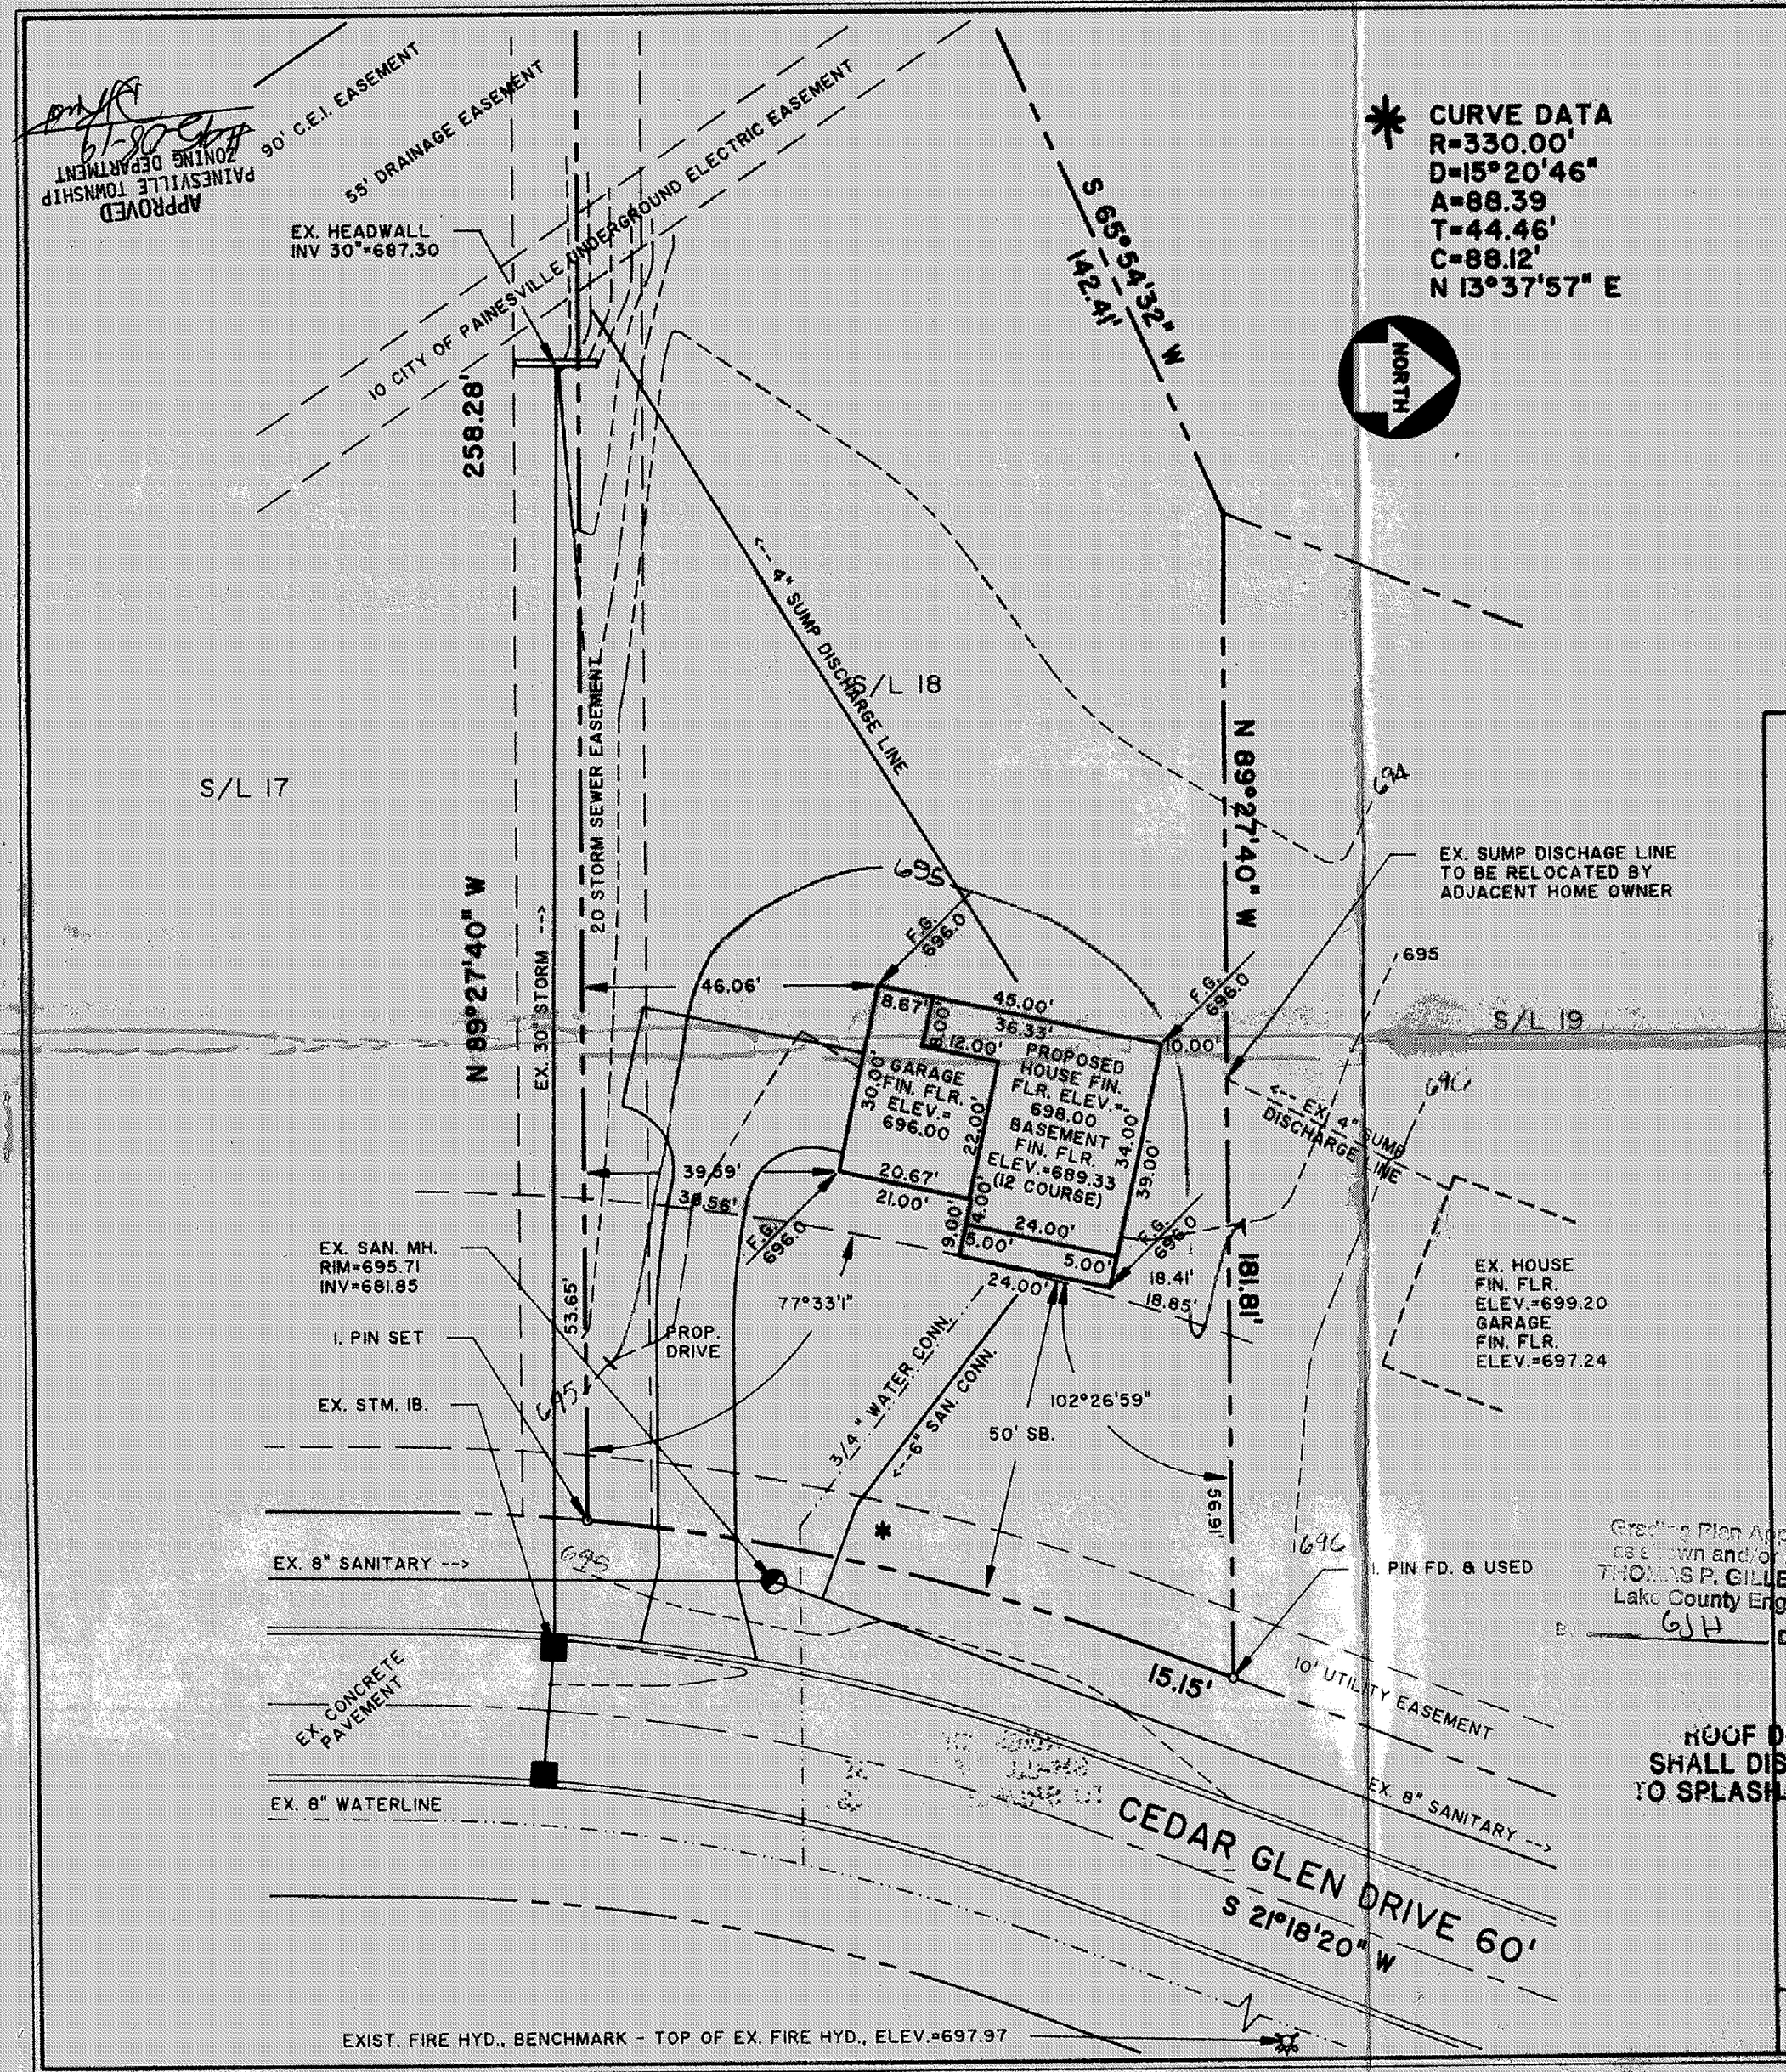

CURVE DATA
R=330.00'
D=15°20'46"
A=88.39
T=44.46'
C=88.12'
N 13°37'57" E

GRAPHIC SCALE

20 0 10 20 40 80

(IN FEET)
1 inch = 20 ft.

GENERAL NOTES:

1. DRIVEWAY APRON TO BE 6" THICK
2. BENCHMARK - TOP STEM OF FIRE HYDRANT LOCATED IN FRONT OF SUBLOT NO. 31, ELEV.=697.97

LEGEND

EXISTING CONTOUR
PROPOSED CONTOUR
100.00 / 100.00 EXISTING ELEVATION / PROPOSED ELEVATION

STATE OF OHIO
DAVID W. NOVAK
S-7507
REGISTERED
SURVEYOR

CERTIFICATION

"I THE UNDERSIGNED HEREBY CERTIFY THAT THIS TOPOGRAPHY INDICATED BY 1' CONTOURS AND ELEVATIONS SHOWN HEREON REPRESENTS AN ACTUAL SURVEY MADE BY ME ON THE 31st. DAY OF JULY , 1995 AND THE ELEVATIONS WERE TAKEN AT APPROPRIATE INTERVALS AND AS OF THAT DAY THEY EXISTED AS INDICATED HEREON.

"I HEREBY CERTIFY THAT THIS PLAN WAS PREPARED BY ME AND IS CORRECT TO THE BEST OF MY KNOWLEDGE"

DAVID W. NOVAK, P.S. No. 7507

Grading Plan Approved as shown and/or noted
THOMAS P. GILLES, P.E.
Lake County Engineer
By GJH Date 8 2395

ROOF DRAINS SHALL DISCHARGE TO SPLASH BLOCKS.

PREPARED BY:

Himebaugh and Novak
Surveyors and Site Consultants
8663 Tyler Boulevard
Mentor, Ohio 44060-4346
(216) 974-7670, (216) 255-5900 FAX.

SITE PLAN: SUBLOT NO. 18, CEDAR GLEN DRIVE 60', PAINESVILLE TWP. CEDAR GLEN SUBDIVISION NO. 2, VOL. 16, PG. 38, LC.R.P.
PREPARED FOR: LITTLE MOUNTAIN HOMES, INC.
SCALE: 1" = 20'
DATE: AUGUST 01, 1995
DRAWN BY: DAVID W. NOVAK

APPROVED
PAINESVILLE TOWNSHIP
ZONING DEPARTMENT
95-08-19

REV. A, RELOCATED HOUSE, (08/07/95)

94012-18

FORM No. A-004 (01/17/94)