SITE PLAN

for : R.L. Moore Homes, Inc.
CLIENT

ADDRESS	CITY	STATE	ZIP
1360 Madison ~~Rd.~~ AVE.	Painesville	Ohio	44077

SUBLOT No.	SUBDIVISION NAME	VOL.	PAGE
71	Lake Erie Shores	42	25

LOT	TRACT	CITY	STATE
4,27	2,1	Painesville	Ohio

Foresight Engineering Group

440 286-1010
440 286-1034 fax
320 Center Street, Unit F
Chardon, Ohio 44024

Engineers & Surveyors

SCALE : 1" = 20'	1	
FILE NAME: I:\Rlm10209\field	2	
DATE : August 14, 2002	3	

BENCHMARK: Sanitary Sewer Manhole Rim Elevation: 622.71 (as shown)

SHEET NO. 1/2

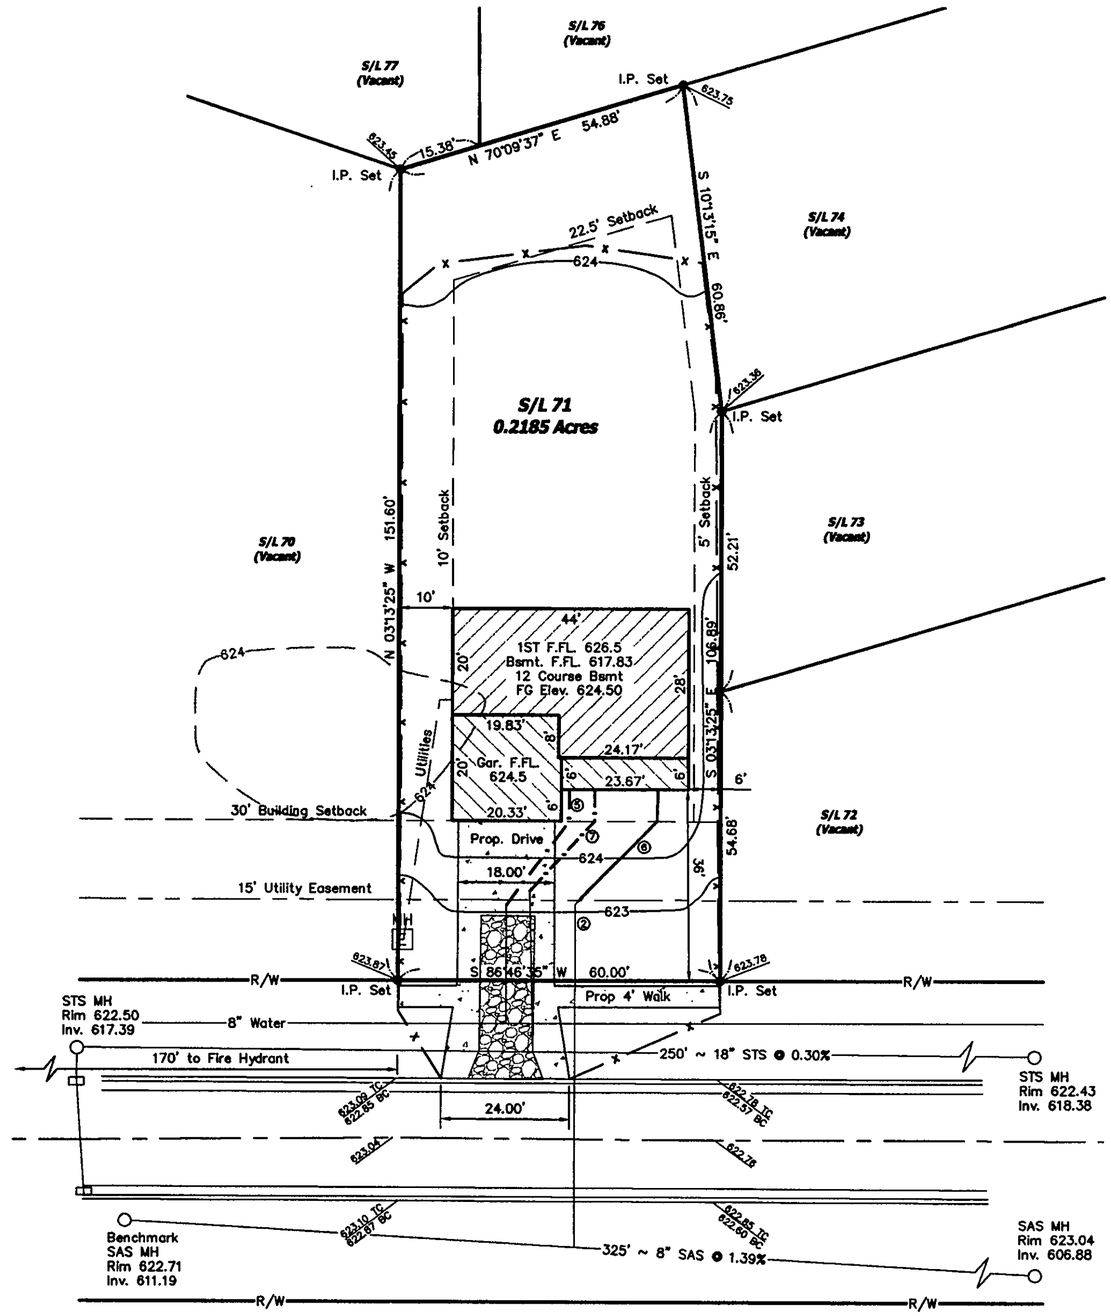

GRAPHIC SCALE
20 0 10 20
(IN FEET)
1 inch = 20 ft.

LEGEND

	Ron Pin Found in Monument
	Manhole
	Curb Inlet
	Fire Hydrant
	Electrical Box
	Iron Pin Set

EROSION CONTROL SYMBOLS

—x——x— SILT FENCE

CONSTRUCTION ENTRANCE

NOTES:

1.) Down spouts shall be splashblocked.

2.) Field verify depth of Existing Sanitary Lat. To determine availability of basement sanitary service.

3.) Sidewalk shall be 4" thick and in accordance with ODOT Item 608, Except where it passes through the driveway, the thickness shall be 6".

4.) Utilities include Gas, Phone, Electric, and Cable. Contractor to field verify location and provide connection at utility.

5.) Water Lateri to be 3/4" Copper Type "K".

6.) Sanitary Lateri to be 6" Poly Vinyl Chloride SDR 26, O Ring Joints @ 1.0% Min slope.

7.) Storm Sewer Lateri to be 6" Poly Vinyl Chloride SDR 26, @ 1.0% Min slope.

Grading Plan Approved
as shown and/or noted
J[illegible] GILLS, P.E.
Lake County Engineer
By GJH Date 8-23-02

The locations of the underground utilities as shown hereon are based on above ground structures and record drawings. Locations of underground utilities/structures may vary from the locations shown hereon. Additional buried utilities/structures may be encountered. Contractor to field verify horizontal and vertical location of all utilities in all area of work prior to commencement of work.

2 WORKING DAYS BEFORE YOU DIG

CALL TOLL FREE 800-362-2764
OHIO UTILITIES PROTECTION SERVICE

STATE OF OHIO
STEVEN N. ROESSNER
S-7070
REGISTERED
PROFESSIONAL SURVEYOR

"I, the undersigned hereby state that this topography, indicated by 1' contours, and the elevations shown hereon represent an actual field survey made by Foresight Engineering Group, Inc. on the 12 day of August, 2002 and that the elevations were taken at appropriate intervals and that as of that date they existed as indicated hereon."

Steven N. Roessner, P.S. S-7070 — Date 8-14-02

I:\cdsk\proj\Rlm10209\cad\field.dwg, 08/14/02 09:53:31 AM, Copyright Foresight Engineering Group, Inc.