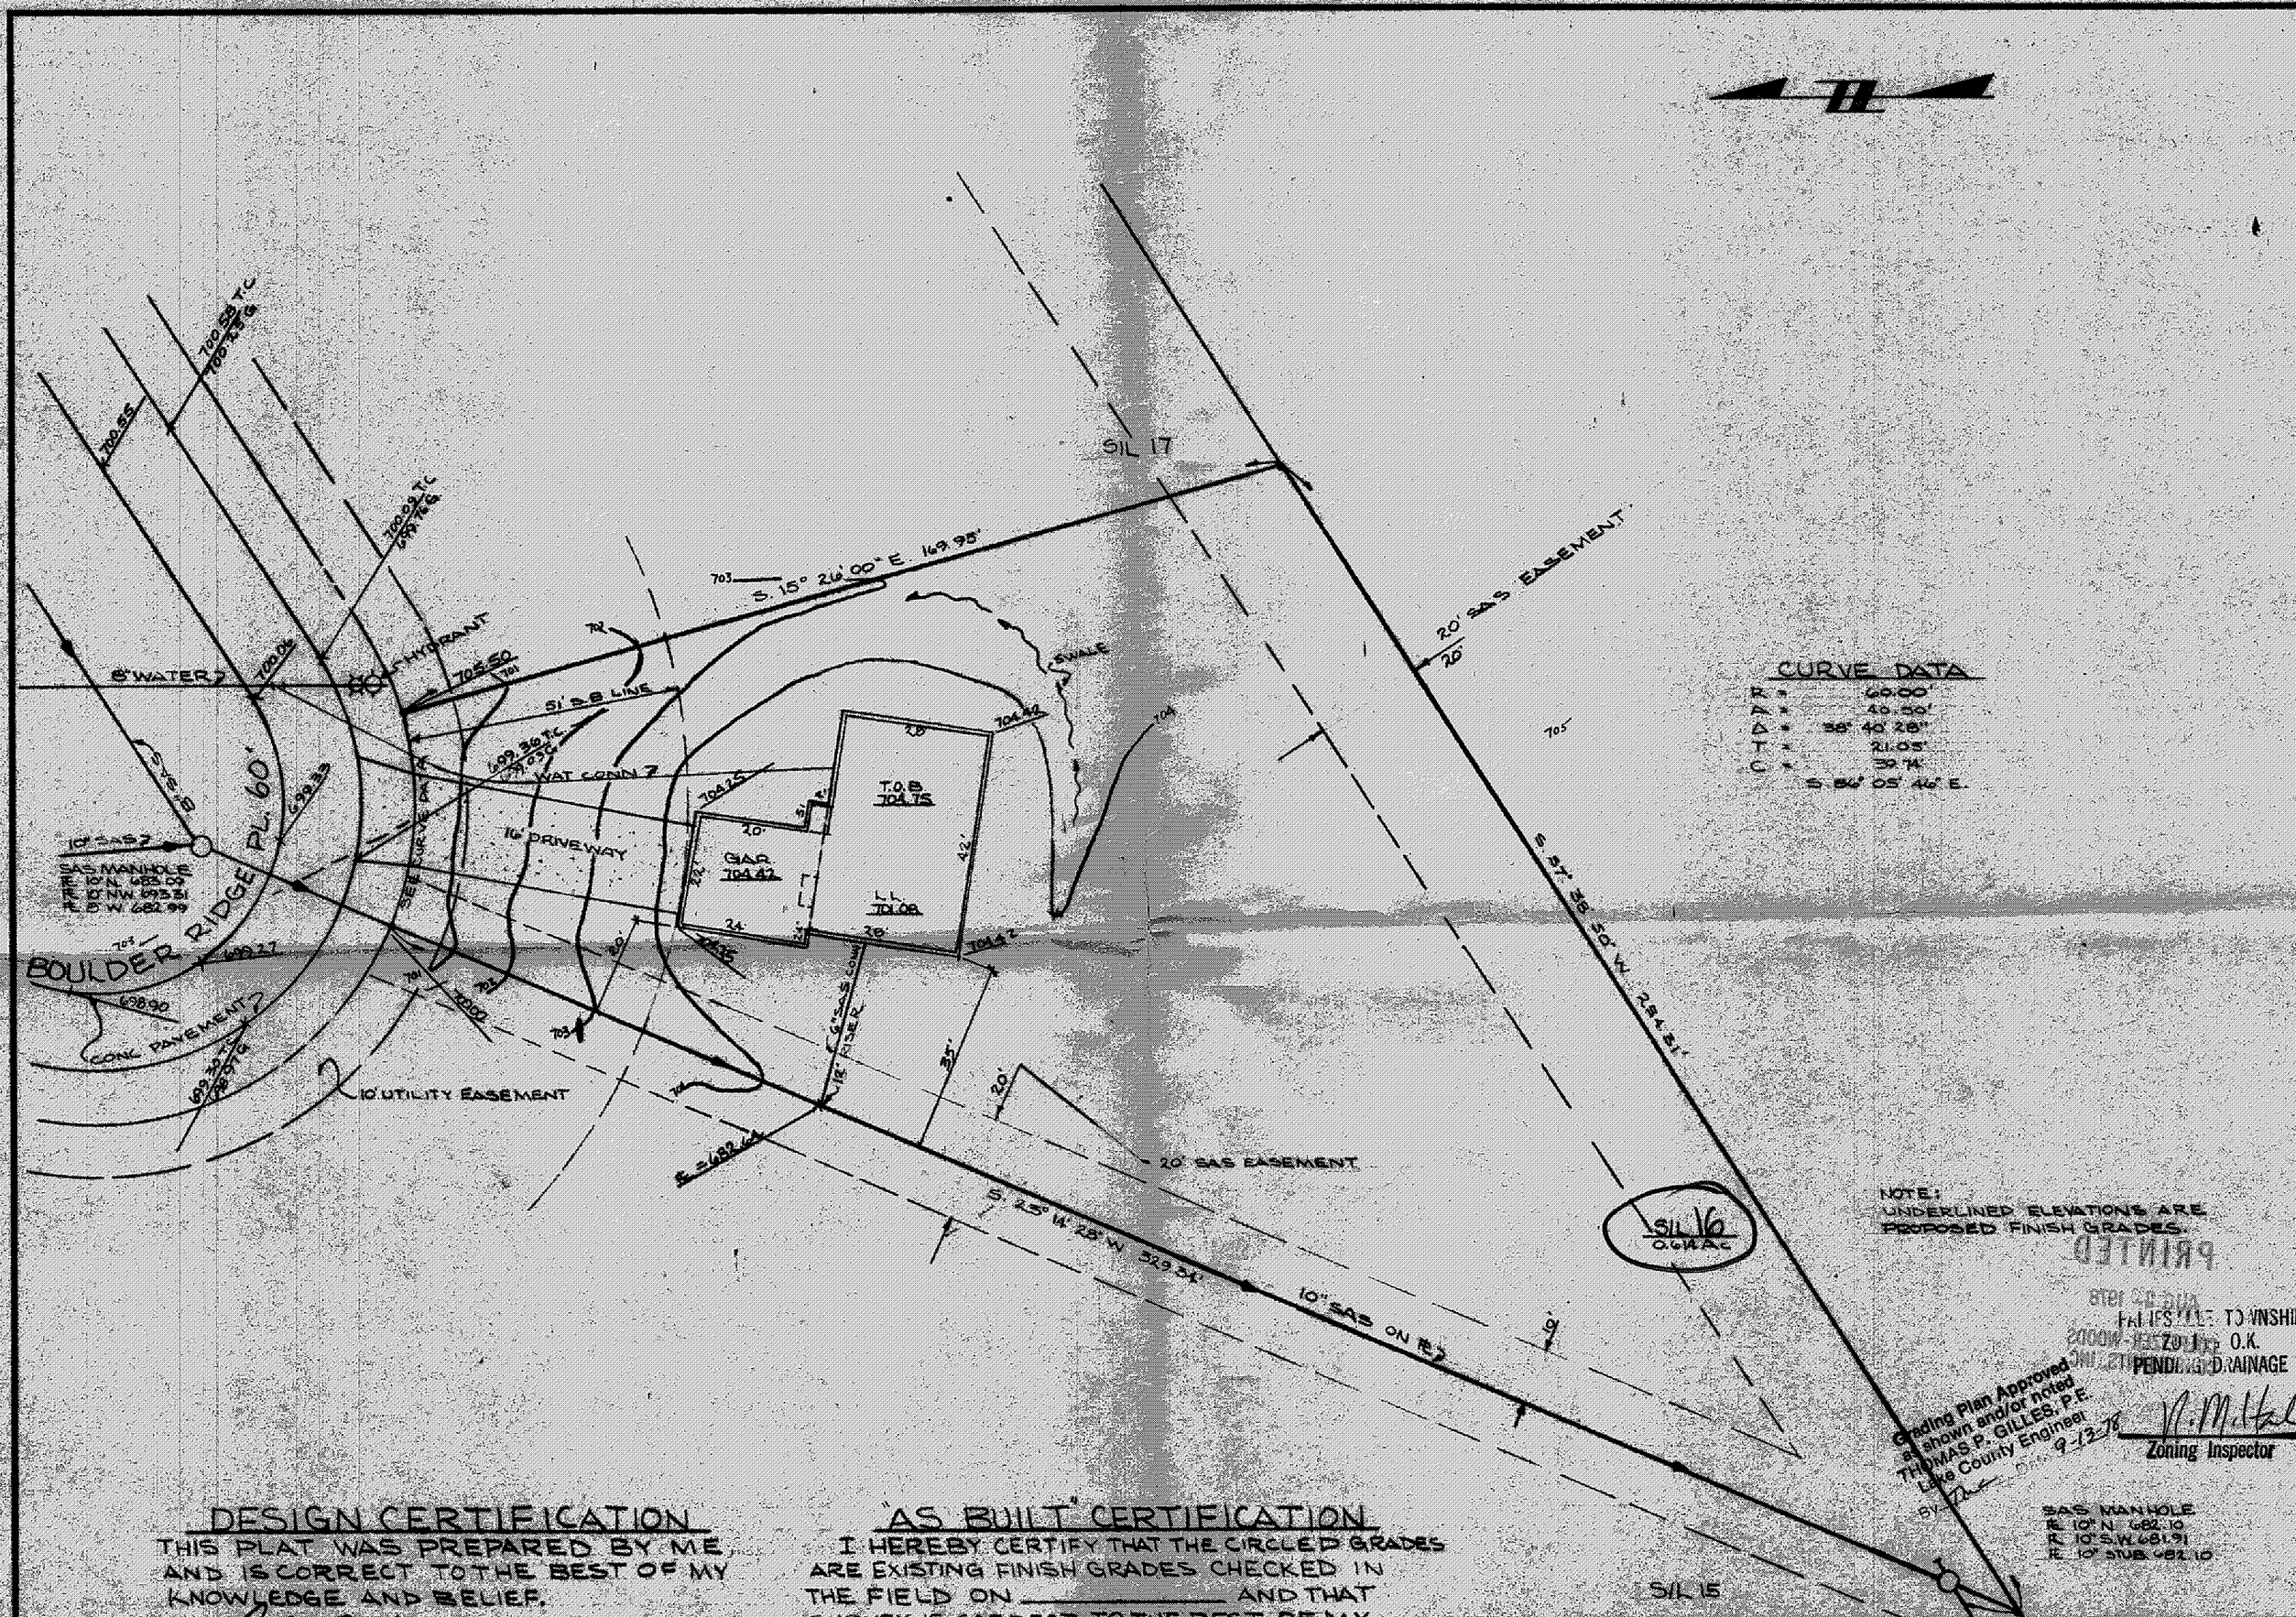

CURVE DATA

R =	60.00'
A =	40.50'
Δ =	38° 40' 28"
T =	21.05'
C =	39.74'
	S. 86° 05' 46" E.

NOTE:
UNDERLINED ELEVATIONS ARE PROPOSED FINISH GRADES.

PRINTED
AUG 2 1978
PAINESVILLE TOWNSHIP
ZONING O.K.
PENDING DRAINAGE

Grading Plan Approved as shown and/or noted
THOMAS P. GILLES, P.E.
Lake County Engineer
BY [signature] DATE 9-13-78

[signature]
Zoning Inspector

DESIGN CERTIFICATION

THIS PLAT WAS PREPARED BY ME AND IS CORRECT TO THE BEST OF MY KNOWLEDGE AND BELIEF.

[signature]

REG. SURVEYOR NO. 4785

"AS BUILT" CERTIFICATION

I HEREBY CERTIFY THAT THE CIRCLED GRADES ARE EXISTING FINISH GRADES CHECKED IN THE FIELD ON _____ AND THAT SURVEY IS CORRECT TO THE BEST OF MY KNOWLEDGE AND BELIEF.

_____

REG. SURVEYOR NO. _____

NOTE: SEE APPROVED GRADING PLAN ON FILE WITH THE COUNTY ENGINEER.

GRADING PLAN FOR:

CASEMENT HOMES

1251 MADISON AVENUE PAINESVILLE OHIO
BEING S/L 16 BOULDER RIDGE SUBDIVISION, PAINES TWP. LAKE CO. OHIO

DATE 21 AUG 78
SCALE 1" = 20'
DRAWN BY KAL
CHK'D BY
P.B.F. — PG. —

COLPETZER · WOODS
CONSULTANTS, INC.
MENTOR, OHIO 44060

SHEET 1
CONTRACT 78