OFFICE: 354-4100 REB.: 354-8908

PAINESVILLE TOWNSHIP
ZONING APPROVED
#3462 6-12-74
*note change
J. A. Henderson
Zoning Inspector

JOSEPH D. HADDEN
Registered Surveyor
130 E. JACKSON STREET
PAINESVILLE, OHIO 44077

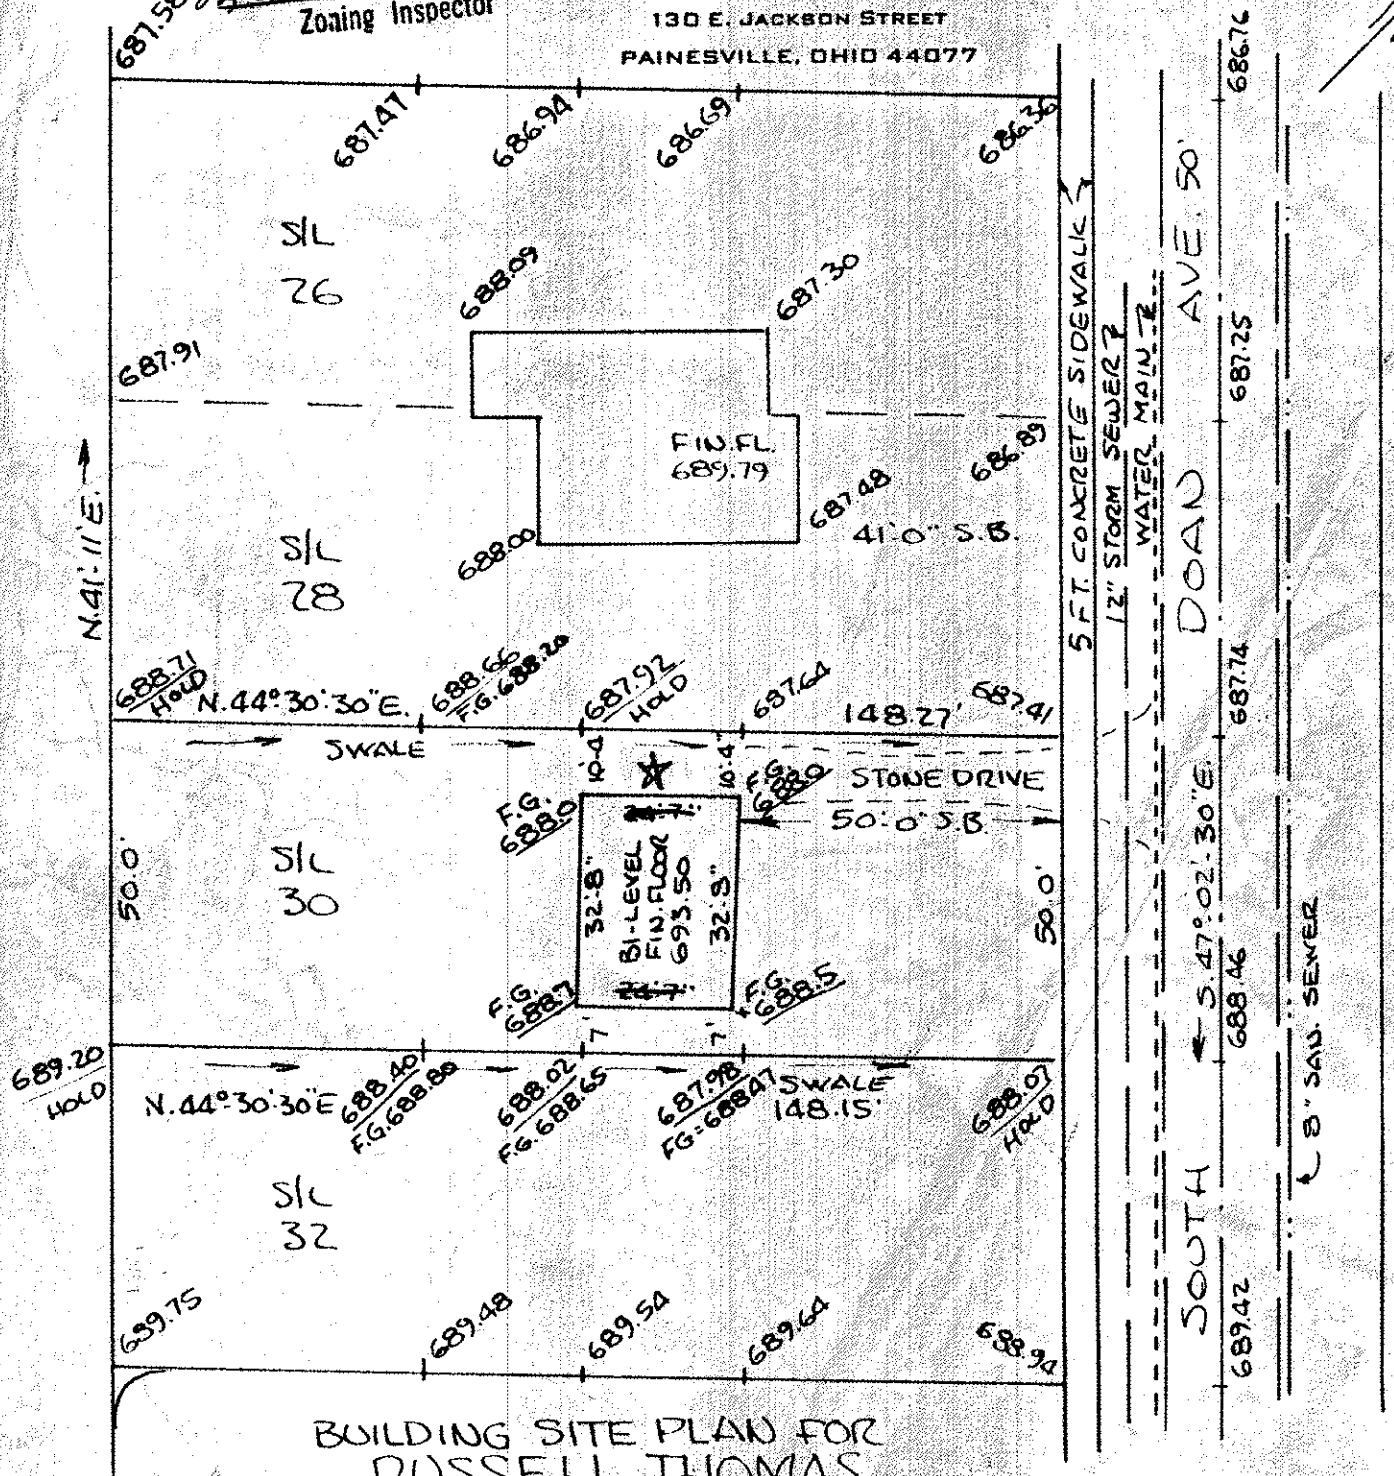

BUILDING SITE PLAN FOR
RUSSELL THOMAS
SUBLOT No. 30 - STANLEY ROAD ALLOT.
PAINESVILLE TWP. - LAKE COUNTY - OHIO
Scale 1" = 30' JUNE 10, 1974
Joseph D. Hadden - Reg. Surveyor

Grading Plan Approved S/L 30
as shown and/or noted
THOMAS P. GILLES, P.E.
Lake County Engineer

By JWK Date 6-12-74