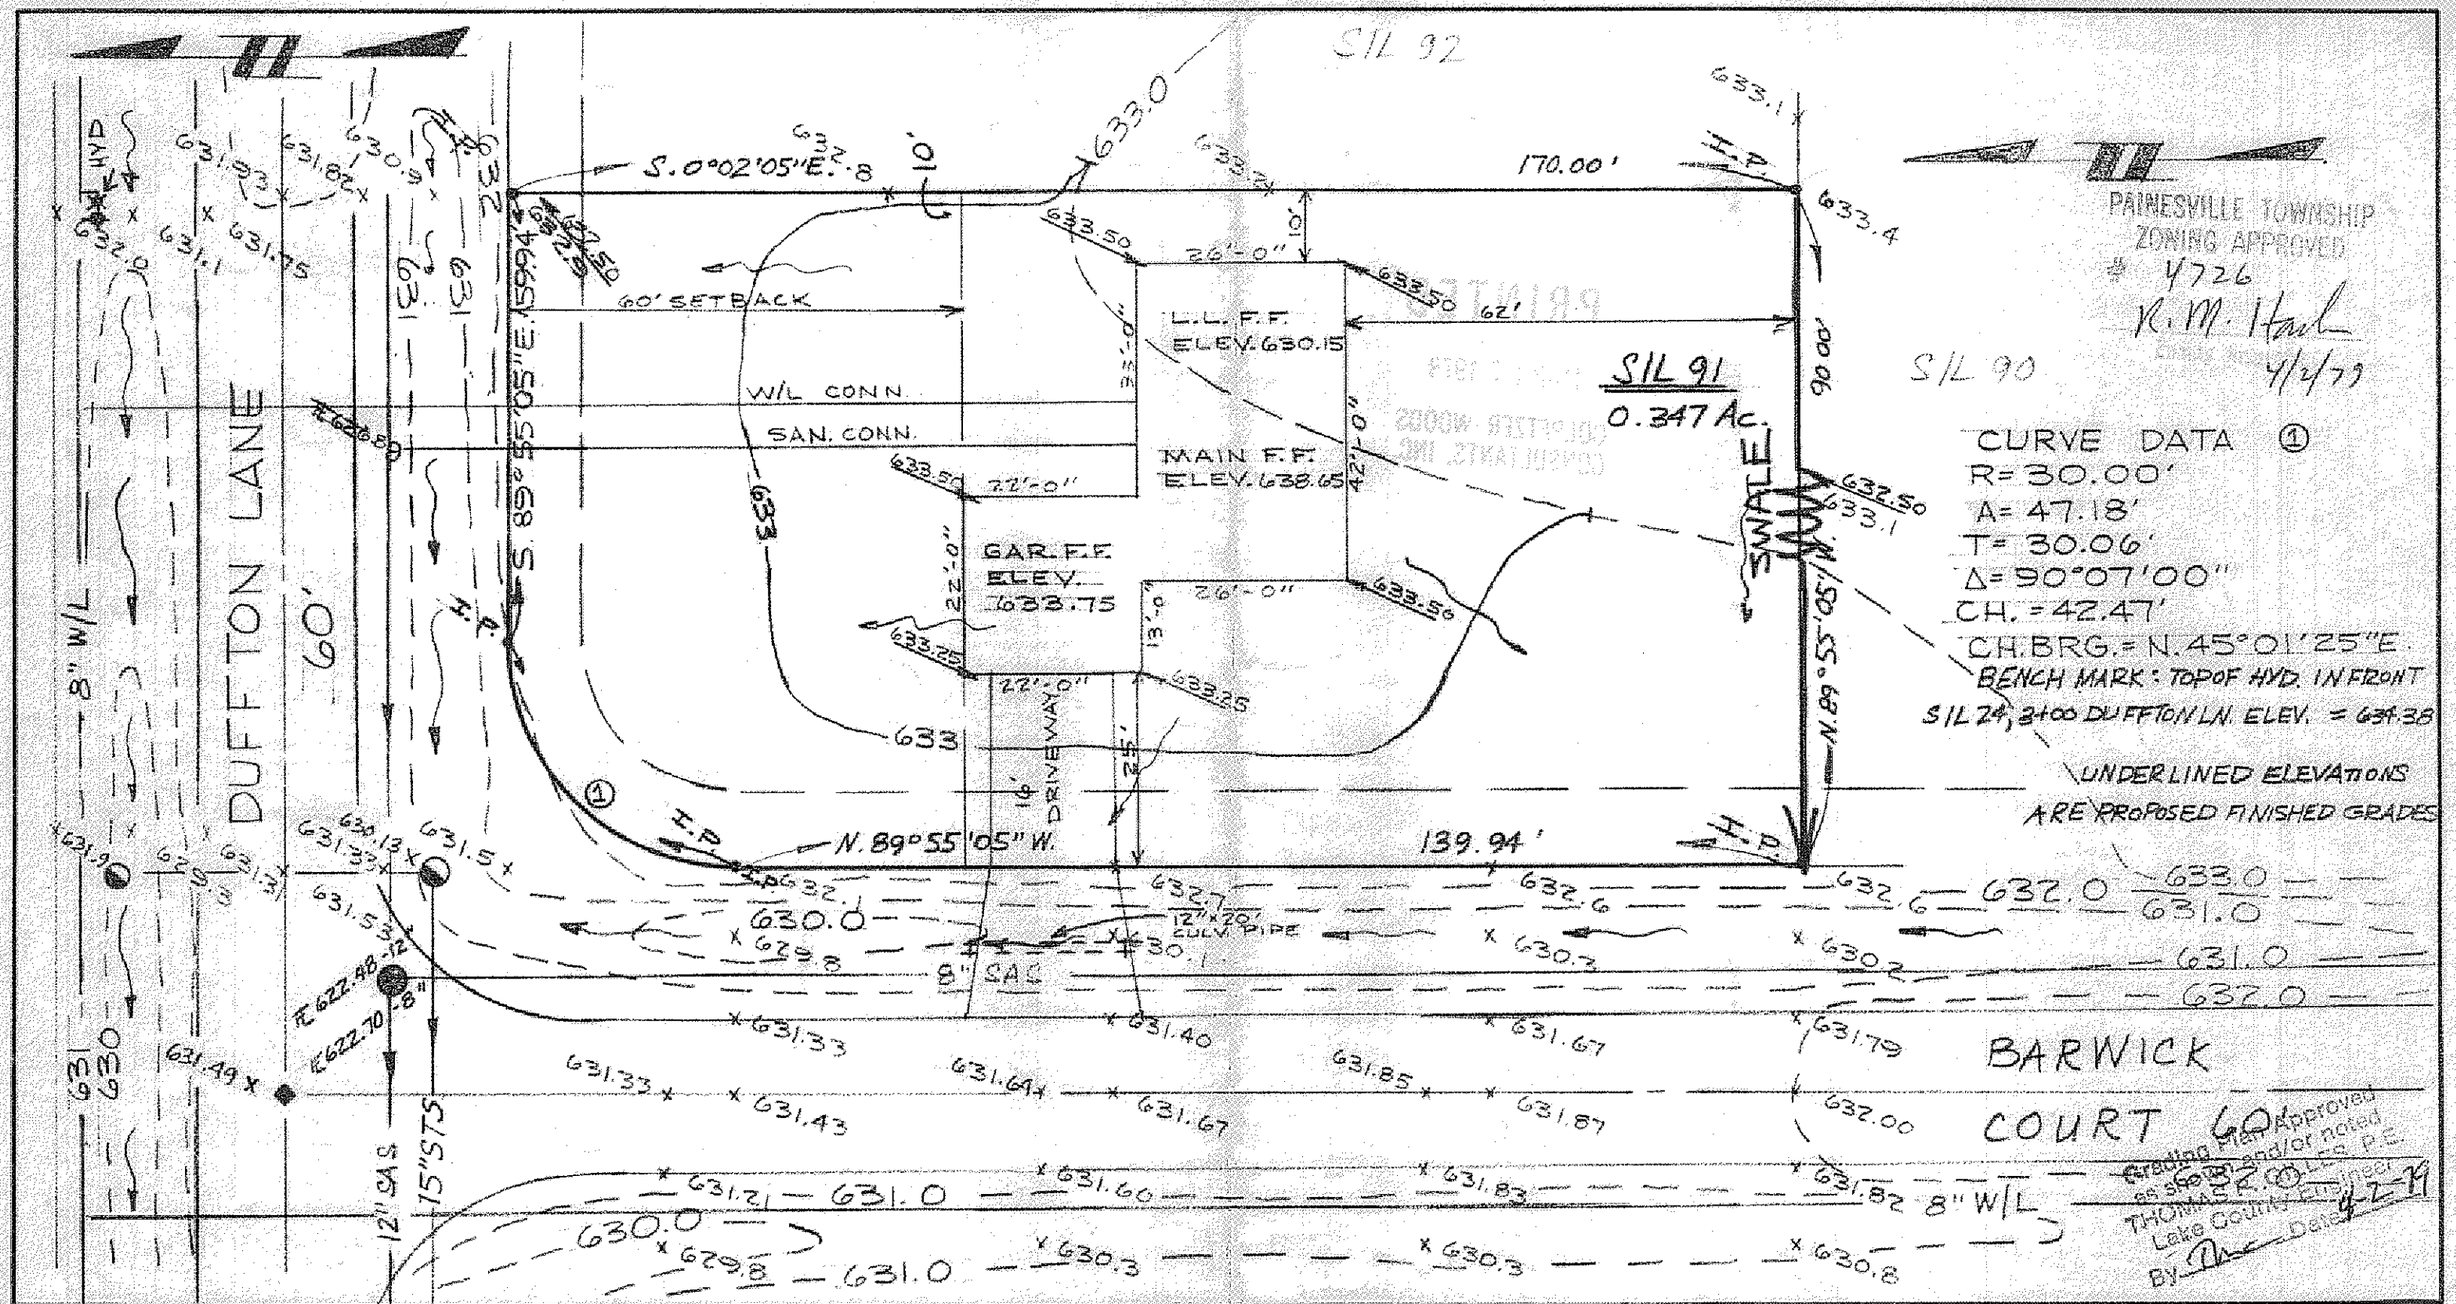

DESIGN CERTIFICATION

THIS PLAT WAS PREPARED BY ME, AND IS CORRECT TO THE BEST OF MY KNOWLEDGE AND BELIEF.

REG. SURVEYOR NO. 4785

AS BUILT CERTIFICATION

I HEREBY CERTIFY THAT THE CIRCLED GRADES ARE EXISTING FINISH GRADES CHECKED IN THE FIELD ON _____ AND THAT SURVEY IS CORRECT TO THE BEST OF MY KNOWLEDGE AND BELIEF.

REG. SURVEYOR NO. _____

COLPETZER · WOODS
CONSULTANTS, INC.

DATE 3/13/79
SCALE 1" = 20'
DRWN BY D.E.
CHKD BY [illegible]
JOB NO. 78/156
FB 232-A PG

SITE PLAN FOR
EDWARD H. TRESGER INC.
8100 DEEPWOOD BLVD. MENTOR OHIO. S/L #91 IN THE PINES SUBD. NO. 2. PAINESVILLE, OHIO