SITE PLAN

— FOR —

R.C. REED CONSTRUCTION

KNOWN AS BEING SUBLOT NO. 145 IN HEATHERSTONE VILLAGE SUBDIVISION NO. 1 AND BEING A PART OF ORIGINAL LOT NO'S 21, 28, AND 29 IN TRACT NO. 1. AND SITUATED IN THE TOWNSHIP OF PAINESVILLE, COUNTY OF LAKE, AND THE STATE OF OHIO.

SCALE: 1" = 20'

ALL BEARINGS SHOWN HEREON ARE TO AN ASSUMED MERIDAN AND ARE USED TO DENOTE ANGLES ONLY.

EXISTING / PROPOSED

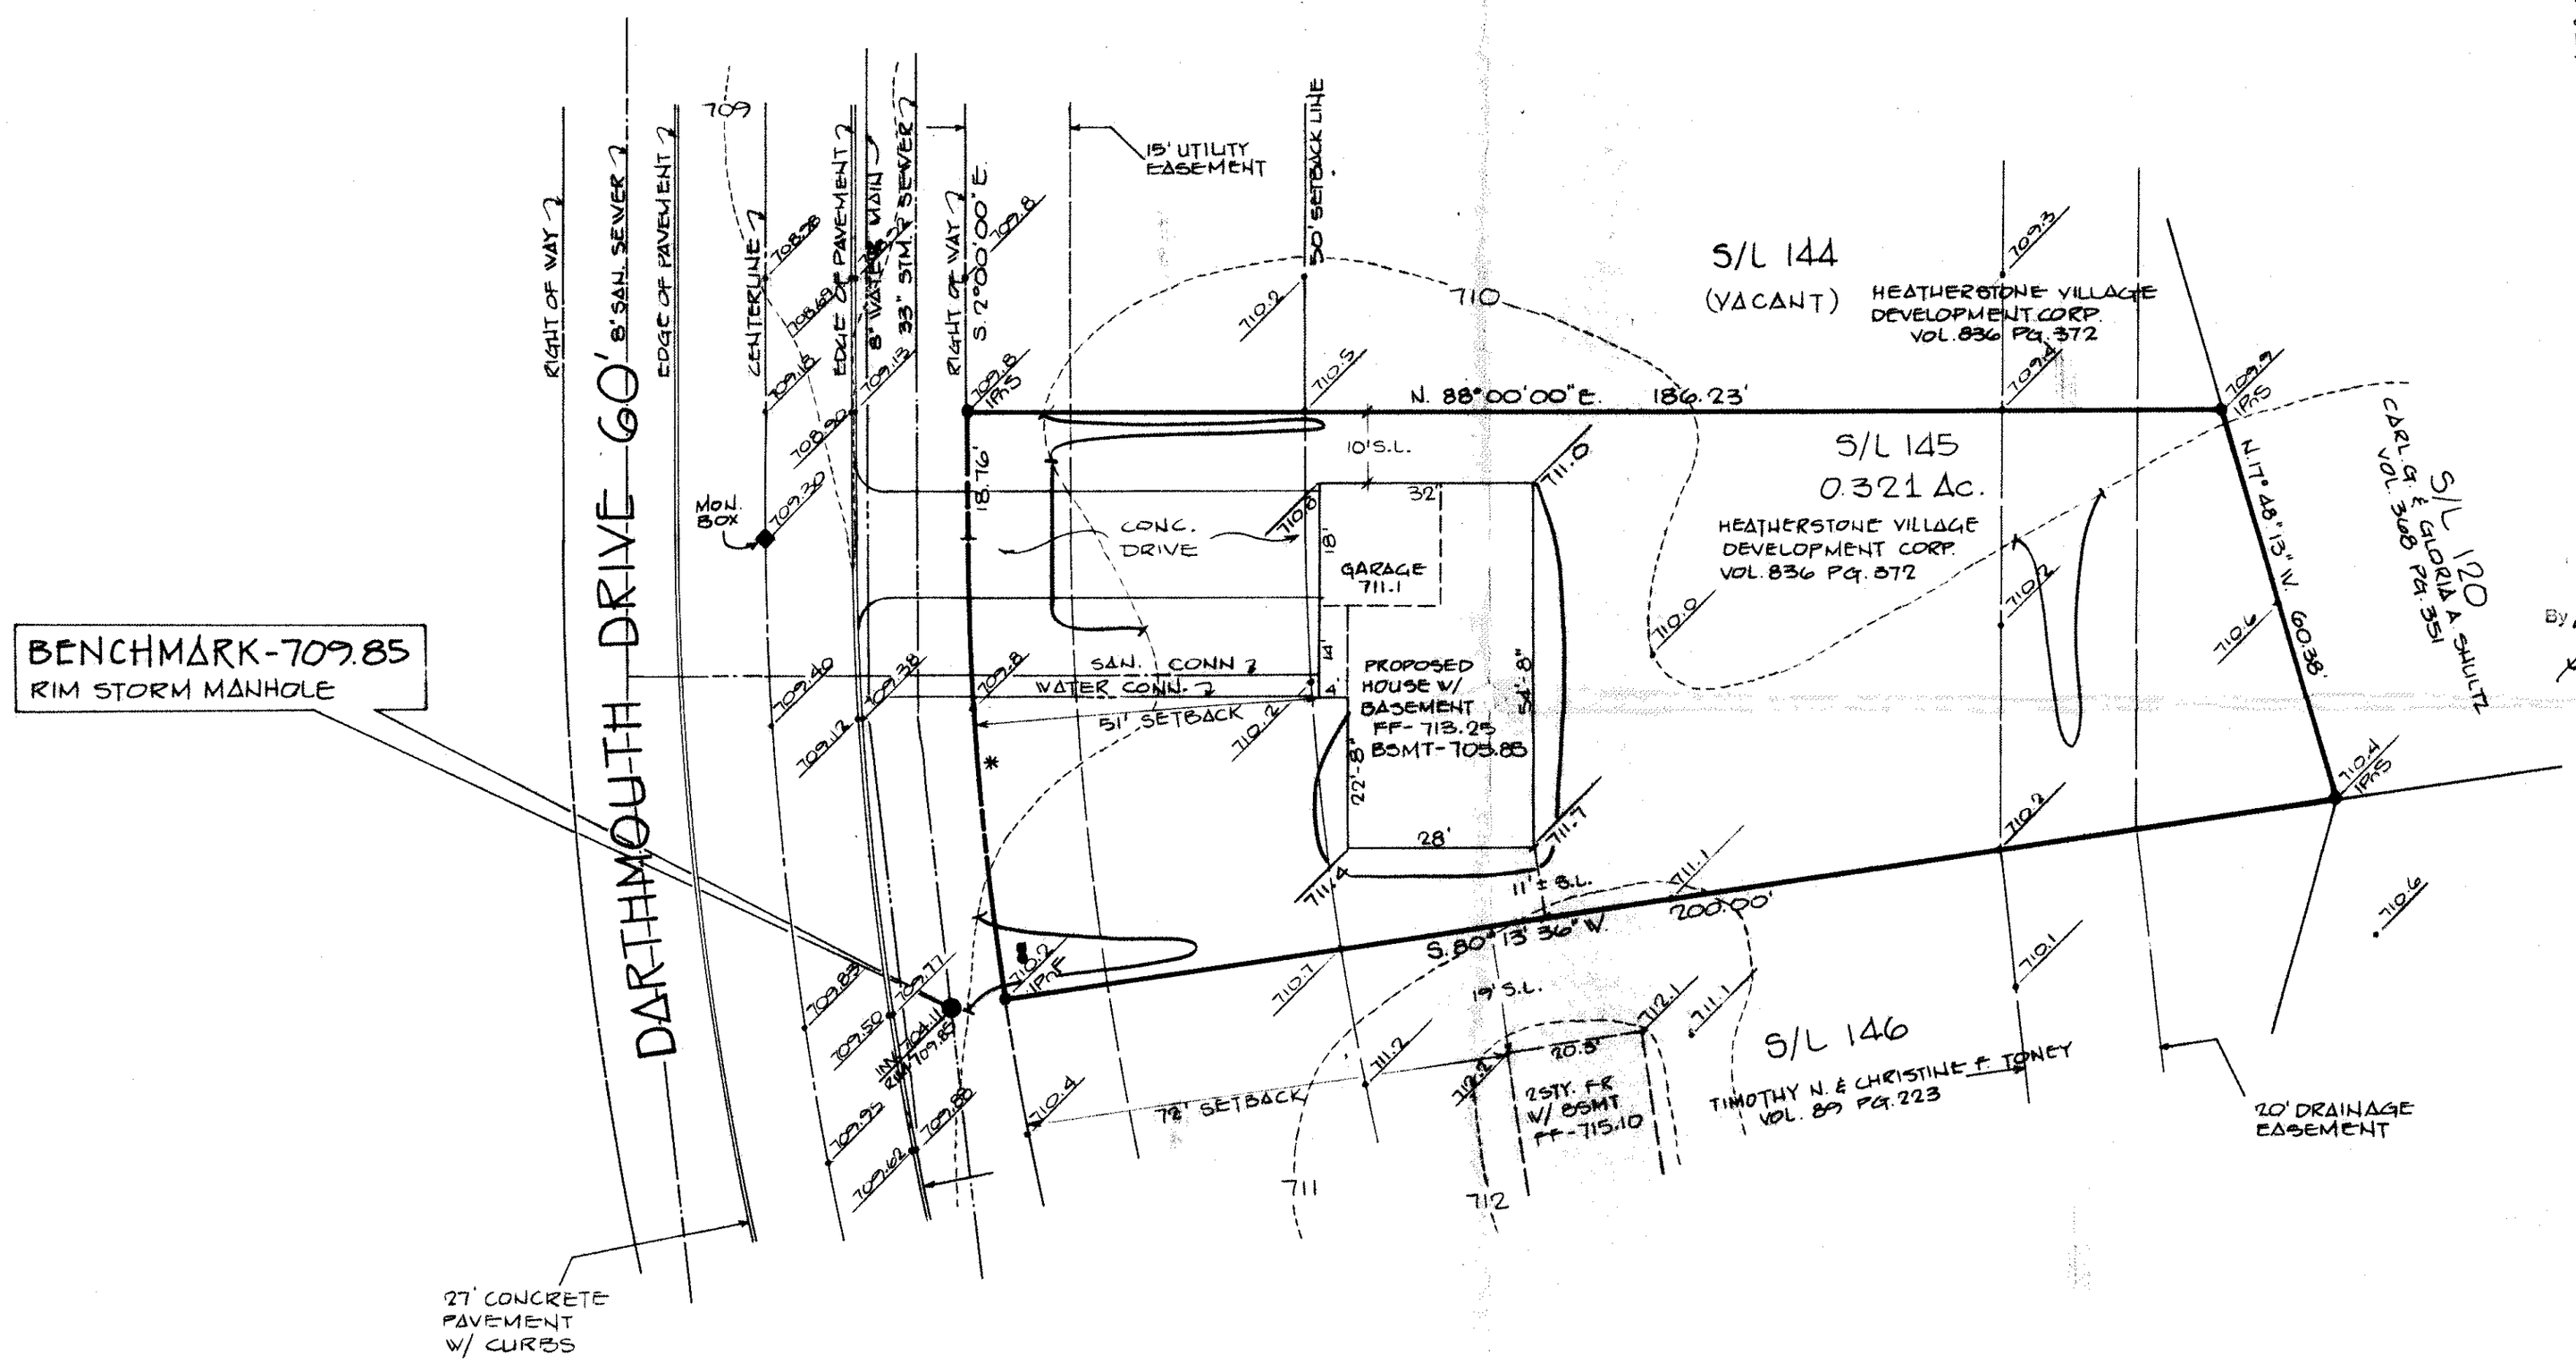

Grading Plan Approved
as shown and/or noted
THOMAS P. GILLES, P.E.
Lake County Engineer
By [signature] Date 4/1/94
Sump pump required.

This Permit Expires
6-1-89
PAINESVILLE TOWNSHIP
ZONING APPROVED
6972
Willis E. Meaux
Zoning Inspector 6/1/94

STATE OF OHIO
THOMAS MARC COFFMAN
6857
REGISTERED
SURVEYOR

CURVE DATA	
RADIUS	490.87'
ARC	66.60'
CHORD	66.54'
DELTA	7°46'24"
CHD. BRG.	N.5°53'12" W.

VILLAGE SURVEYING CO.
THOMAS M. COFFMAN, P.S.
202 THIRD STREET, FAIRPORT HARBOR, OHIO 44077
(216) 357-1359

THIS PLAT WAS PREPARED BY ME AND IS TRUE AND ACCURATE TO THE BEST OF MY KNOWLEDGE AND BELIEF.

Thomas M. Coffman P.S.
THOMAS M. COFFMAN NO. 6857