STATE OF OHIO
STEVEN N. ROESSNER
S-7070
REGISTERED
PROFESSIONAL SURVEYOR

The topography, indicated by 1' contours, and elevations shown hereon represent an actual field survey made by me on February 26, 1996 The elevations were taken at appropriate intervals and as of the above date they existed as indicated hereon.

Steven N Roessner 6/10/96
Steven N. Roessner No.7070
Foresight Engineering Group, Inc.

APPROVED
PAINESVILLE TOWNSHIP
ZONING DEPARTMENT
96-06-30

Foresight Engineering

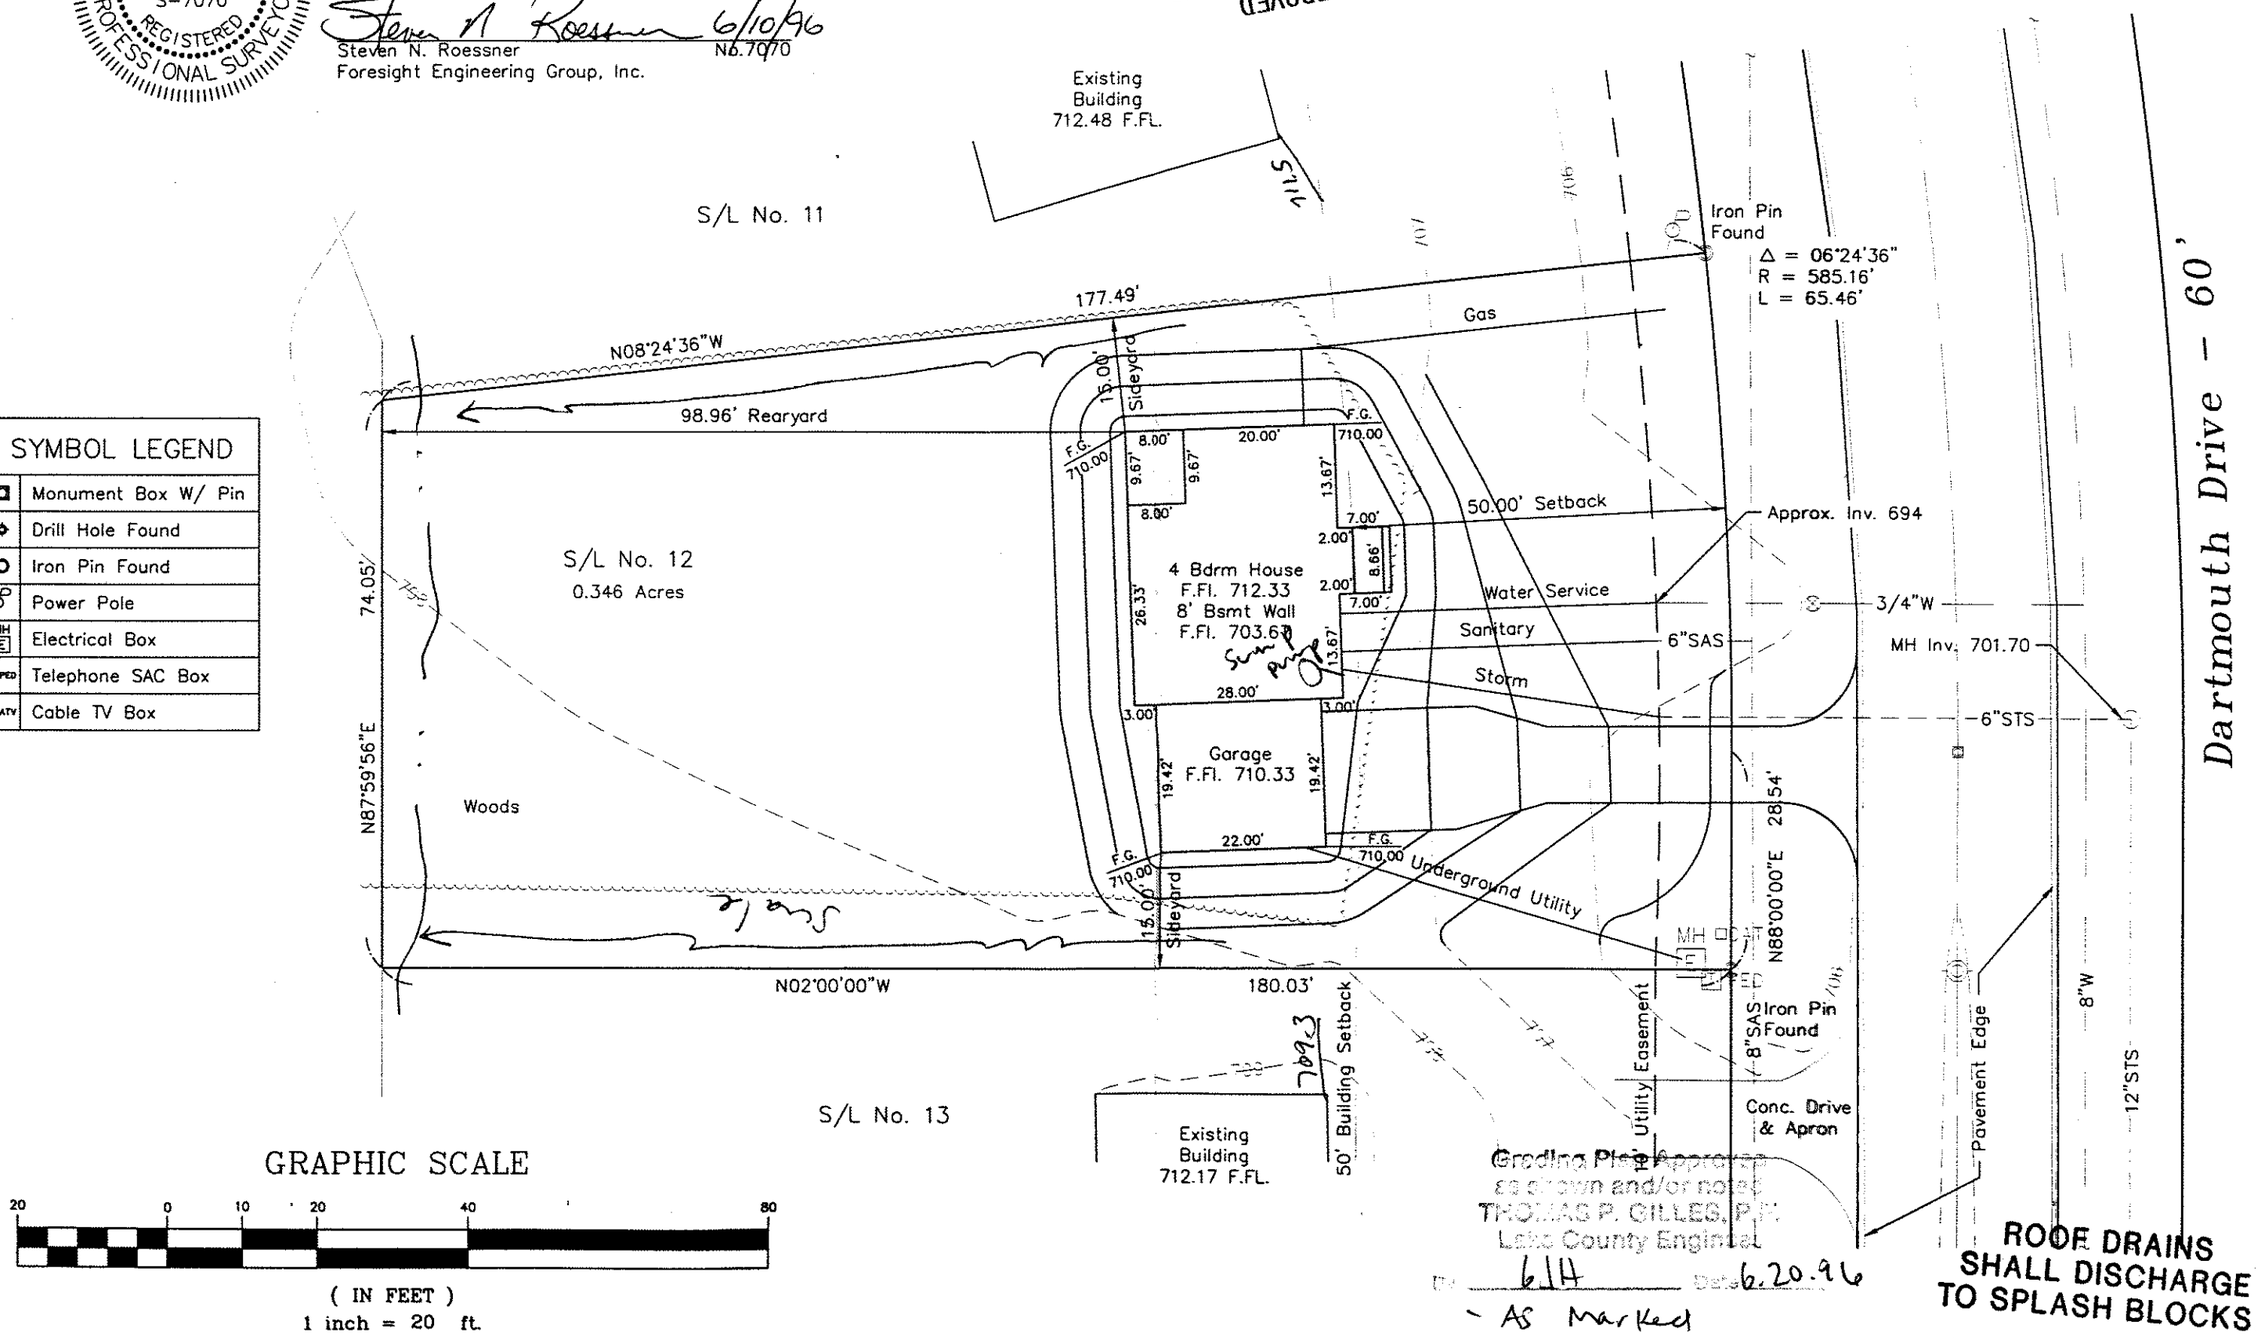

SYMBOL LEGEND	
	Monument Box W/ Pin
	Drill Hole Found
	Iron Pin Found
	Power Pole
	Electrical Box
	Telephone SAC Box
	Cable TV Box

GRAPHIC SCALE

20 0 10 20 40 80

(IN FEET)
1 inch = 20 ft.

Grading Plan Approved as shown and/or noted
THOMAS P. GILLES, P.E.
Lake County Engineer
By 6/H Date 6.20.96
- AS Marked

ROOF DRAINS SHALL DISCHARGE TO SPLASH BLOCKS.

Foresight Engineering Group
Engineers & Surveyors

SCALE : Horz. 1"=20' Vert. NONE
FILE NAME: I:\DEC19606\SL-12
DATE : June 10, 1996
REVISIONS:

Heatherstone Village Subdivision No. 2
Phase No. 2 - S/L No. 12
Painesville Twp. - Lake County - Ohio
Site Plan

SHEET NO.
1/1