SITE PLAN
FOR
R. C. REED CONSTRUCTION

BEING SUBLOT No. 34, IN THE HEATHERSTONE VILLAGE SUB'D No. 2, PHASE 2, IN THE TOWNSHIP OF PAINESVILLE, COUNTY OF LAKE, STATE OF OHIO.
*NOTE: BEARINGS PER RECORD DEED & MONUMENTATION FOUND

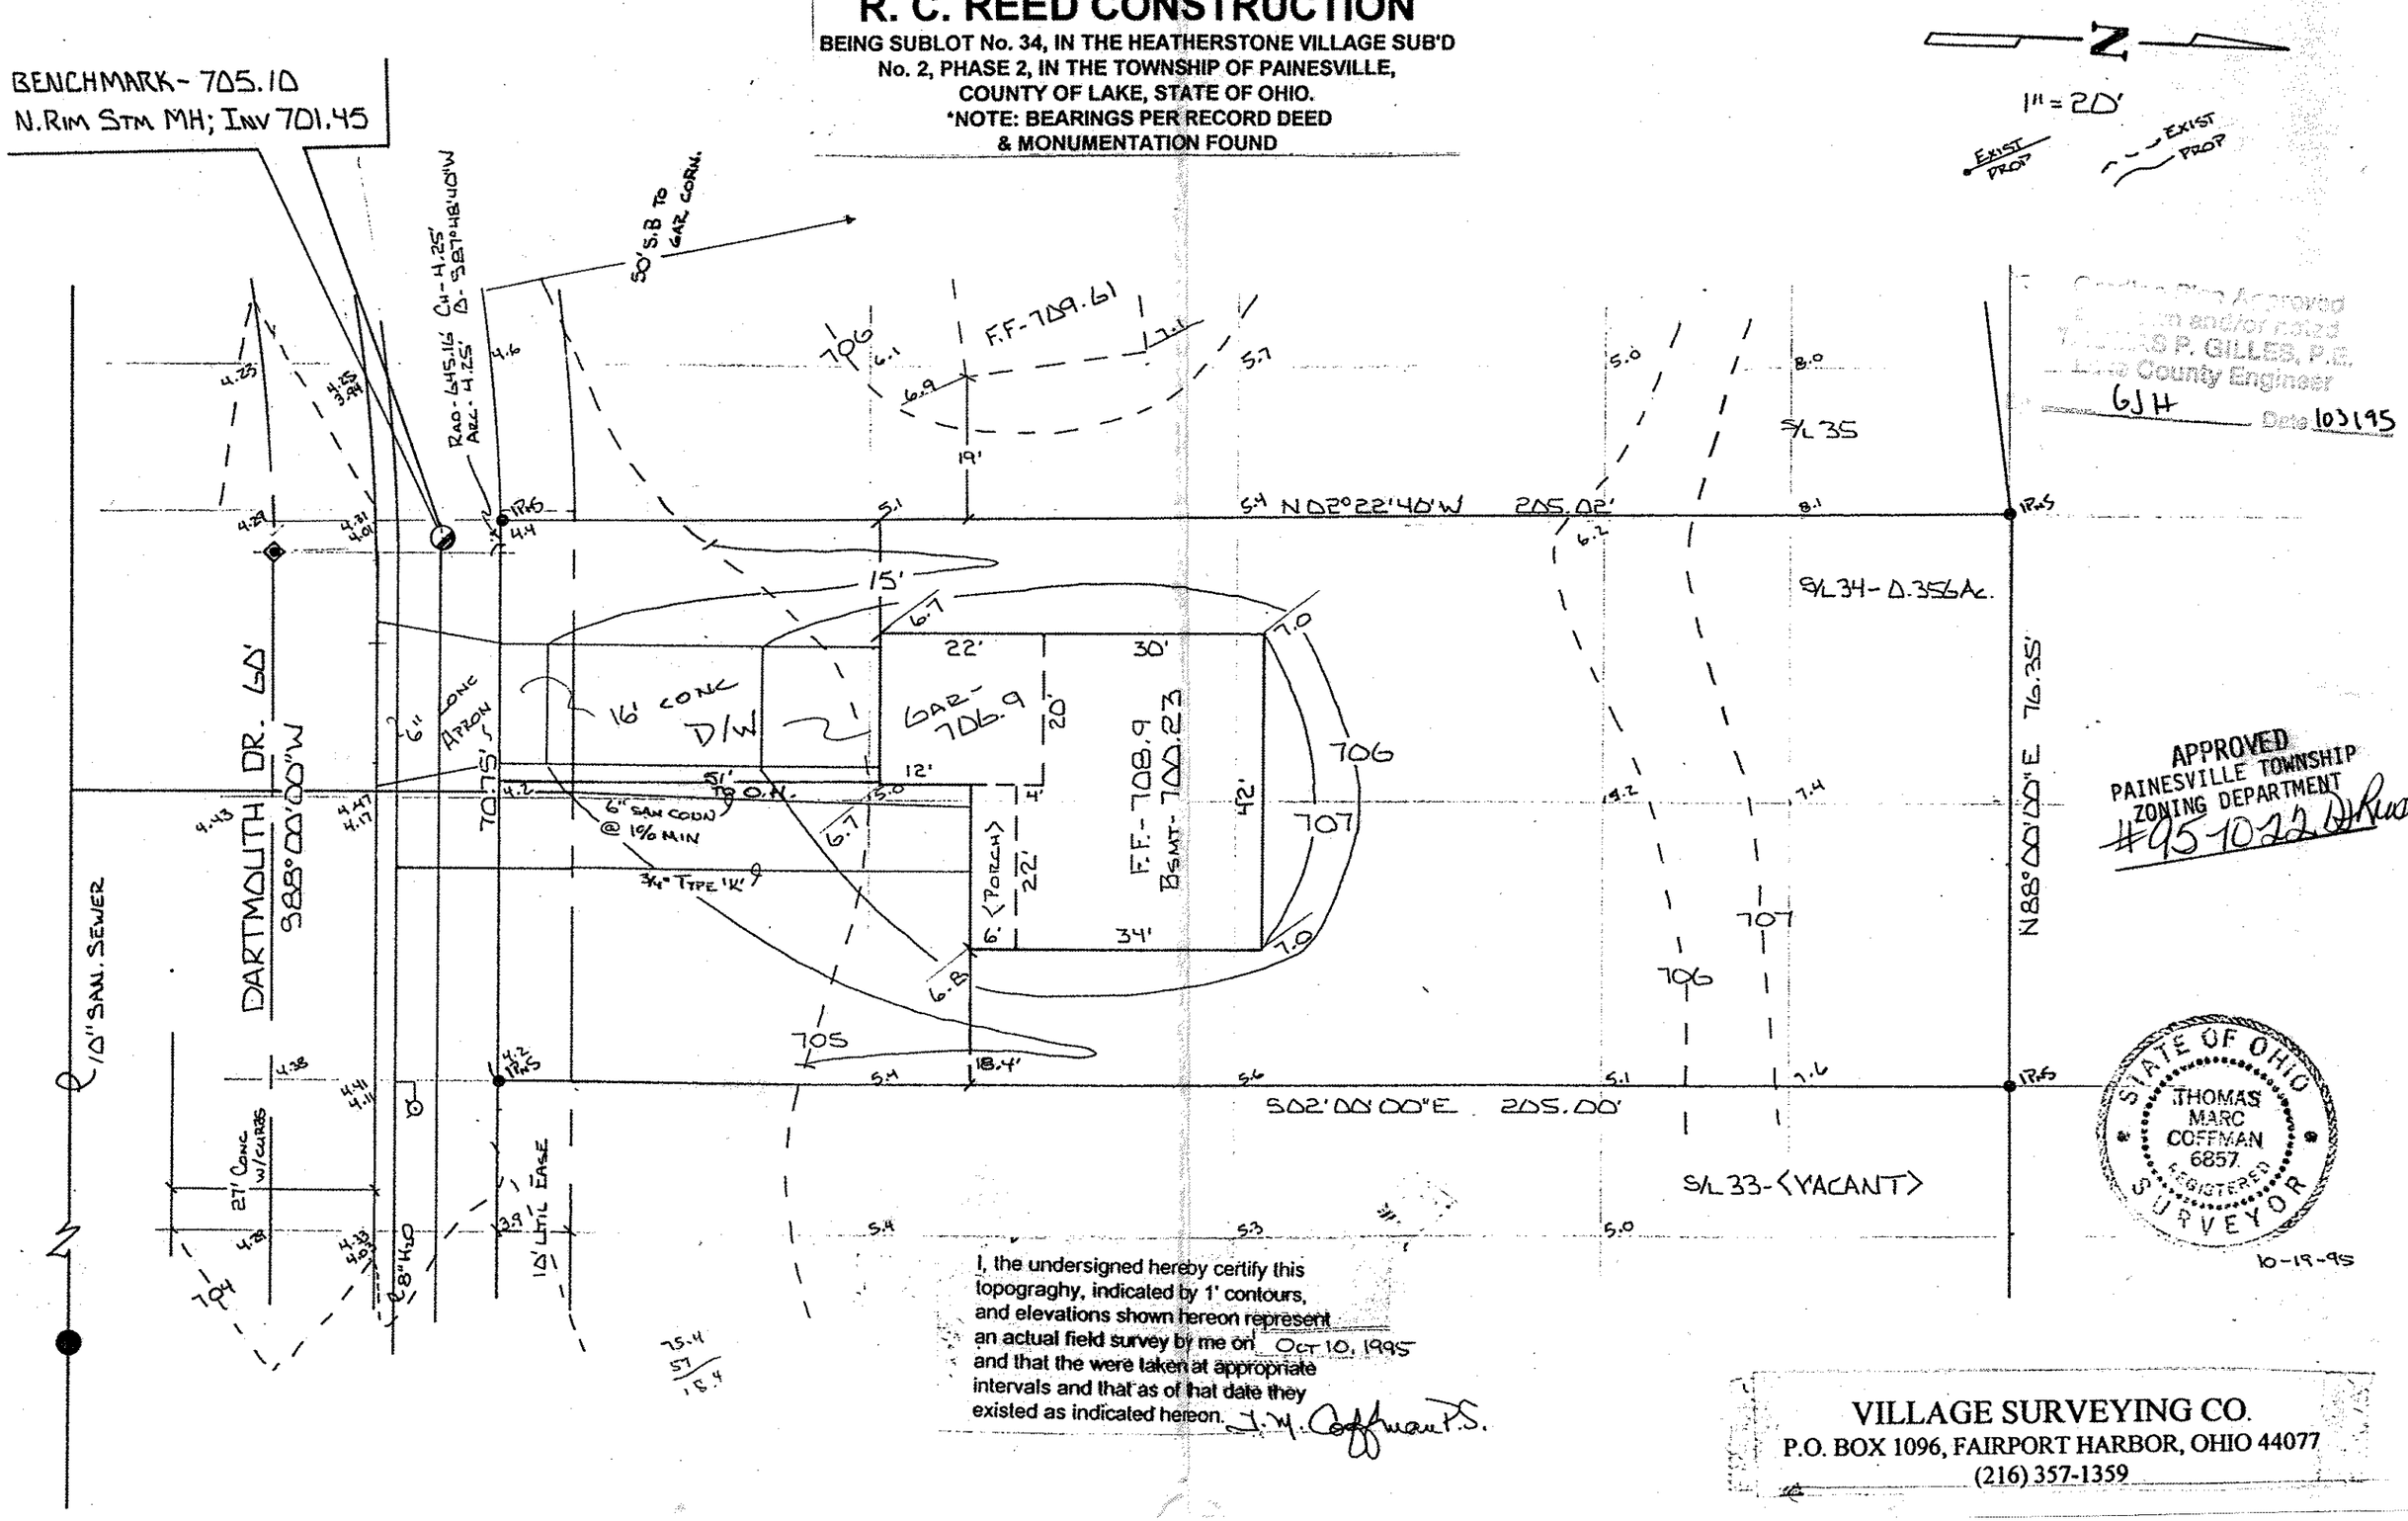

I, the undersigned hereby certify this topograghy, indicated by 1' contours, and elevations shown hereon represent an actual field survey by me on Oct 10, 1995 and that the were taken at appropriate intervals and that as of hat date they existed as indicated hereon. T.M. Coffman P.S.

VILLAGE SURVEYING CO.
P.O. BOX 1096, FAIRPORT HARBOR, OHIO 44077
(216) 357-1359