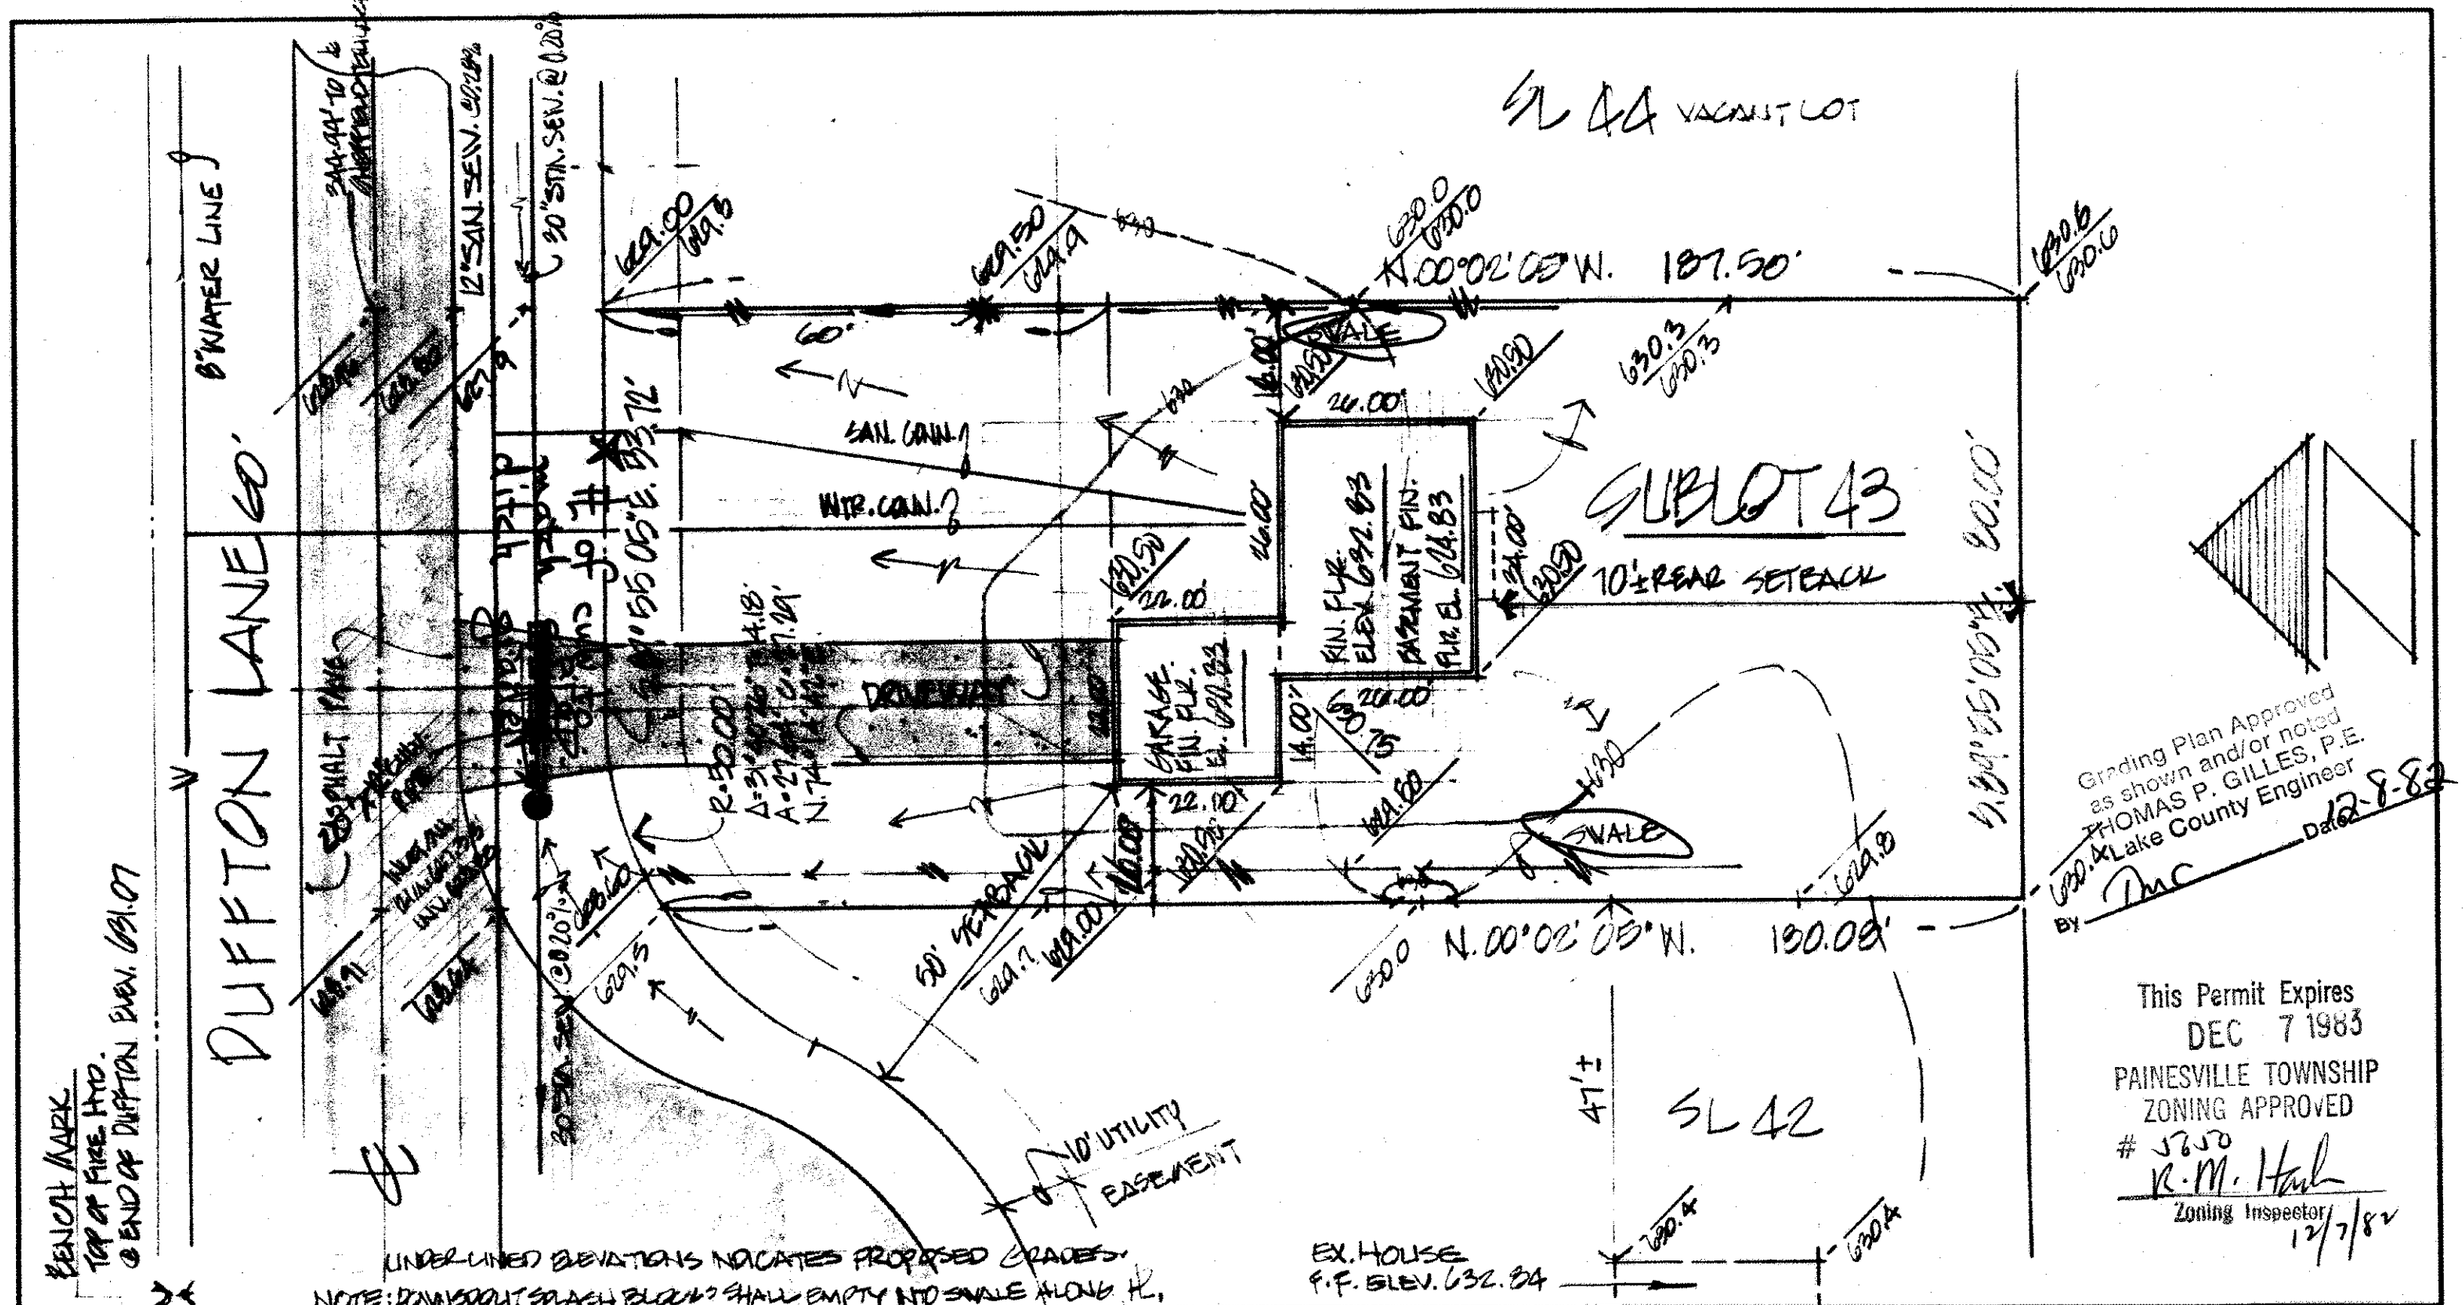

DESIGN CERTIFICATION

THIS PLAT WAS PREPARED BY ME, AND IS CORRECT TO THE BEST OF MY KNOWLEDGE AND BELIEF.

REG. SURVEYOR NO 4785

AS BUILT CERTIFICATION

I HEREBY CERTIFY THAT THE CIRCLED GRADES ARE EXISTING FINISH GRADES CHECKED IN THE FIELD ON _____ AND THAT SURVEY IS CORRECT TO THE BEST OF MY KNOWLEDGE AND BELIEF.

REG. SURVEYOR NO. _____

COLPETZER · WOODS
CONSULTANTS, INC.
9470 MENTOR AVENUE • MENTOR, OHIO 44066 • (216) 357-7569

DATE 11/4/82
SCALE 1" = 20'
DRWN BY CDB.
CHKD BY II
JOB NO 78-156043
FB 332-A PG

SITE PLAN FOR:
EDWARD H. TRESGER INC.
3100 DEERWOOD BLVD., MENTOR, OHIO
BEING SUBLOT NO. 43 IN THE PINES SUBDIVISION No. 2
IN THE TOWNSHIP OF PAINESVILLE, OHIO.