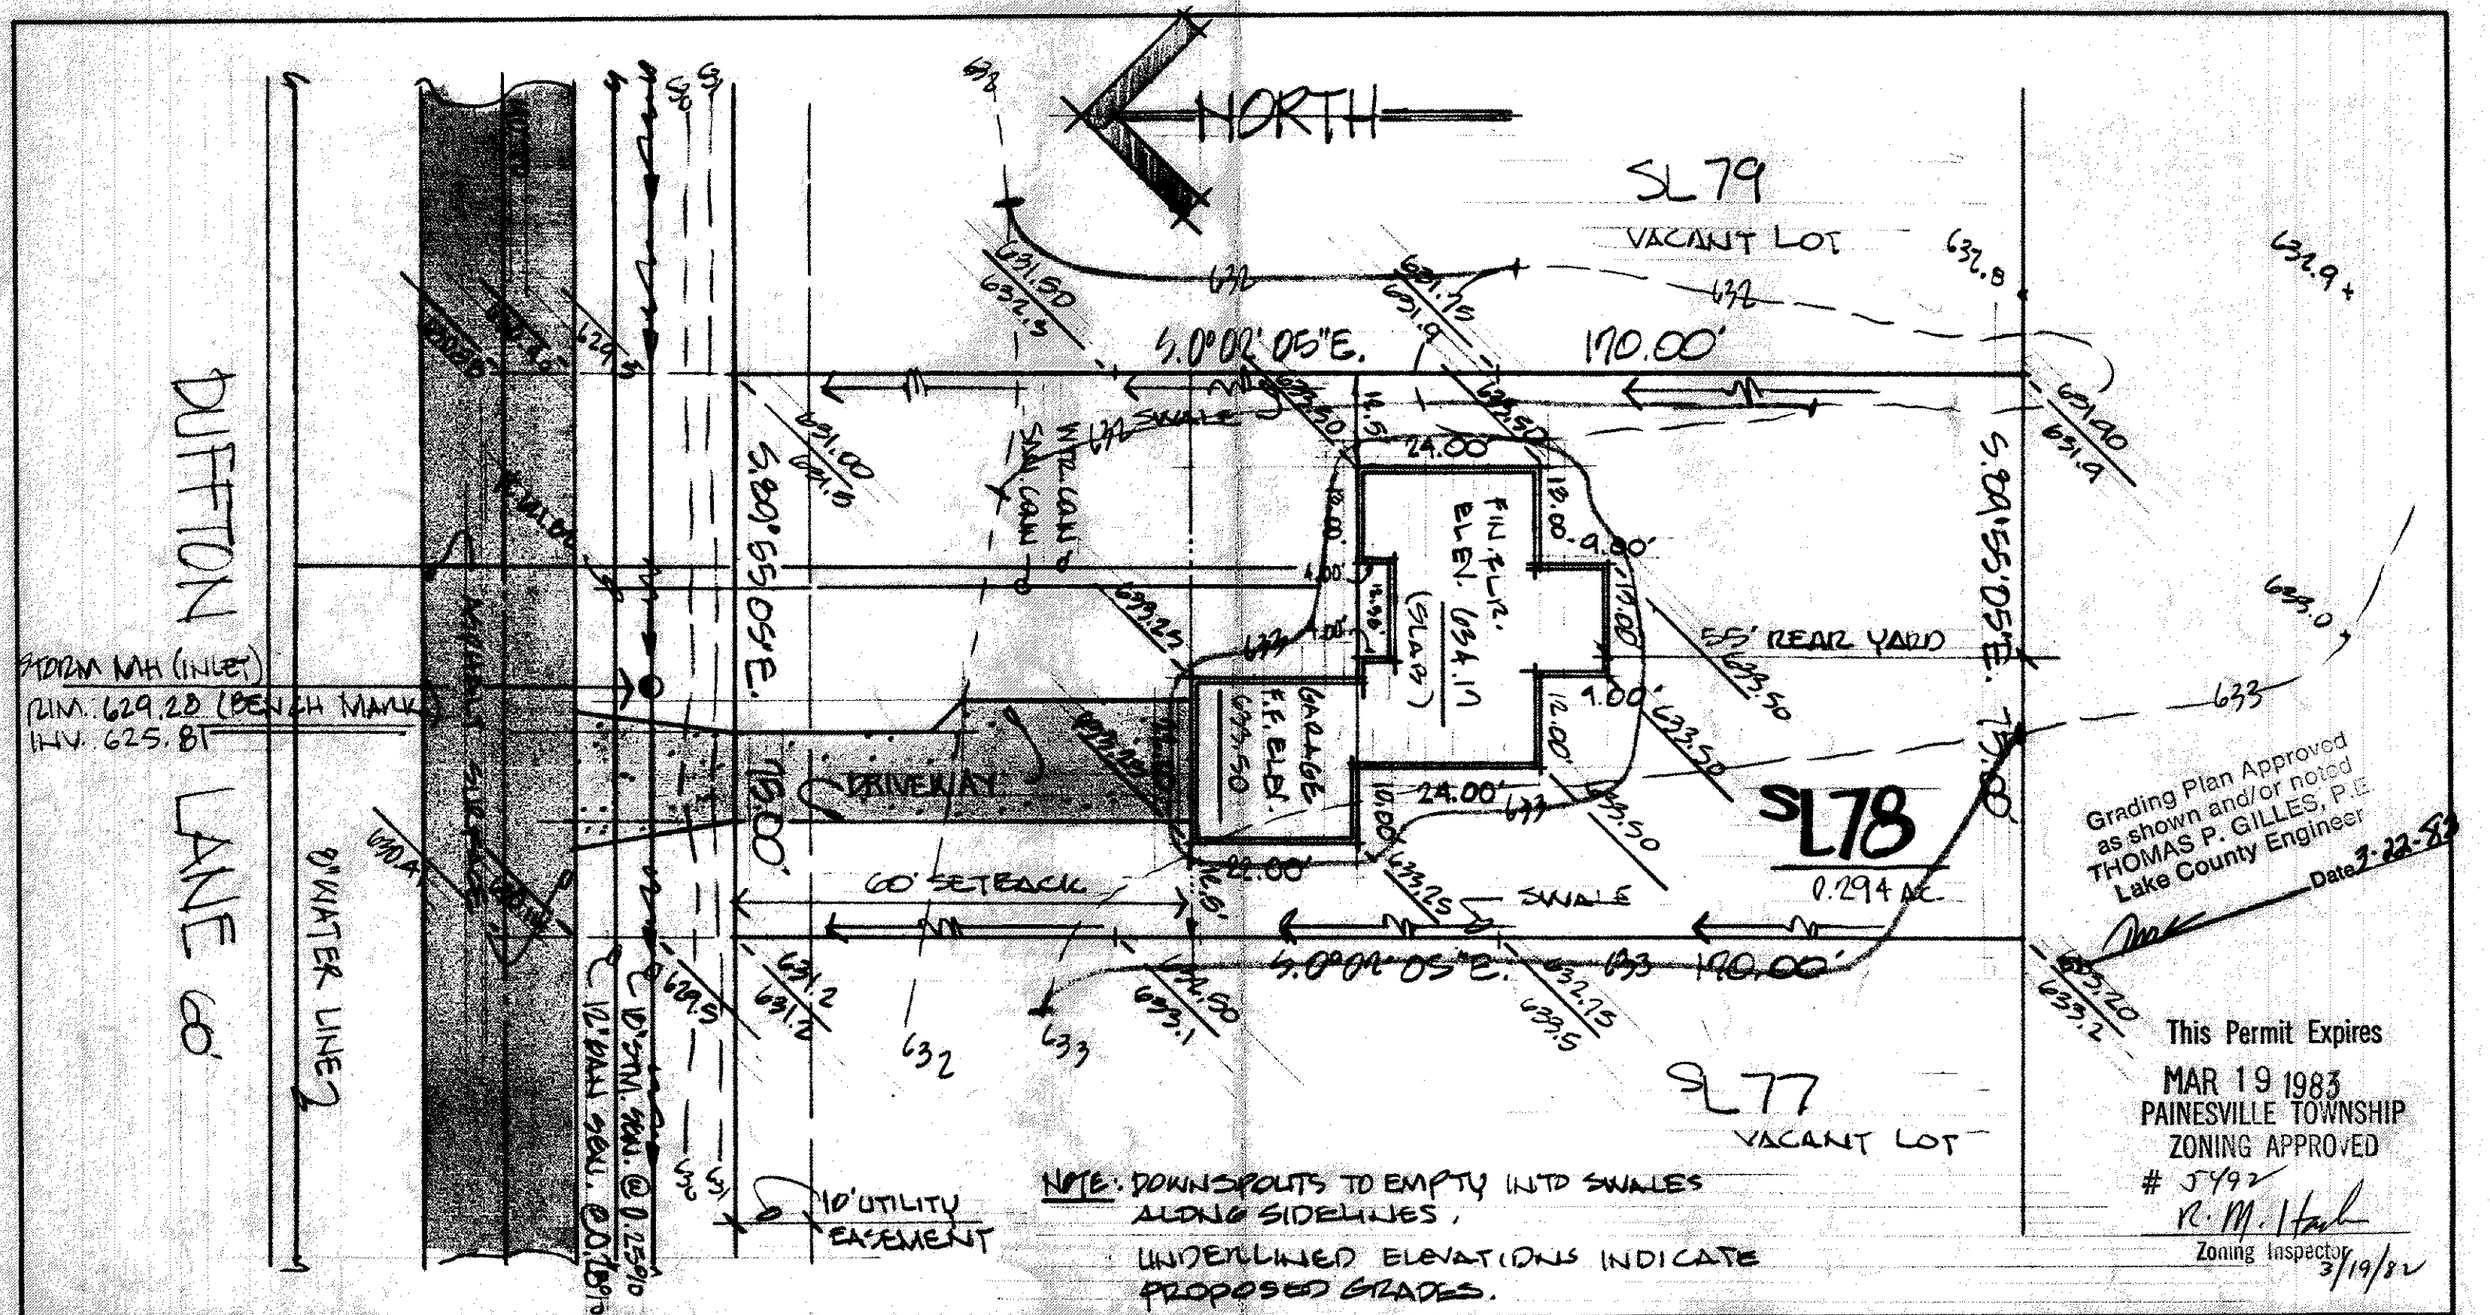

DESIGN CERTIFICATION	AS BUILT CERTIFICATION			
THIS PLAT WAS PREPARED BY ME, AND IS CORRECT TO THE BEST OF MY KNOWLEDGE AND BELIEF.	I HEREBY CERTIFY THAT THE CIRCLED GRADES ARE EXISTING FINISH GRADES CHECKED IN THE FIELD ON _____ AND THAT SURVEY IS CORRECT TO THE BEST OF MY KNOWLEDGE AND BELIEF.	COLPETZER · WOODS CONSULTANTS, INC. 9470 MENTOR AVENUE • MENTOR, OHIO 44066 • (216) 357-7569	DATE 3/8/82 SCALE 1"=20' DRWN BY G.D.B. CHKD BY [illegible] JOB NO. 79-033 FB 332A PG	SITE PLAN FOR: EDWARD H. TRESGER, INC. 8100 DEEPWOOD BLVD. MENTOR, OHIO BEING SUBLOT NO. 78 IN THE PINES SUBDIVISION NO. 2 IN PAINESVILLE TWP. OHIO.
REG. SURVEYOR NO. 4785	REG. SURVEYOR NO. _____			