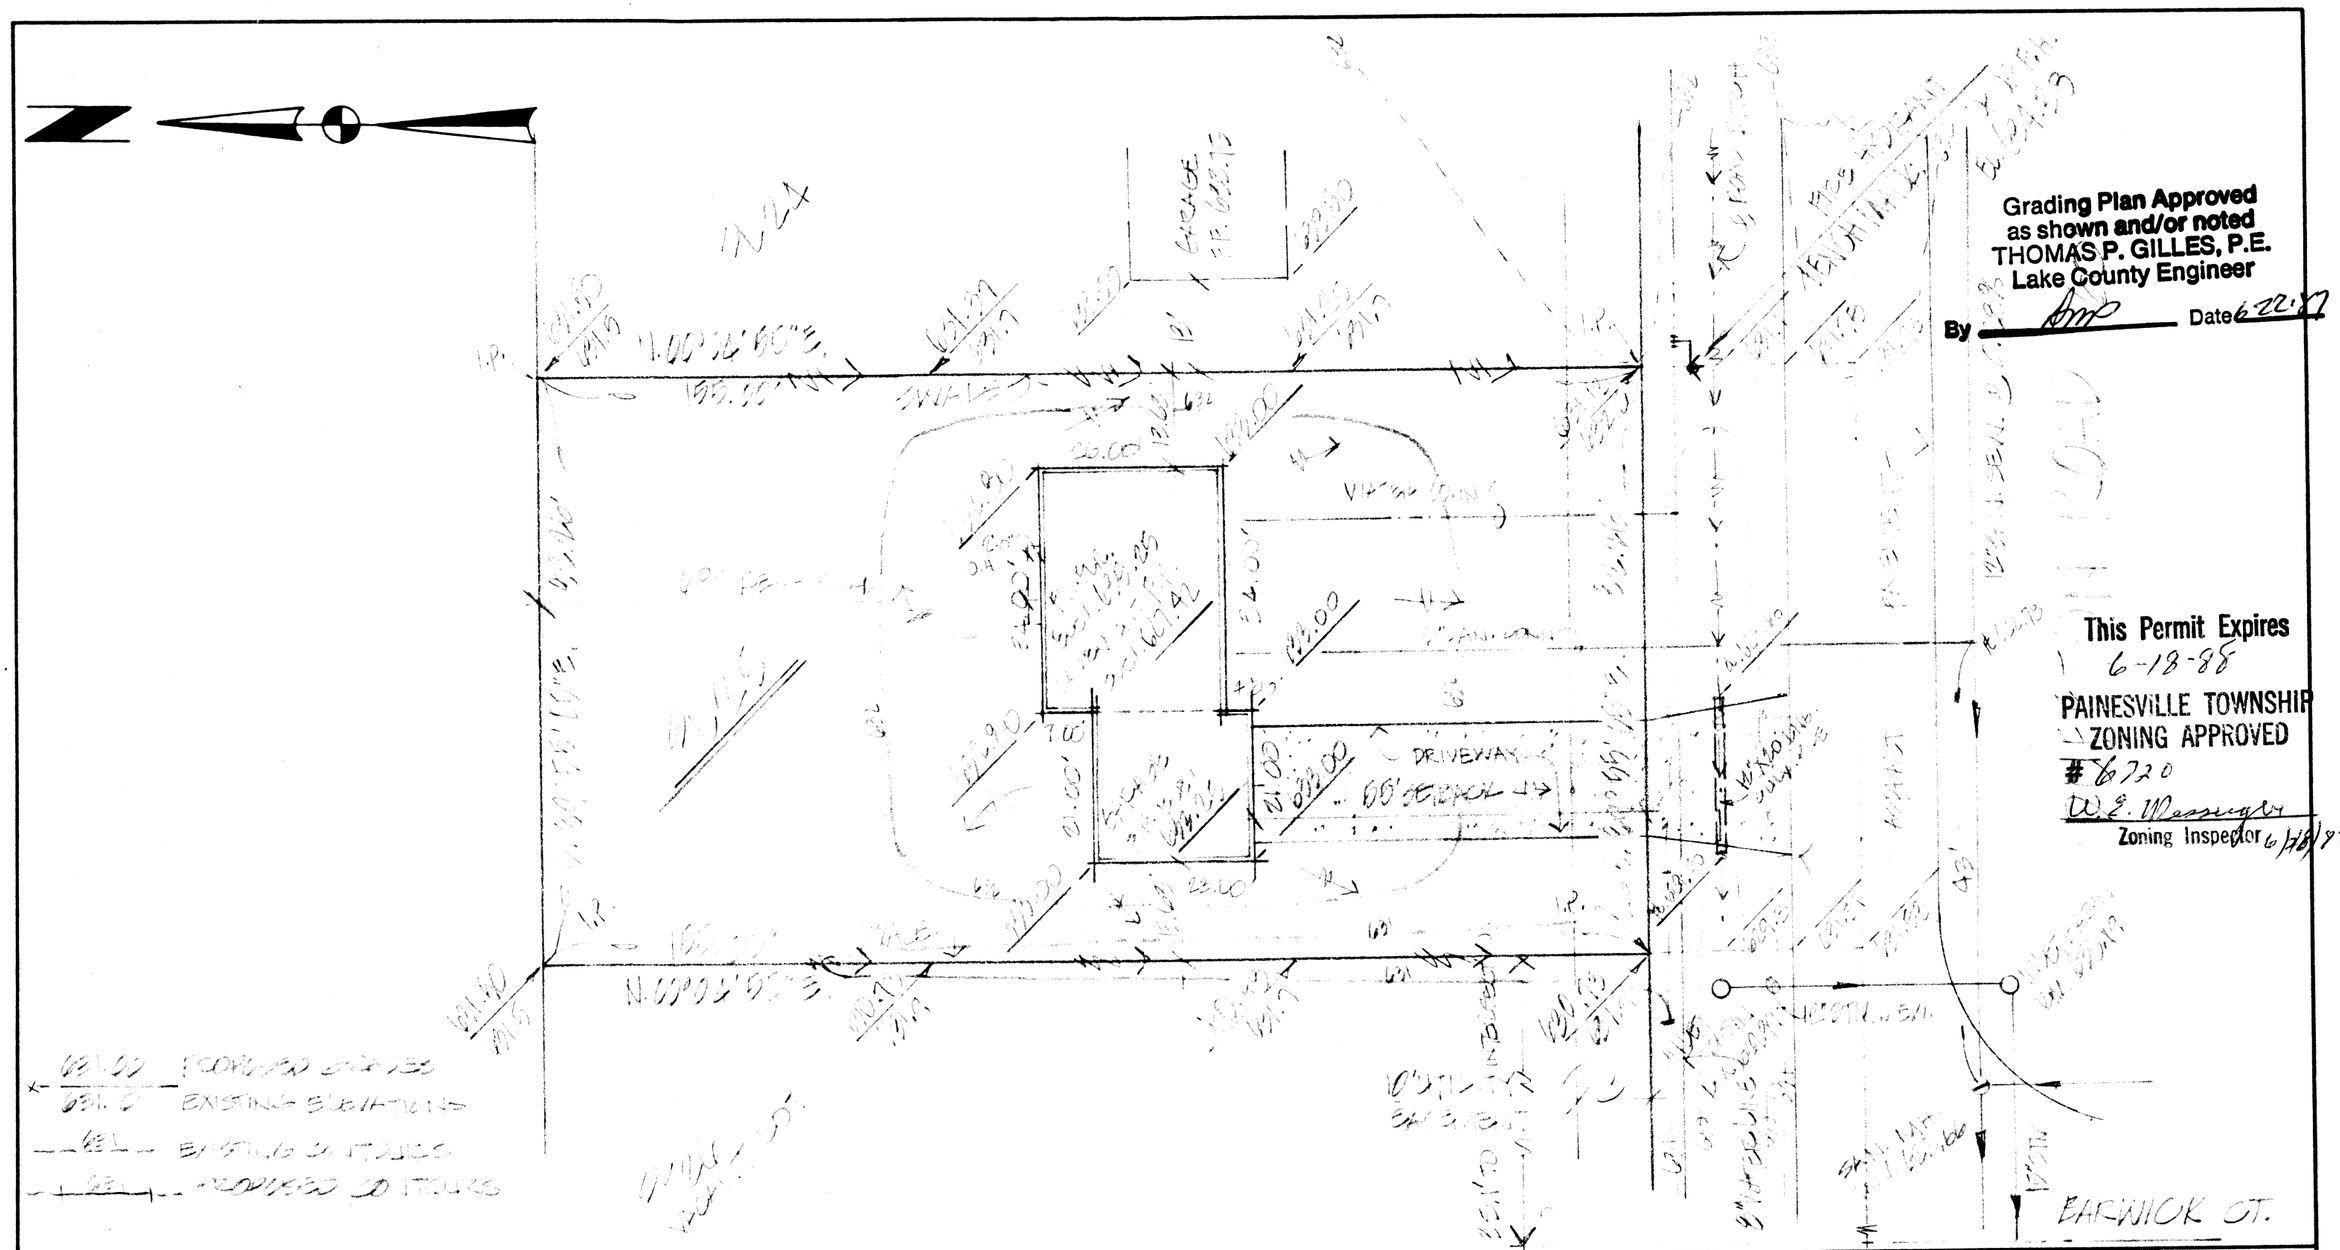

Grading Plan Approved
as shown and/or noted
THOMAS P. GILLES, P.E.
Lake County Engineer
By [signature] Date 6-22-87

This Permit Expires
6-18-88
PAINESVILLE TOWNSHIP
ZONING APPROVED
#6720
W.E. Messinger
Zoning Inspector 6/18/87

DESIGN CERTIFICATION	AS BUILT CERTIFICATION			
THIS PLAT WAS PREPARED BY ME, AND IS CORRECT TO THE BEST OF MY KNOWLEDGE AND BELIEF.	I HEREBY CERTIFY THAT THE CIRCLED GRADES ARE EXISTING FINISH GRADES CHECKED IN THE FIELD ON _____ AND THAT SURVEY IS CORRECT TO THE BEST OF MY KNOWLEDGE AND BELIEF.	COLPETZER · WOODS CONSULTANTS, INC. 9470 MENTOR AVENUE • MENTOR, OHIO 44060 • (216) 357-7569	DATE JUNE 10, 1987	SITE PLAN FOR: EDWARD H. TRESSER INC. 8100 DEERWOOD BLVD. MENTOR OHIO. PAINESVILLE TOWNSHIP OHIO.
REG. SURVEYOR NO. 5244	REG. SURVEYOR NO.		SCALE 1"=20'	
			DRWN BY CE	
			CHKD BY	
			JOB NO. 79-156-000	
			FB [illegible] PG	