PREPARED BY:
Wilson and Associates
Registered Surveyors
11005 Wilson Mills Road
Chardon, Ohio 44024
Date: May 15, 1974
Scale: 1" = 30'

SITE PLAN

FOXFIRE TRAILS SUBDIVISION

SUBLOT NO. 21

VOLUME S PAGE 7

PAINESVILLE TOWNSHIP

LAKE COUNTY OHIO

for

CASEMENT HOMES
1251 MADISON AVE.
PAINESVILLE, OHIO

CERTIFICATION:
I certify that this plat was prepared by me, and is correct to the best of my knowledge.
By: Lawrence Wilson
Lawrence Wilson, Reg. Surveyor No. 5807

"AS BUILT" CERTIFICATION:
I certify that on _____ 1974, the finished grades were checked in the field, shown encircled, and are correct to the best of my knowledge.
By: _____
Lawrence Wilson, Reg. Surveyor No. 5807

BENCH MARK: TOP OF MON. BOX RIM AT INTERSECTION OF ℄'s PINEVIEW AND FOXFIRE DR. ELEV. = 698.64

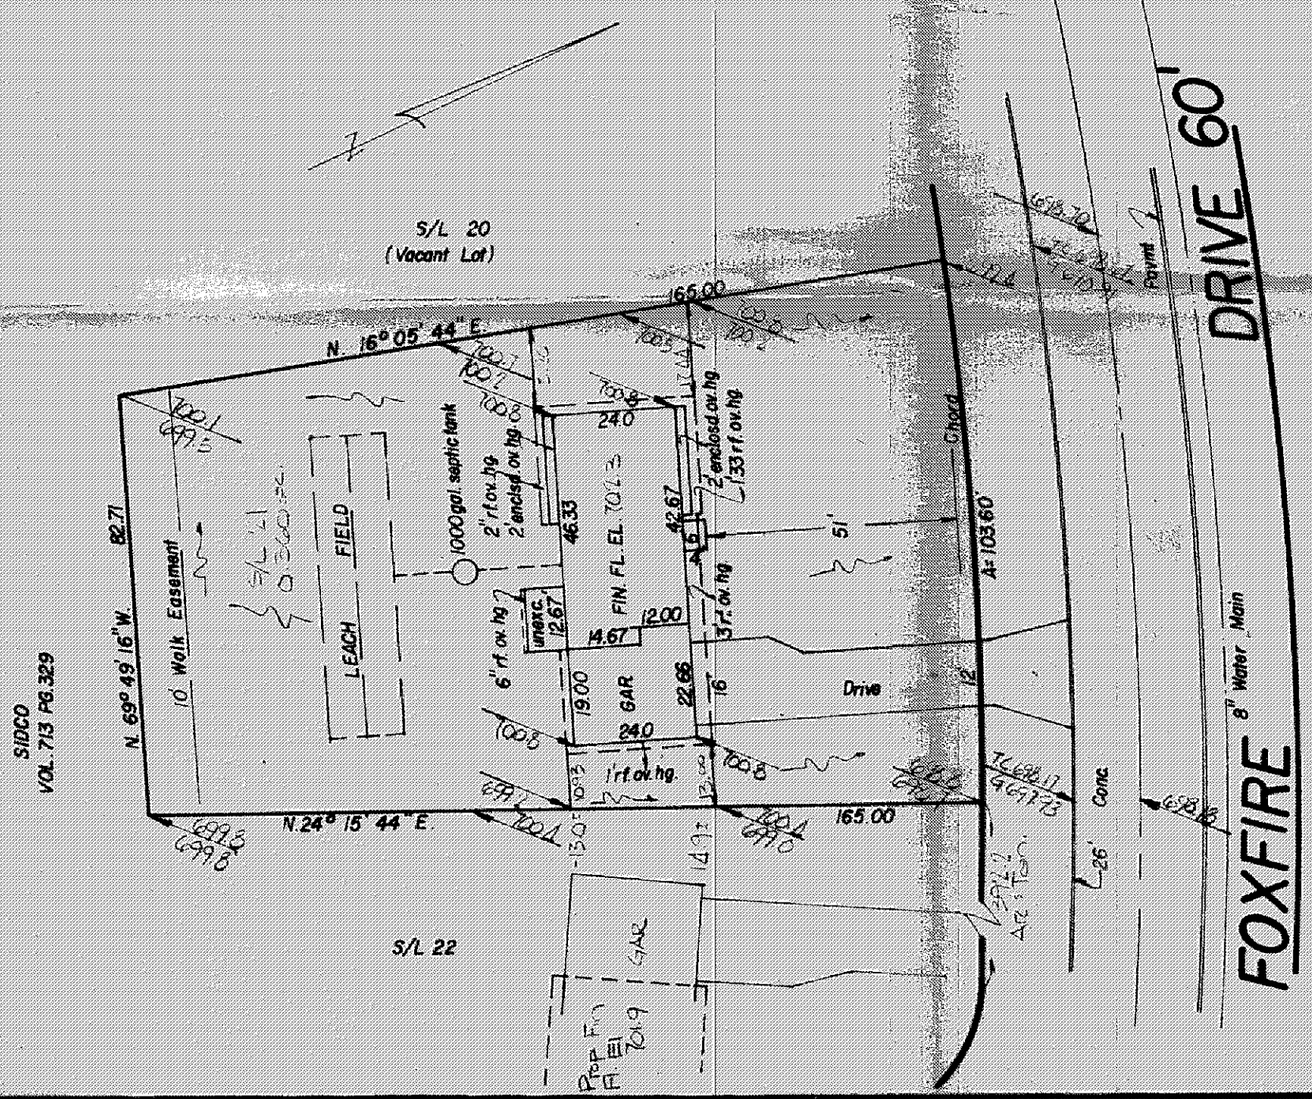

EXIST. EL. 701
PROP. EL.

PAINESVILLE TOWNSHIP
ZONING APPROVED
#3445 5-16-74
Zoning Inspector

Grading Plan Approved
as shown and/or noted
THOMAS P. GILLES, P.E.
Lake County Engineer
By JWK Date 5-16-74

STATE OF OHIO
LAWRENCE GORDON WILSON
5807
REGISTERED SURVEYOR