OFFICE: 354-4100 RES.: 354-8908

JOSEPH D. HADDEN

Registered Surveyor

130 E. JACKSON STREET

PAINESVILLE, OHIO 44077

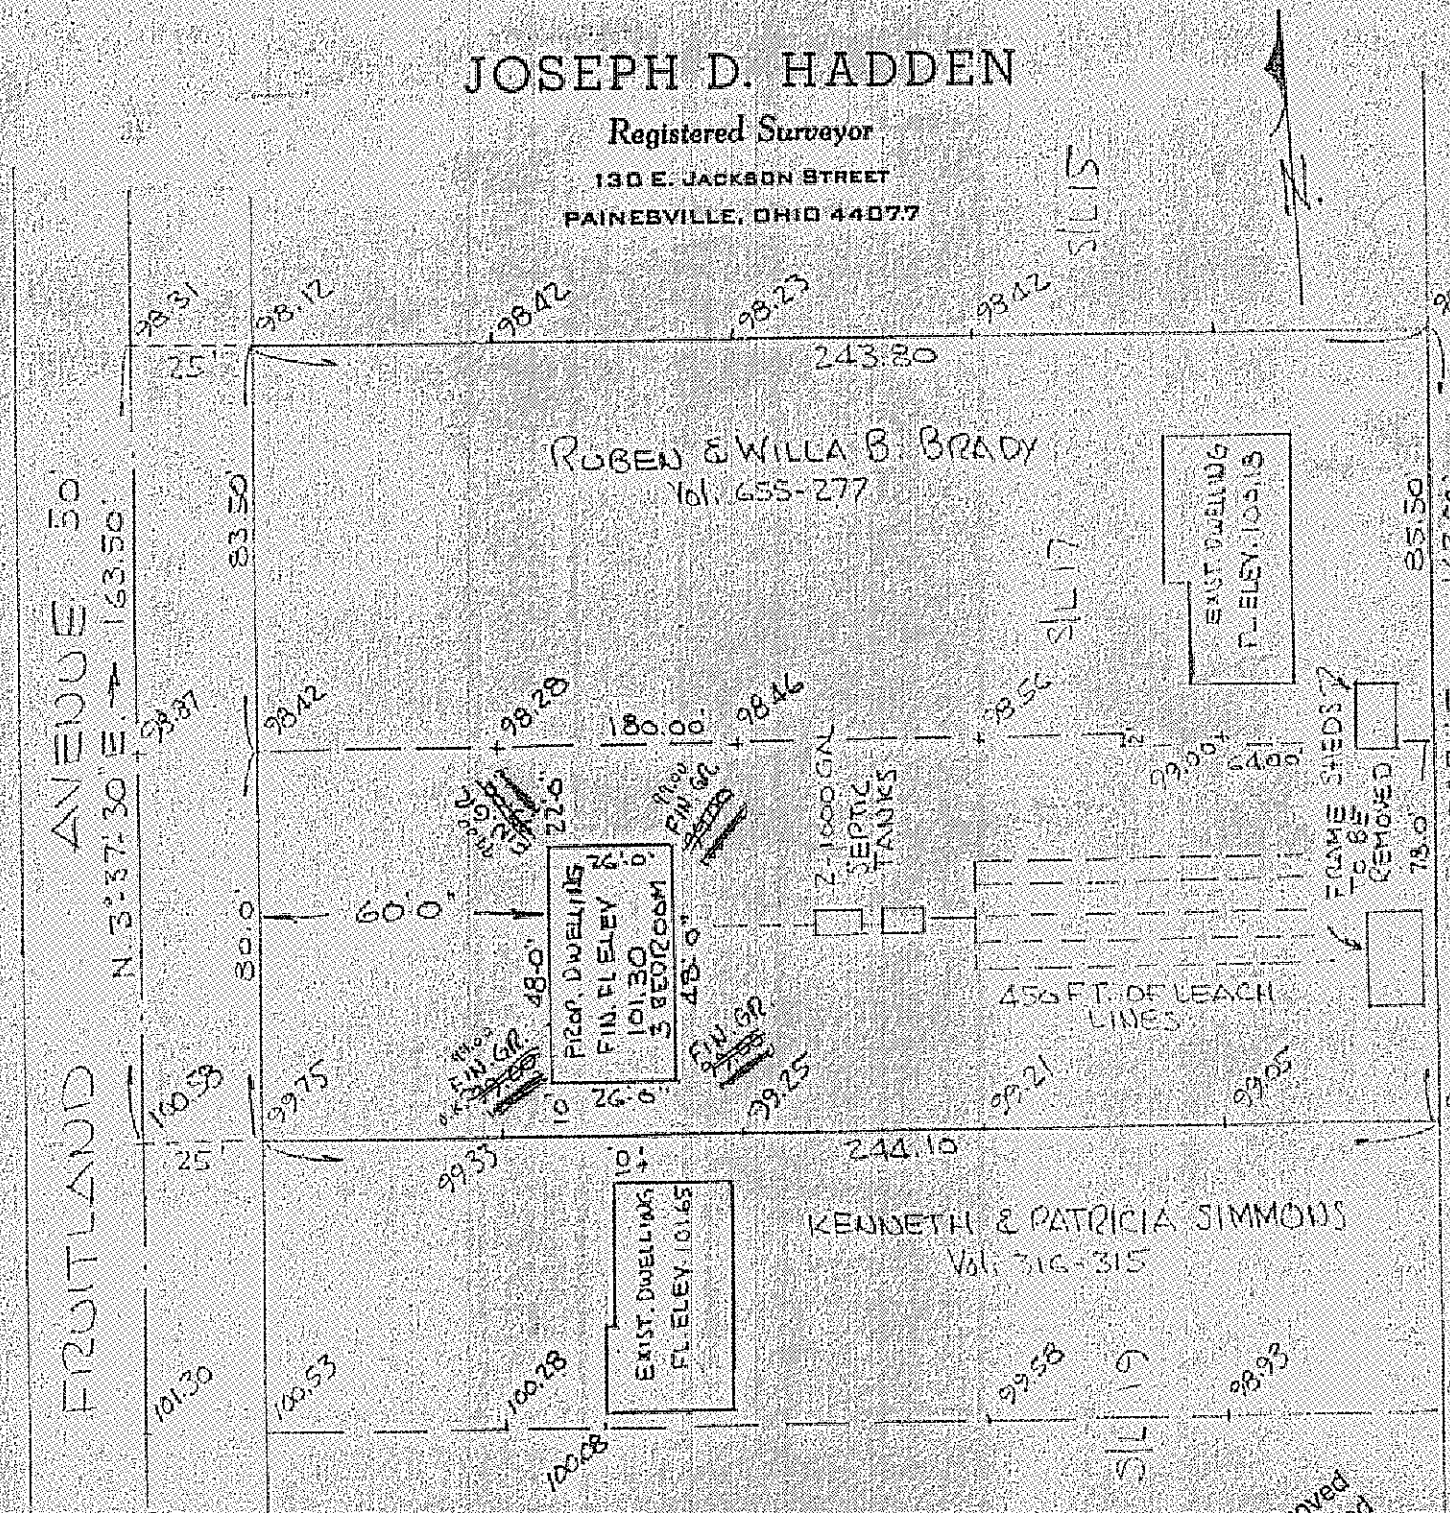

BUILDING SITE PLAN FOR
MR. & MRS. RUBEN BRADY
SUBLOT No. 17 - FRUITLAND ACRES SUBD.
PAINESVILLE TWP. - LAKE COUNTY - OHIO
Scale 1" = 40'
Aug. 9, 1973
Joseph D. Hadden, Reg. Surveyor

PAINESVILLE TOWNSHIP
ZONING APPROVED
3307 8-16-73
A. Newberry
Zoning Inspector

Grading Plan Approved as shown and/or noted
THOMAS P. GILLES, P.E.
Lake County Engineer
Date 8/14/73
By D.J.L.