SITE PLAN

PAINESVILLE TOWNSHIP COUNTY, OHIO

for: NICHOLAS VITT
CLIENT OWNER

130 FAIRPORT-NURSERY PAINESVILLE TWP. 44077
ADDRESS STREET CITY ZIP

SUBDIVISION NAME		LOT 647	TRACT 2
VOL. PG.		VOLUME 877	PAGE 923
SUBLOT NO.	STREET	PERM. PAR. NO.	STREET FAIRPORT-NURSERY

LEGEND

SANITARY MANHOLE
STORM MANHOLE
INLET OR CATCH BASIN
HYDRANT
EXISTING CONTOURS
PROPOSED CONTOURS
EXIST. ELEV. 100.0 / 100.0 PROP. ELEV.
WATER VALVE (GAS)
WATER METER (GAS)
AS BUILT ELEVATION 100.0
INDICATES DIRECTION OF SURFACE DRAINAGE

REMARKS

ALL BOUNDARY DATA SHOWN WAS OBTAINED FROM (DEEDS, RECORDED SUBDIVISION PLAT OR OTHER PUBLIC RECORDS).

DESIGN CERTIFICATION

THIS PLAN WAS PREPARED BY ME, AND IS CORRECT TO THE BEST OF MY KNOWLEDGE.

SURVEYOR NAME — OHIO REG. No. 6753

REVISIONS		
NO.	DATE	BY
1		
2		
3		
4		
5		

PLAN PREPARED BY:
WASSUM · KERR ASSOC., INC.
8561 EAST AVENUE
MENTOR, OHIO

DRAWN BY RK	SCALE 1" = 40'	PHONE NO. 951-1858
CHK'D.	DATE JUNE 1986	DRAWING NO.
CREW CHIEF	APP'D.	

Grading Plan Approved
as shown and/or noted
THOMAS P. GILLES, P.E.
Lake County Engineer
By _____ Date 7-10-86
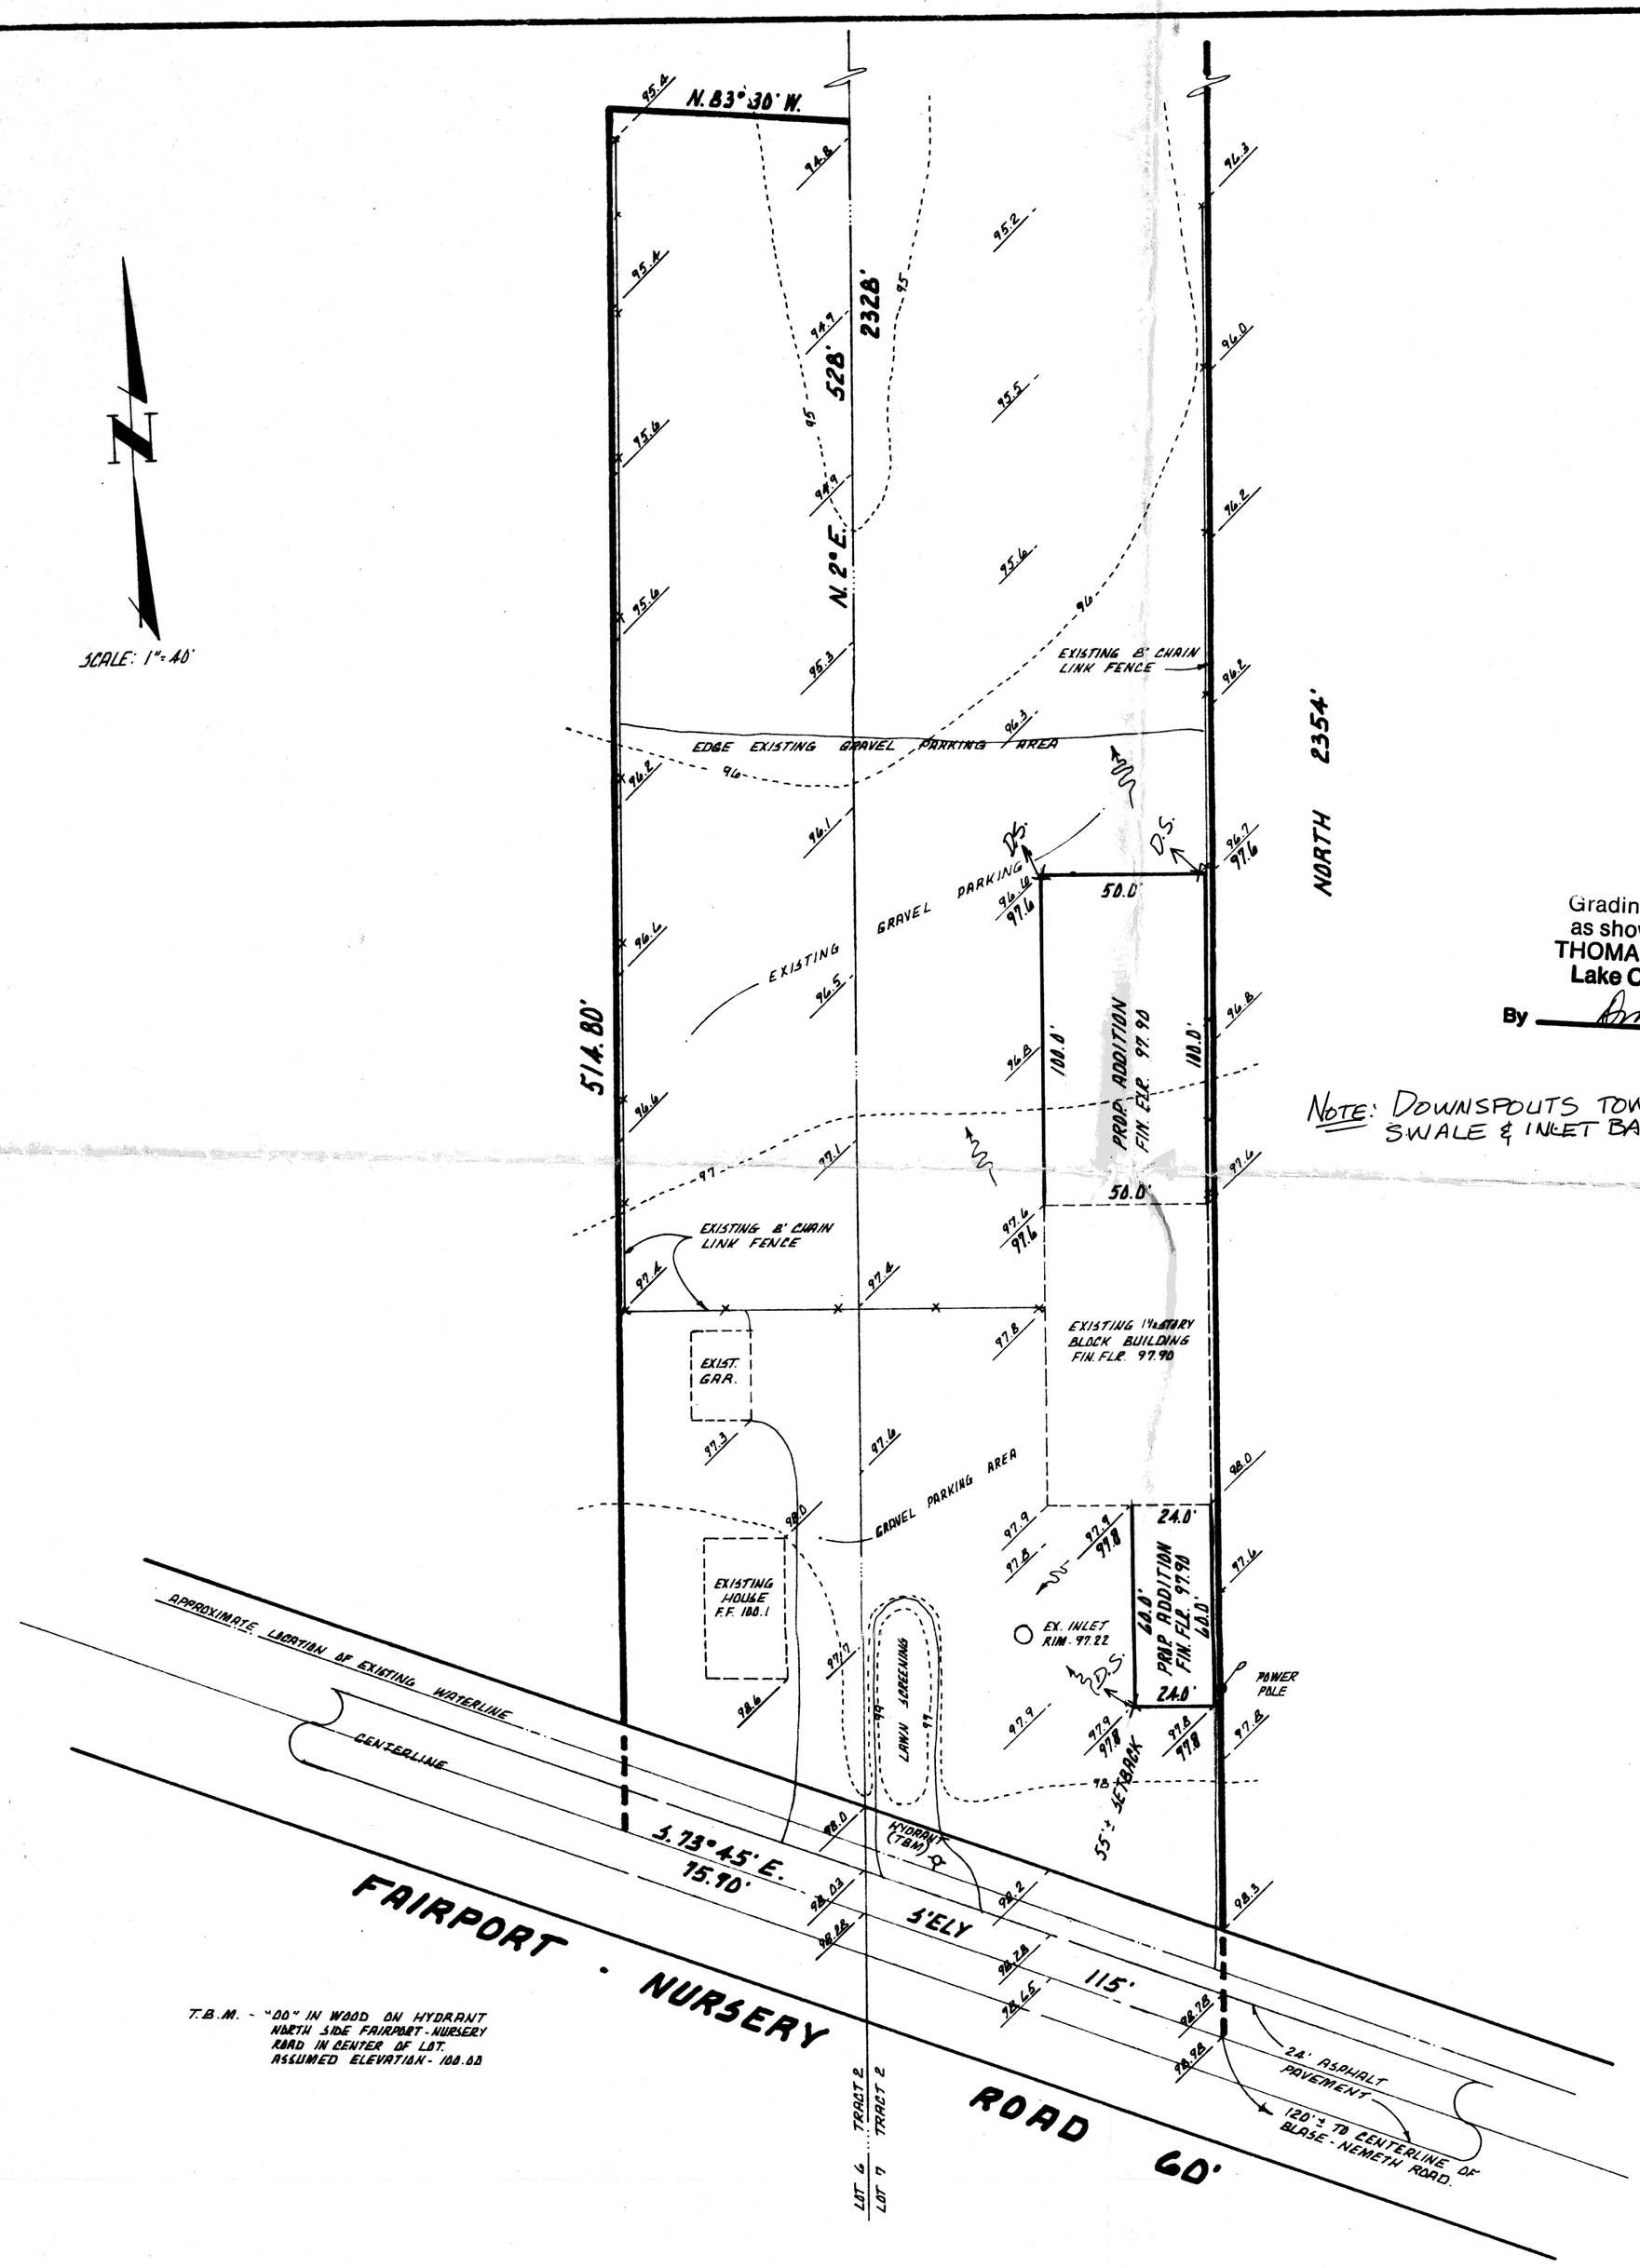
NOTE: DOWNSPOUTS TOWARDS SWALE & INLET BASIN.