SITE PLAN
FOR
R.C. REED CONST.

BEING S/L 40, HEATHERSTONE VILLAGE SUBDIVISION No. 1 IN THE TOWNSHIP OF PAINESVILLE, COUNTY OF LAKE, STATE OF OHIO.

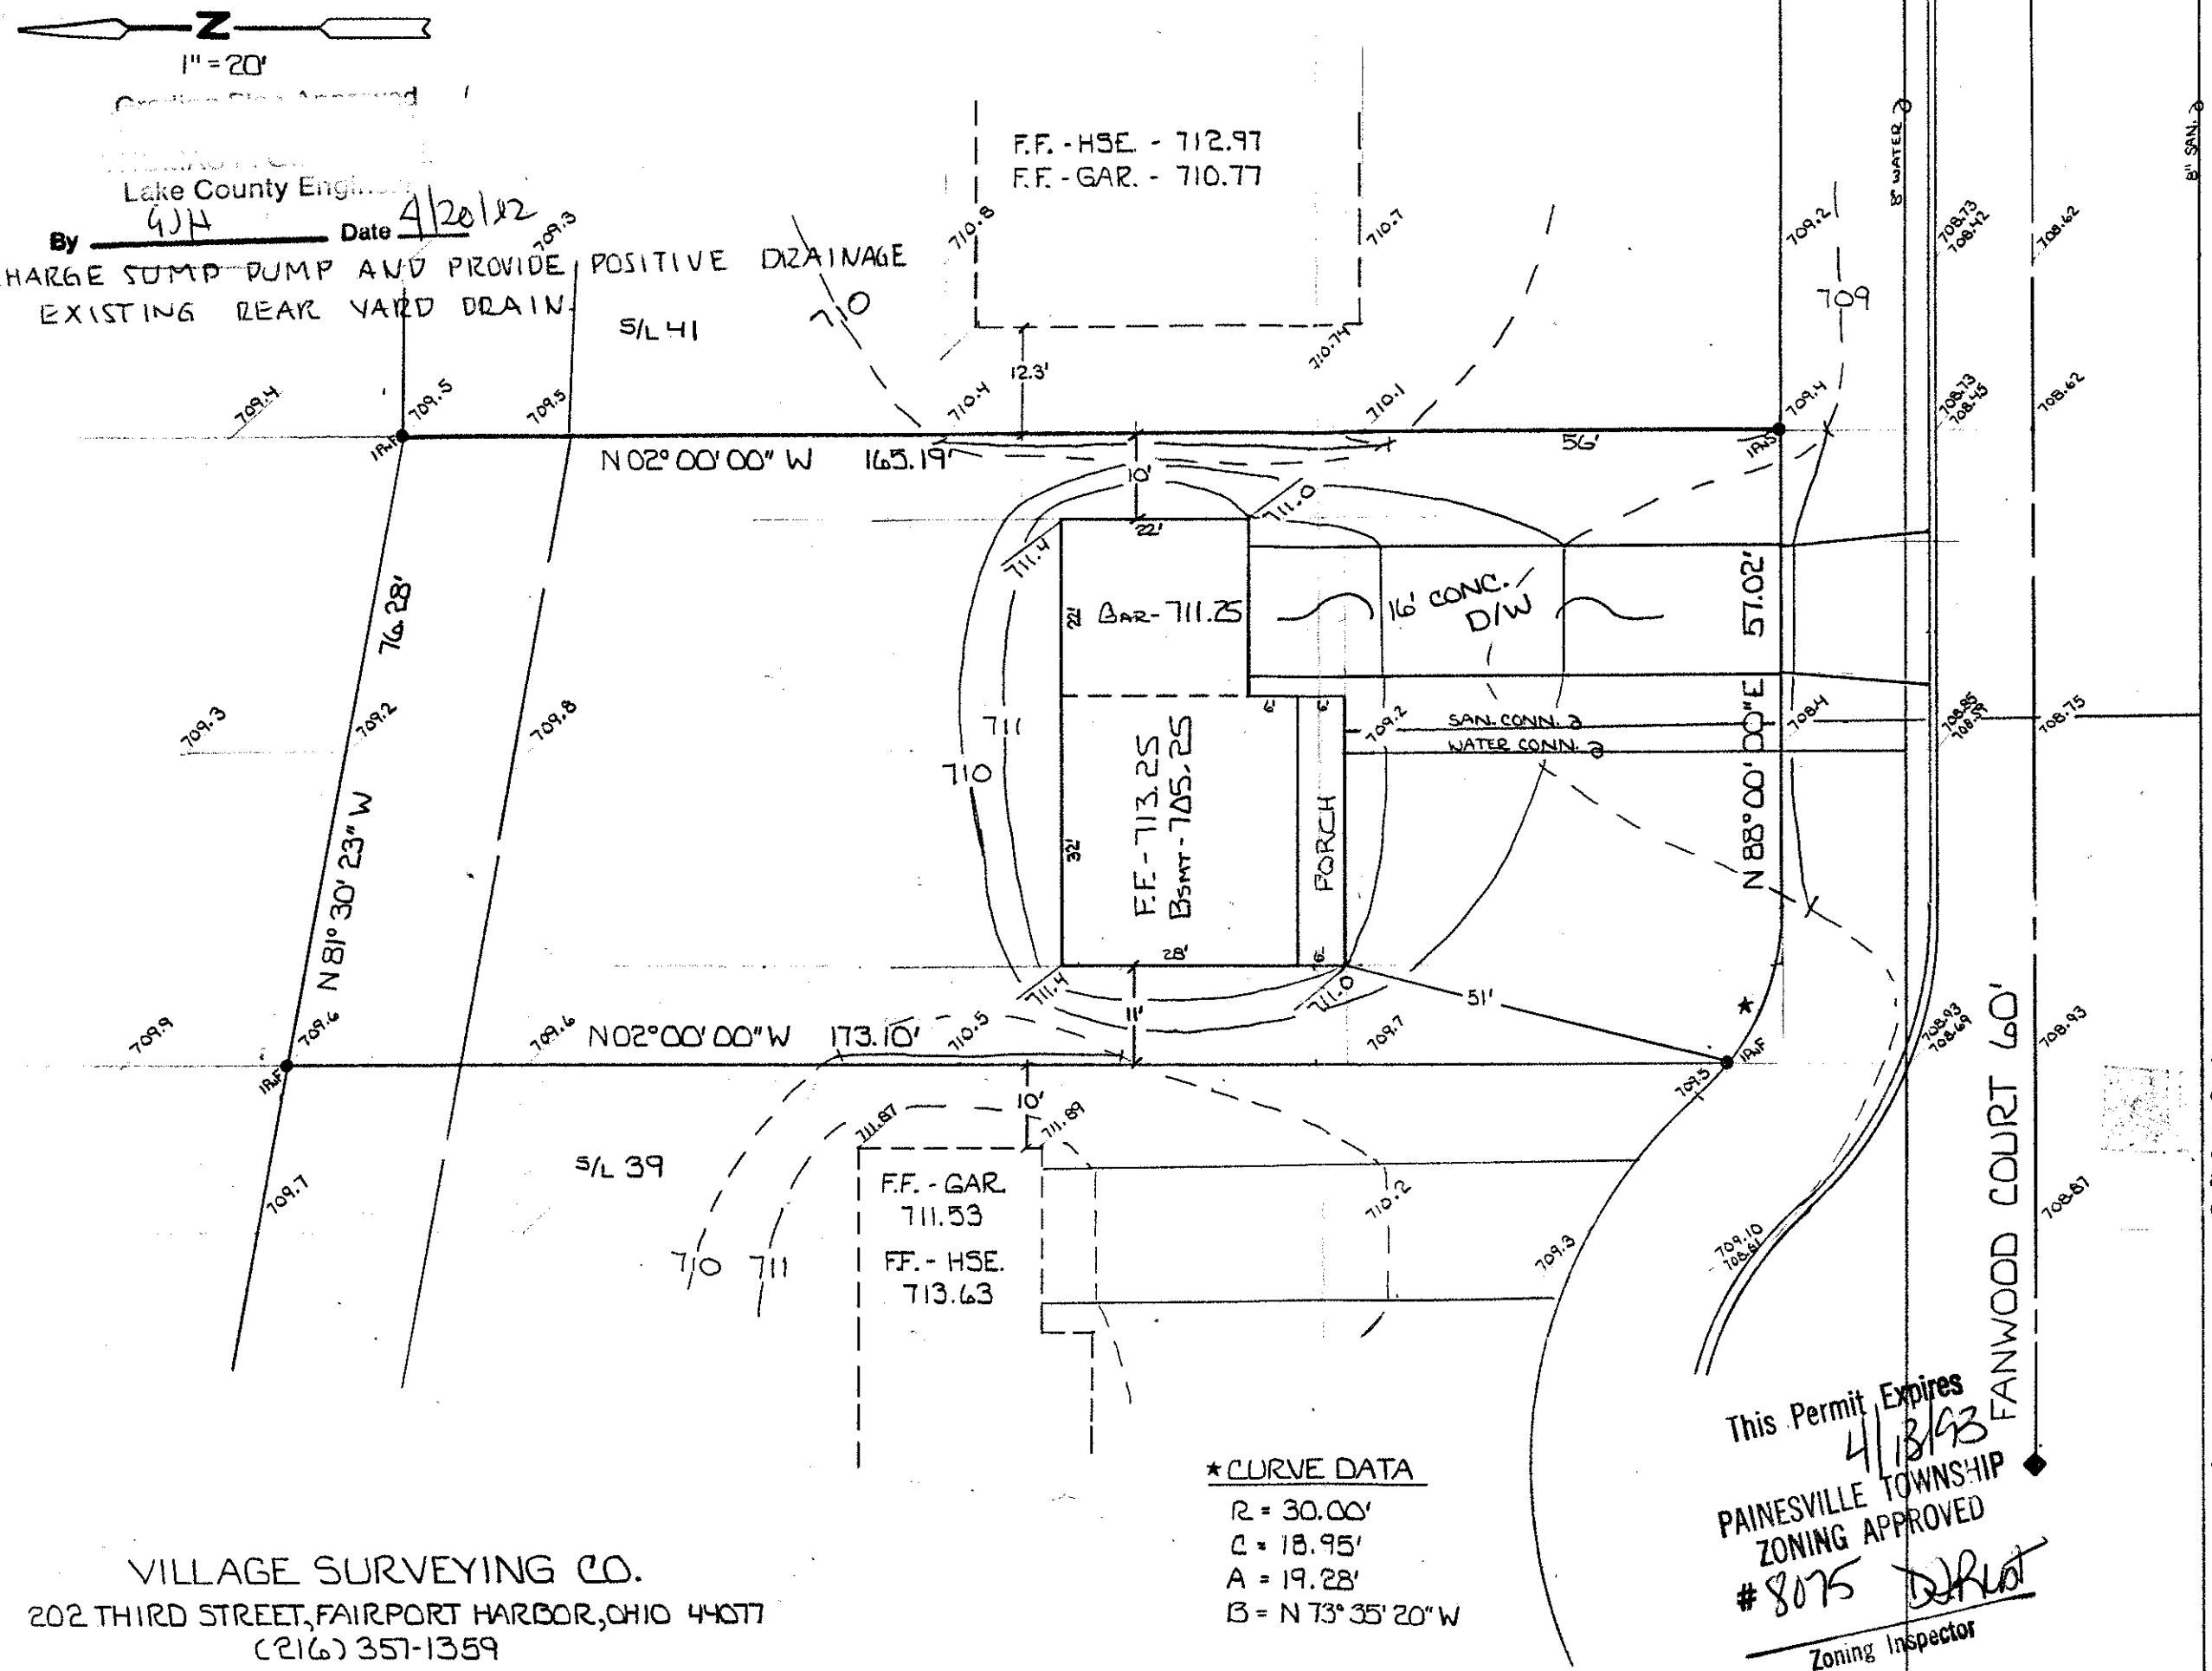

STATE OF OHIO
THOMAS MARC COFFMAN
6857
REGISTERED SURVEYOR

MARCH 28, 1992

I, the undersigned hereby certify that this topography, indicated by 1' contours, and elevations shown hereon represent an actual field survey made by me on MARCH 19, 199 and that the elevations were taken at appropriate intervals and that as of that date they existed as indicated hereon.

T. M. Coffman P.S. No 6857

BENCHMARK - N. RIM SAN. M.H. -708.17
INV. 700.97

VILLAGE SURVEYING CO.
202 THIRD STREET, FAIRPORT HARBOR, OHIO 44077
(216) 357-1359