SITE PLAN

for ALICE SMITH

ADDRESS	STREET	CITY
P.O. BOX 1069		CLEVELAND

SUBLOT No.	SUBDIVISION NAME	VOL.	PAGE
52 BLOCK	PAINESVILLE ON THE LAKE	3 D	13

LOT, TRACT	CITY/TOWNSHIP	
2	PAINESVILLE	OHIO

THE NORTH COAST ENGINEERING AND SURVEYING CO., INC.
2570 SUPERIOR AVE., SUITE 501
CLEVELAND, OHIO 44114
TEL. (216) 241-7070 FAX (216) 241-7071

CHECK LIST

LOT DIMENSIONS & BEARINGS
TIE TO NEAREST STREET
SUBLOT No. (PARCEL No.)
SURROUNDING OWNERS
BUILDING DIMENSIONS
SETBACK, SIDEYARD, REARYARD
FINISHED GRADES
DRIVE, W/ APRON, TYPE, WIDTH, THICKNESS
SIDEWALK TYPE, WIDTH, THICKNESS
CULVERT, TYPE, DIAM., LENGTH
WATER MAIN SIZE, LOCATION
SAN. SEWER SIZE, % GRADE, LOCATION
SAN. M.H. CAST. ELEV. INV. ELEV.
SAN. CONN. SIZE, % GRADE, LOCATION
STORM SEWER SIZE, % GRADE, LOCATION
STORM M.H. CAST. ELEV. INV. ELEV.
PAVT. TYPE, GRADE, CURBS
GAS LINE LOC. SIZE
SEPTIC SYSTEM & DUPLICATION
WELL LOCATION & ISOLATION RADIUS

STATE OF OHIO
EDWARD B. DUDLEY, III
6747
REGISTERED LAND SURVEYOR

STATE SEAL

DESIGN CERTIFICATION

THIS PLAT WAS PREPARED BY ME, AND IS CORRECT TO THE BEST OF MY KNOWLEDGE.

NAME _____ DATE DEC. 30, 1993

"AS-BUILT" CERTIFICATION

I HEREBY CERTIFY THAT THE CIRCLED INFORMATION IS EXISTING AS OBTAINED ON THE SITE _____ 19 ____ AND IS CORRECT TO THE BEST OF MY KNOWLEDGE AND BELIEF.

NAME _____

LEGEND

STORM MANHOLE
SANITARY MANHOLE
EXISTING CONTOURS 100
PROPOSED CONTOURS 100
EXIST. ELEV. 100.0
100.0 PROP. ELEV.
DIRECTION OF SURFACE DRAINAGE

DRAWN BY	SCALE
GPET	1" = 10'
CHK'D BY	DATE
	12/30/93
REV. ADD DRIVE & CULVERT 1-03-94	
REV.	
REV.	

BENCHMARK: RIM OF SANITARY MANHOLE AT SHADY LANE & FREMONT AVENUE ELEVATION = 631.65

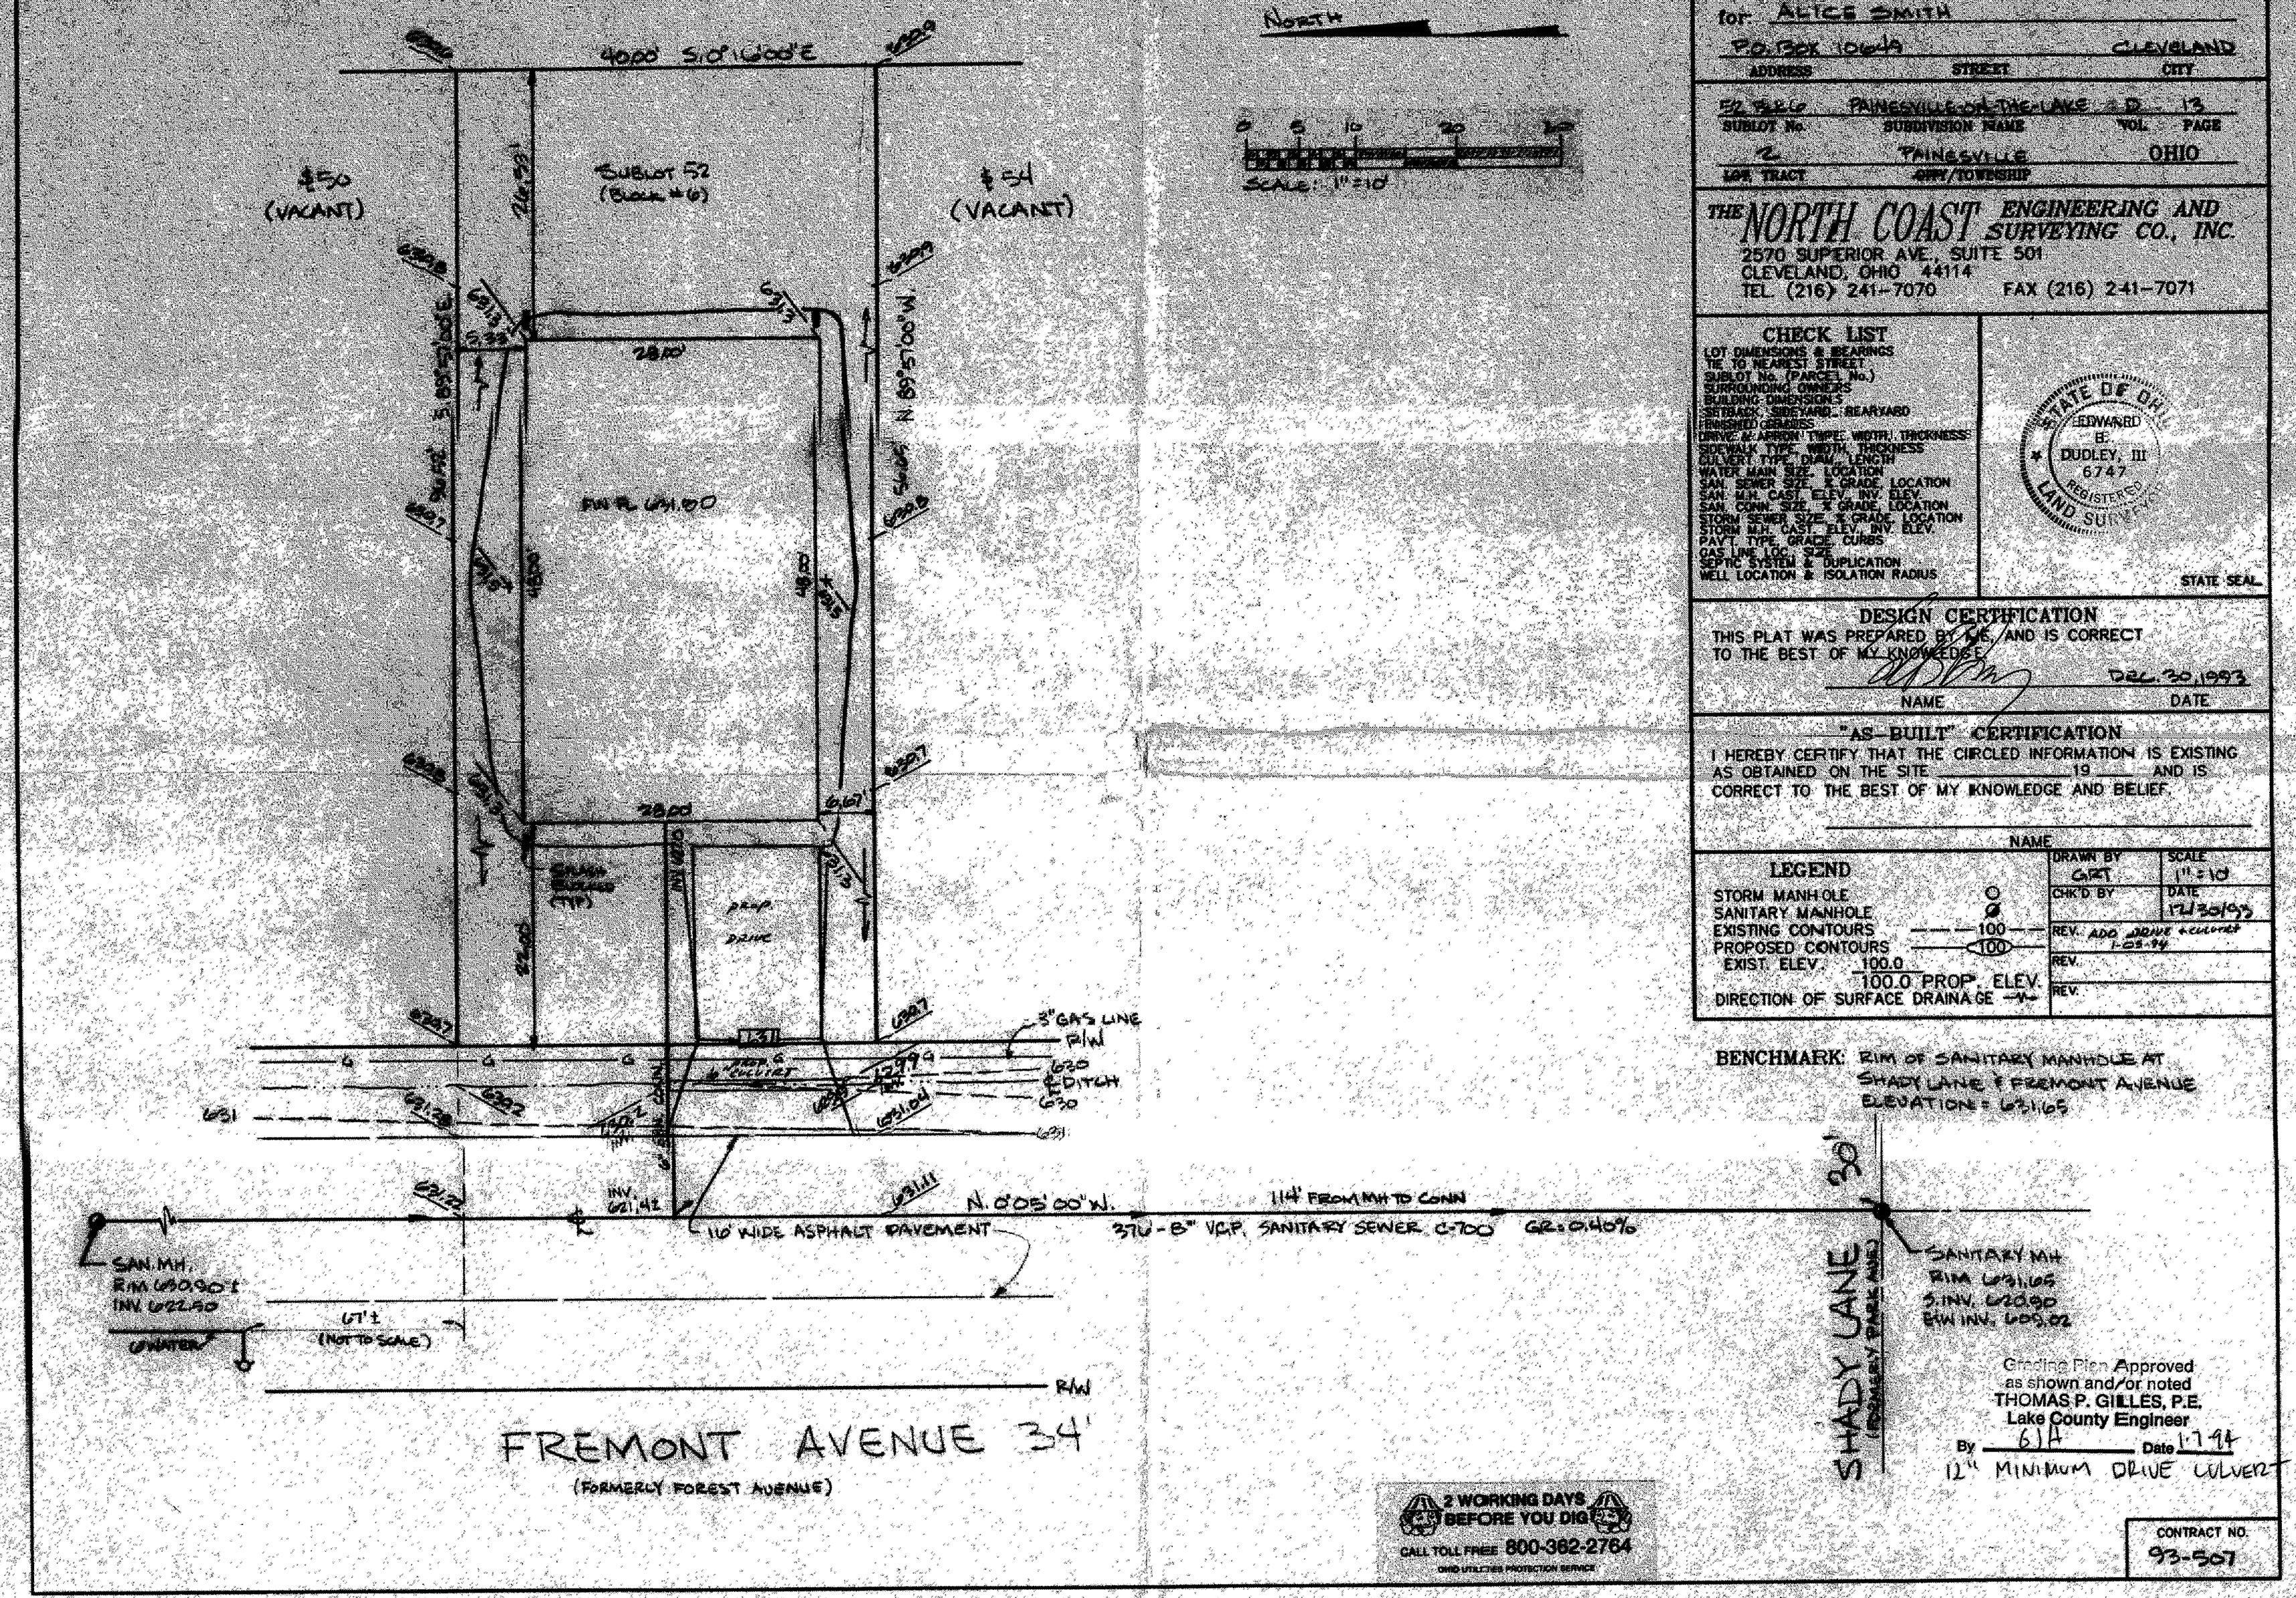

Grading Plan Approved as shown and/or noted
THOMAS P. GILLES, P.E.
Lake County Engineer
By GJH Date 1-7-94
12" MINIMUM DRIVE CULVERT

2 WORKING DAYS BEFORE YOU DIG
CALL TOLL FREE 800-362-2764
OHIO UTILITIES PROTECTION SERVICE

CONTRACT NO. 93-507