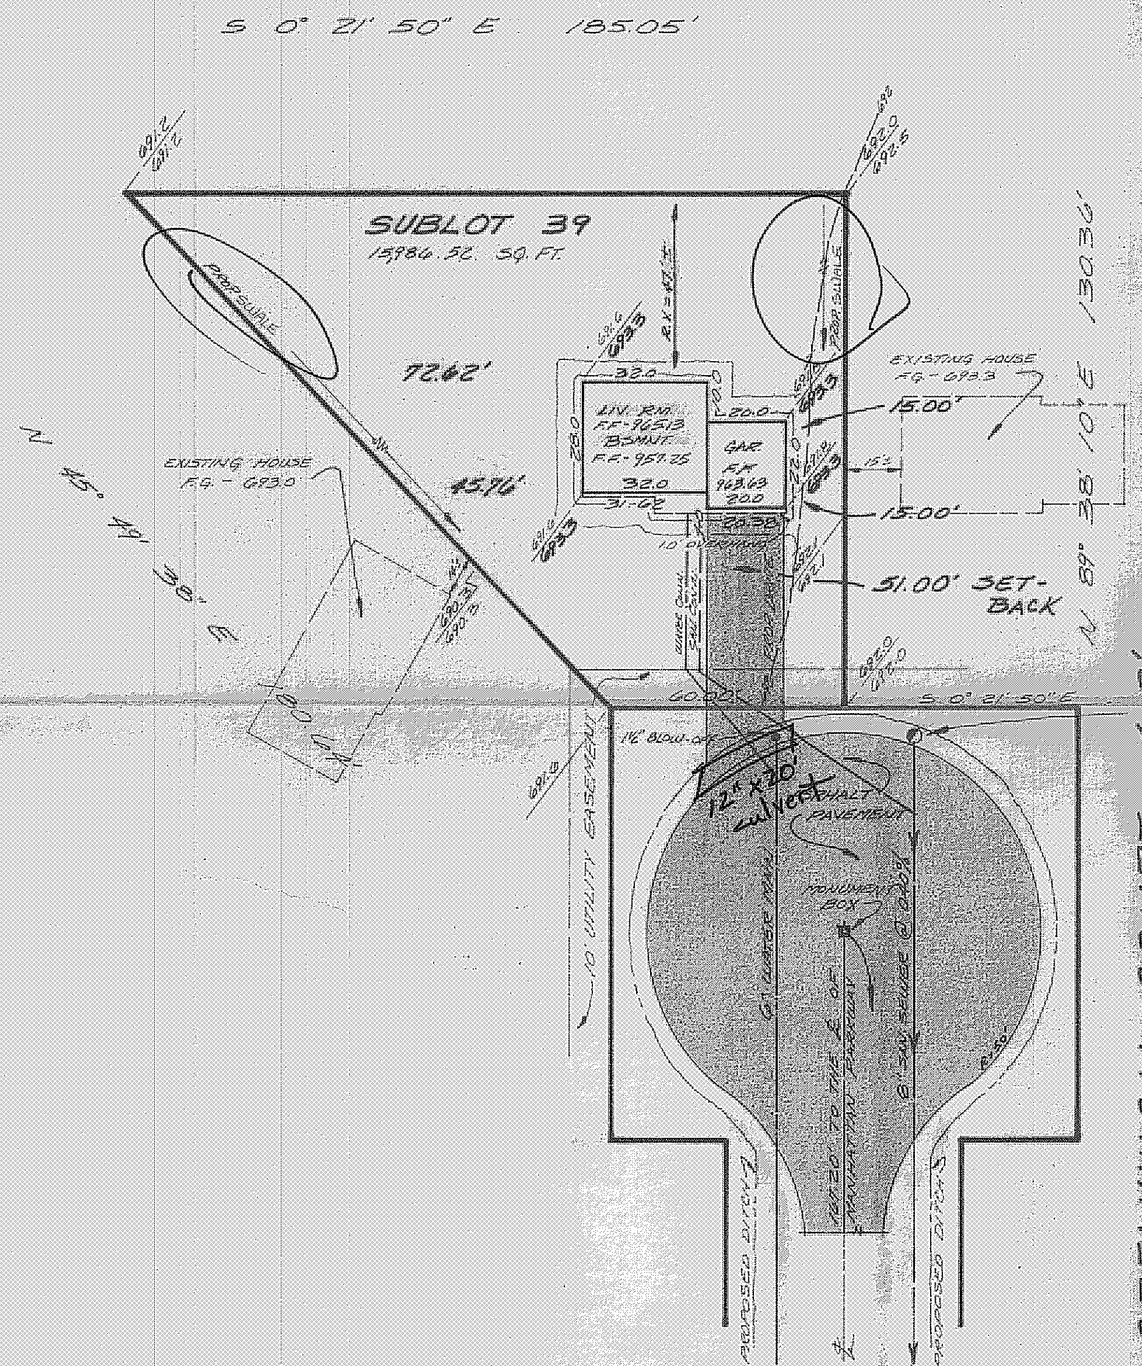
S 0° 21' 50" E 185.05'
SUBLOT 39
15,986.52 SQ. FT.
72.62'
45.76'
N 45° 49' 38" E
EXISTING HOUSE F.F. - 693.0
EXISTING HOUSE F.F. - 693.3
LIV. RM. F.F.-963.13 BSMNT. F.F.-957.25
GAR. F.F. 963.63
15.00'
15.00'
51.00' SET-BACK
N 89° 38' 10" E 130.30'
692.0 692.5
