SITE PLAN
FOR
R. C. REED CONST.
BEING SUBLOT NO. 132, IN THE
HEATHERSTONE VILLAGE SUB'D NO1.
PAINESVILLE TWP., LAKE COUNTY, OHIO

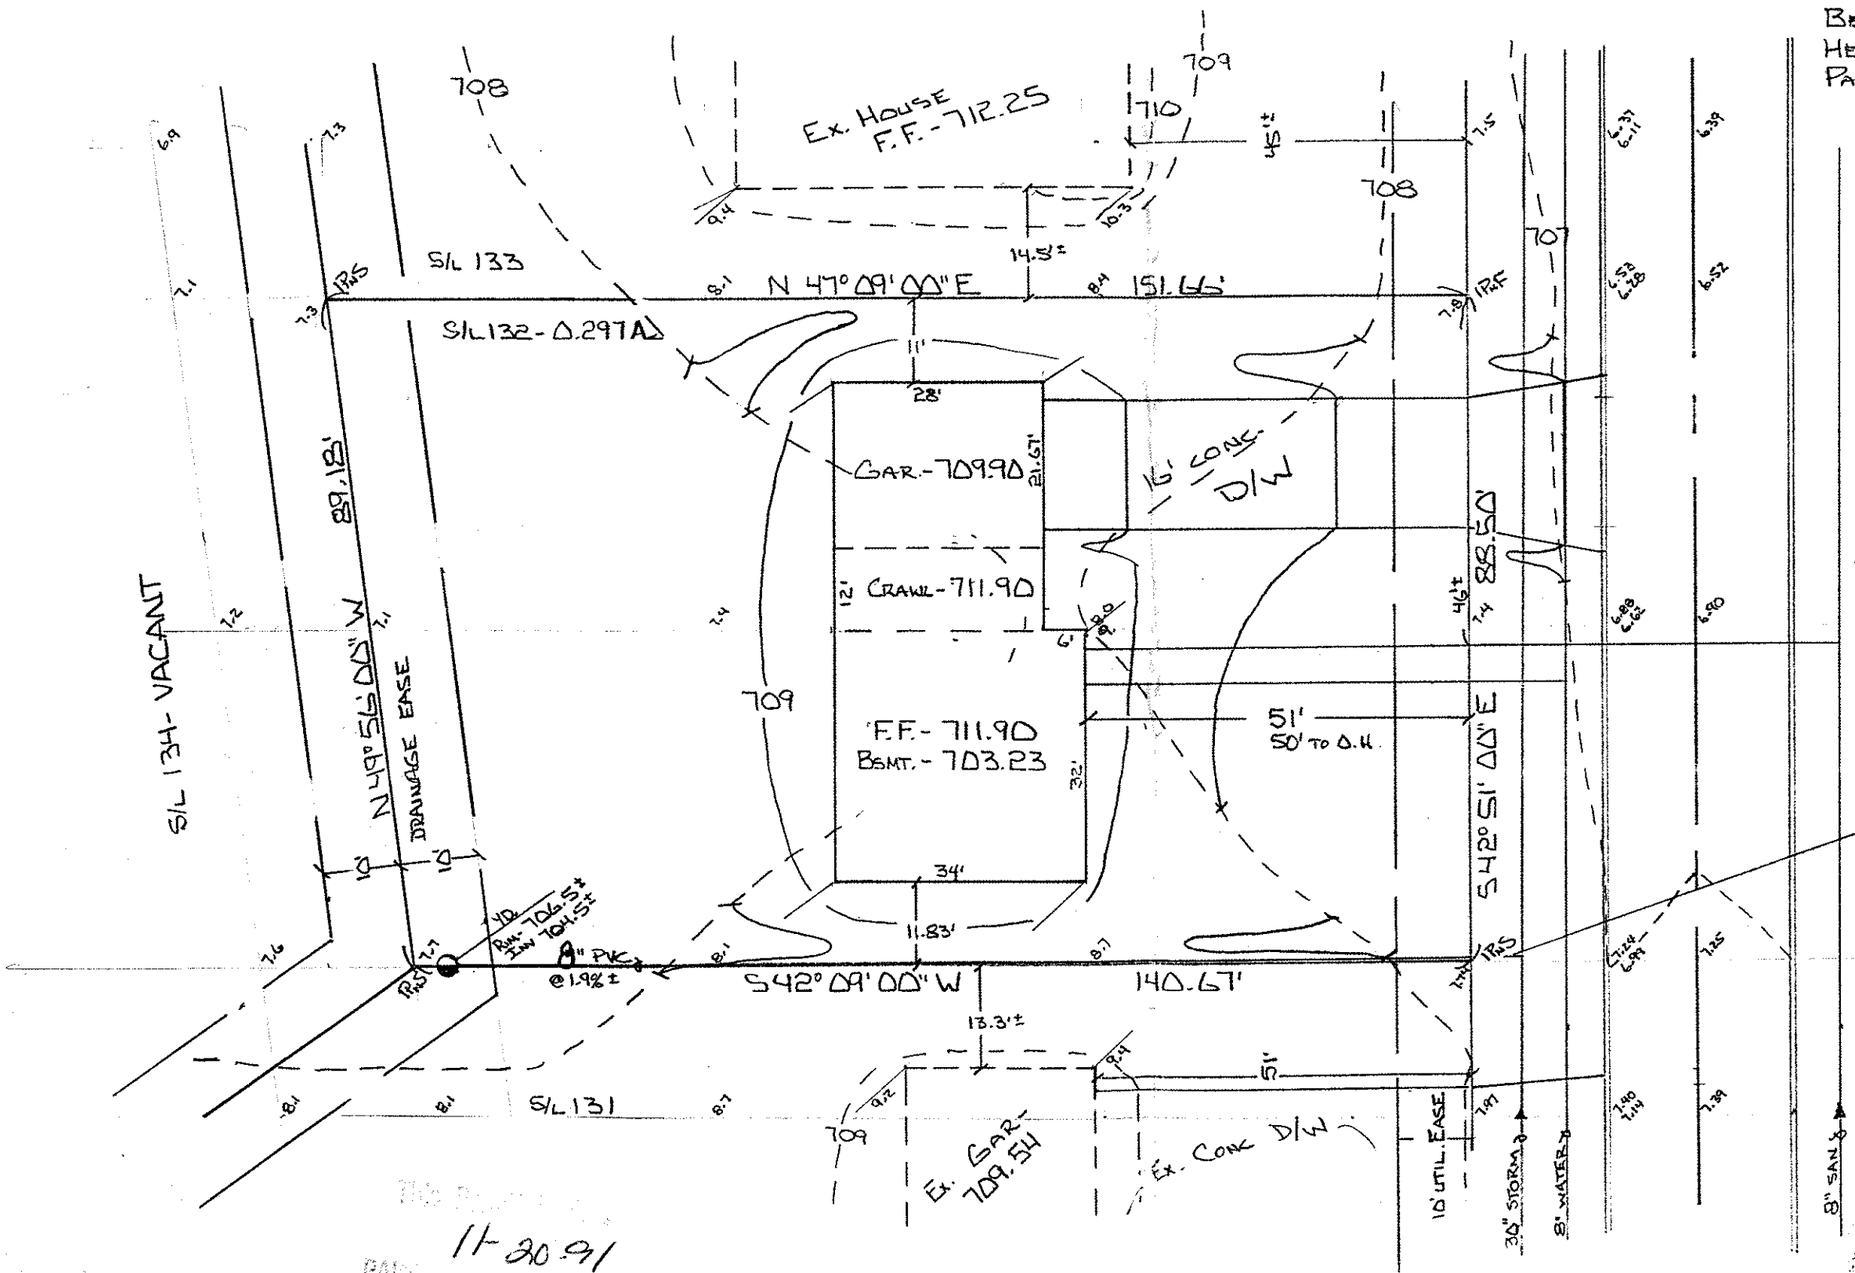

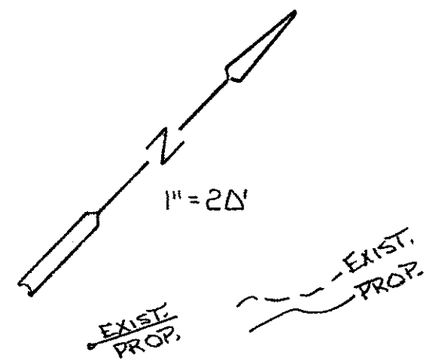

TAP 8" PVC INTO 30" STM
ABOVE SPRING LINE - 701.7±
COLLAR W/CONCRETE

Grading Plan Approved
as shown and/or noted
THOMAS P. GILLES, P.E.
Lake County Engineer
By GJH Date 11/28/90

1. USE 8" PVC AND CONNECT SUMP PUMP TO STORM SEWER.

I, the undersigned hereby certify that this topography, indicated by 1' contours, and elevations shown hereon represent an actual field survey made by me on 11-6-90 and that the elevations were taken at appropriate intervals and that as of that date they existed as indicated hereon.

J. M. Coffman P.S.
No 6851

11-20-91

#7675 DGRust