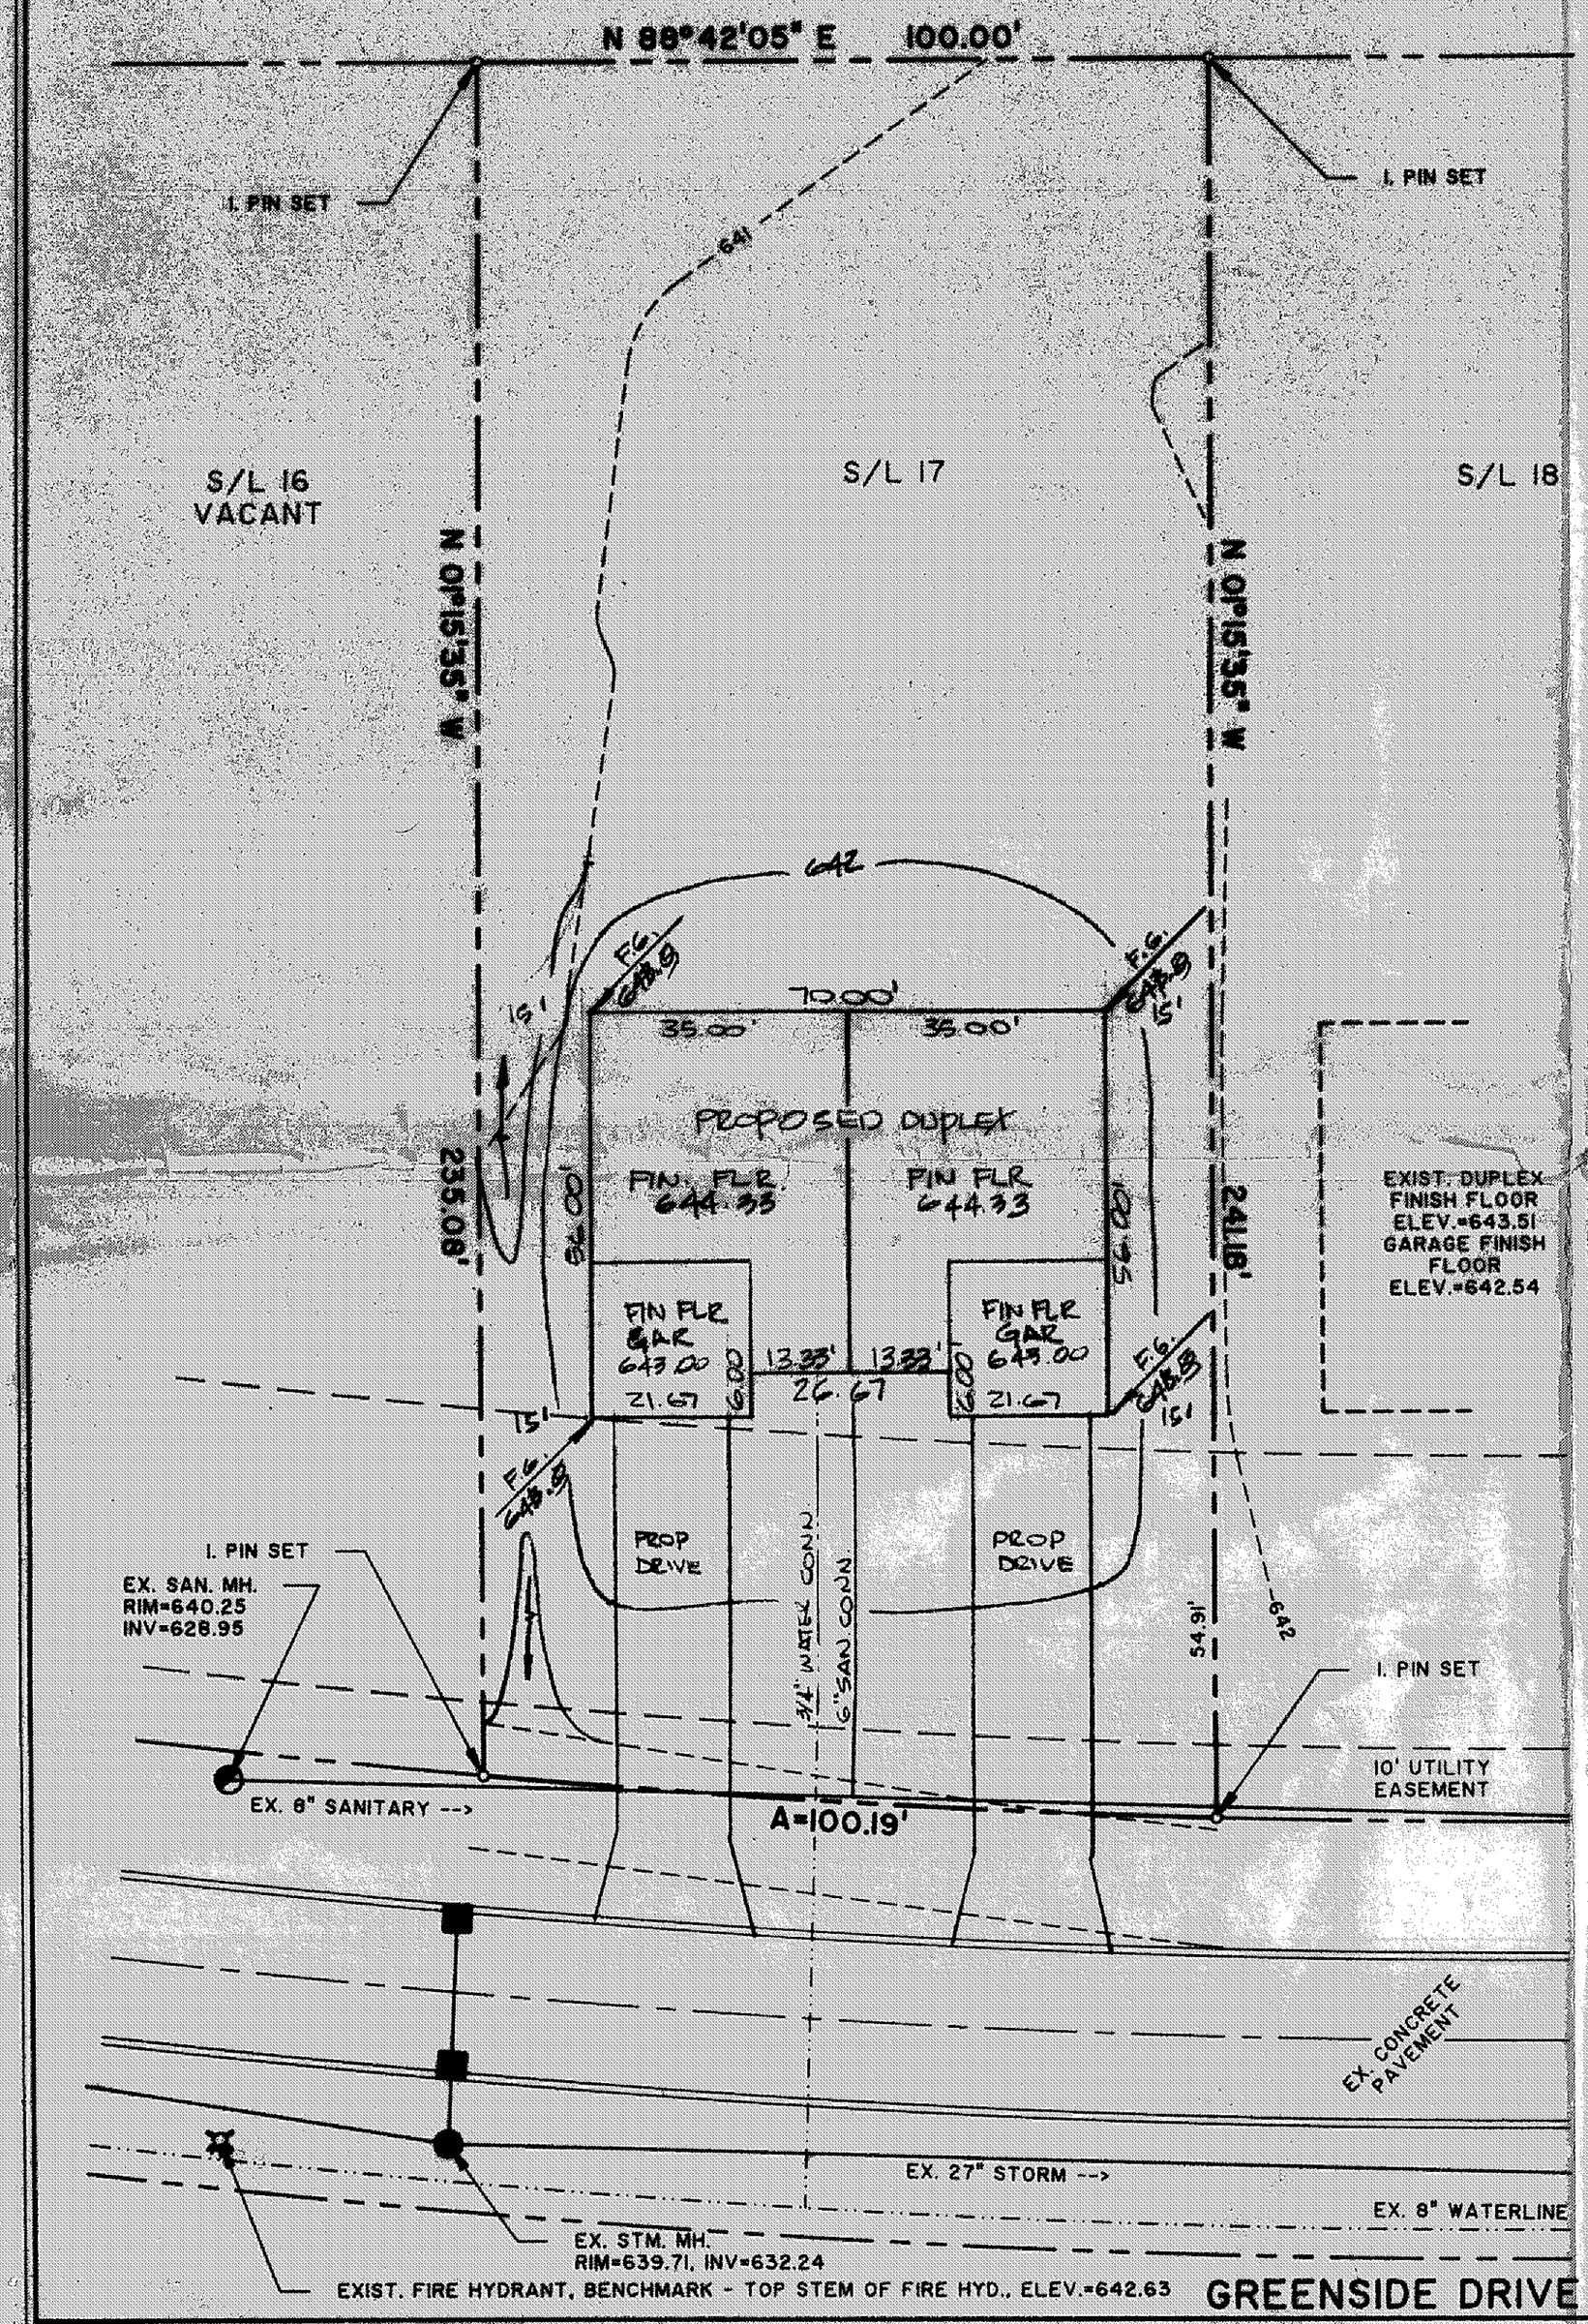

CURVE DATA
R=1630.75'
D=03°31'14"
A=100.20'
C=100.19'
N 87°48'22" W

NORTH

Grading Plan Approved as shown and/or noted
THOMAS P. GILLES, P.E.
Lake County Engineer
By GJH Date 8/4/95
Lower Finished Grades to 641.5

ROOF DRAINS SHALL DISCHARGE TO SPLASH BLOCKS.

GENERAL NOTES:

1. DRIVEWAY APRON TO BE 6" THICK
2. BENCHMARK - TOP STEM OF FIRE HYDRANT LOCATED IN FRONT OF SUBLOT NO. 23, ELEV.=642.63

LEGEND

EXISTING CONTOUR
PROPOSED CONTOUR

100.00 EXISTING ELEVATION
100.00 PROPOSED ELEVATION

STATE OF OHIO
DAVID W. NOVAK
S-7507
REGISTERED
SURVEYOR

CERTIFICATION

"I THE UNDERSIGNED HEREBY CERTIFY THAT THIS TOPOGRAPHY INDICATED BY 1' CONTOURS AND ELEVATIONS SHOWN HEREON REPRESENTS AN ACTUAL SURVEY MADE BY ME ON THE 7th DAY OF AUGUST, 1995 AND THE ELEVATIONS WERE TAKEN AT APPROPRIATE INTERVALS AND AS OF THAT DAY THEY EXISTED AS INDICATED HEREON.

"I HEREBY CERTIFY THAT THIS PLAN WAS PREPARED BY ME AND IS CORRECT TO THE BEST OF MY KNOWLEDGE"

DAVID W. NOVAK, P.S. No. 7507

PREPARED BY:

Himebaugh and Novak

Surveyors and Site Consultants
8663 Tyler Boulevard
Mentor, Ohio 44060-4346
(216) 974-7670, (216) 255-5900 FAX.

SITE PLAN: SUBLOT NO. 17, GREENSIDE DRIVE, PAINESVILLE TWP.
ASHBOURNE SUBDIVISION, VOL. 12, PG. 4

PREPARED FOR: SCHOENIGER BROS. CONSTRUCTION, INC.
SCALE: 1" = 20'
DATE: AUGUST 07, 1995
DRAWN BY: DAVID W. NOVAK

APPROVED
PAINESVILLE TOWNSHIP
ZONING DEPARTMENT

94101-17

FORM No. A-004 (01/17/94)