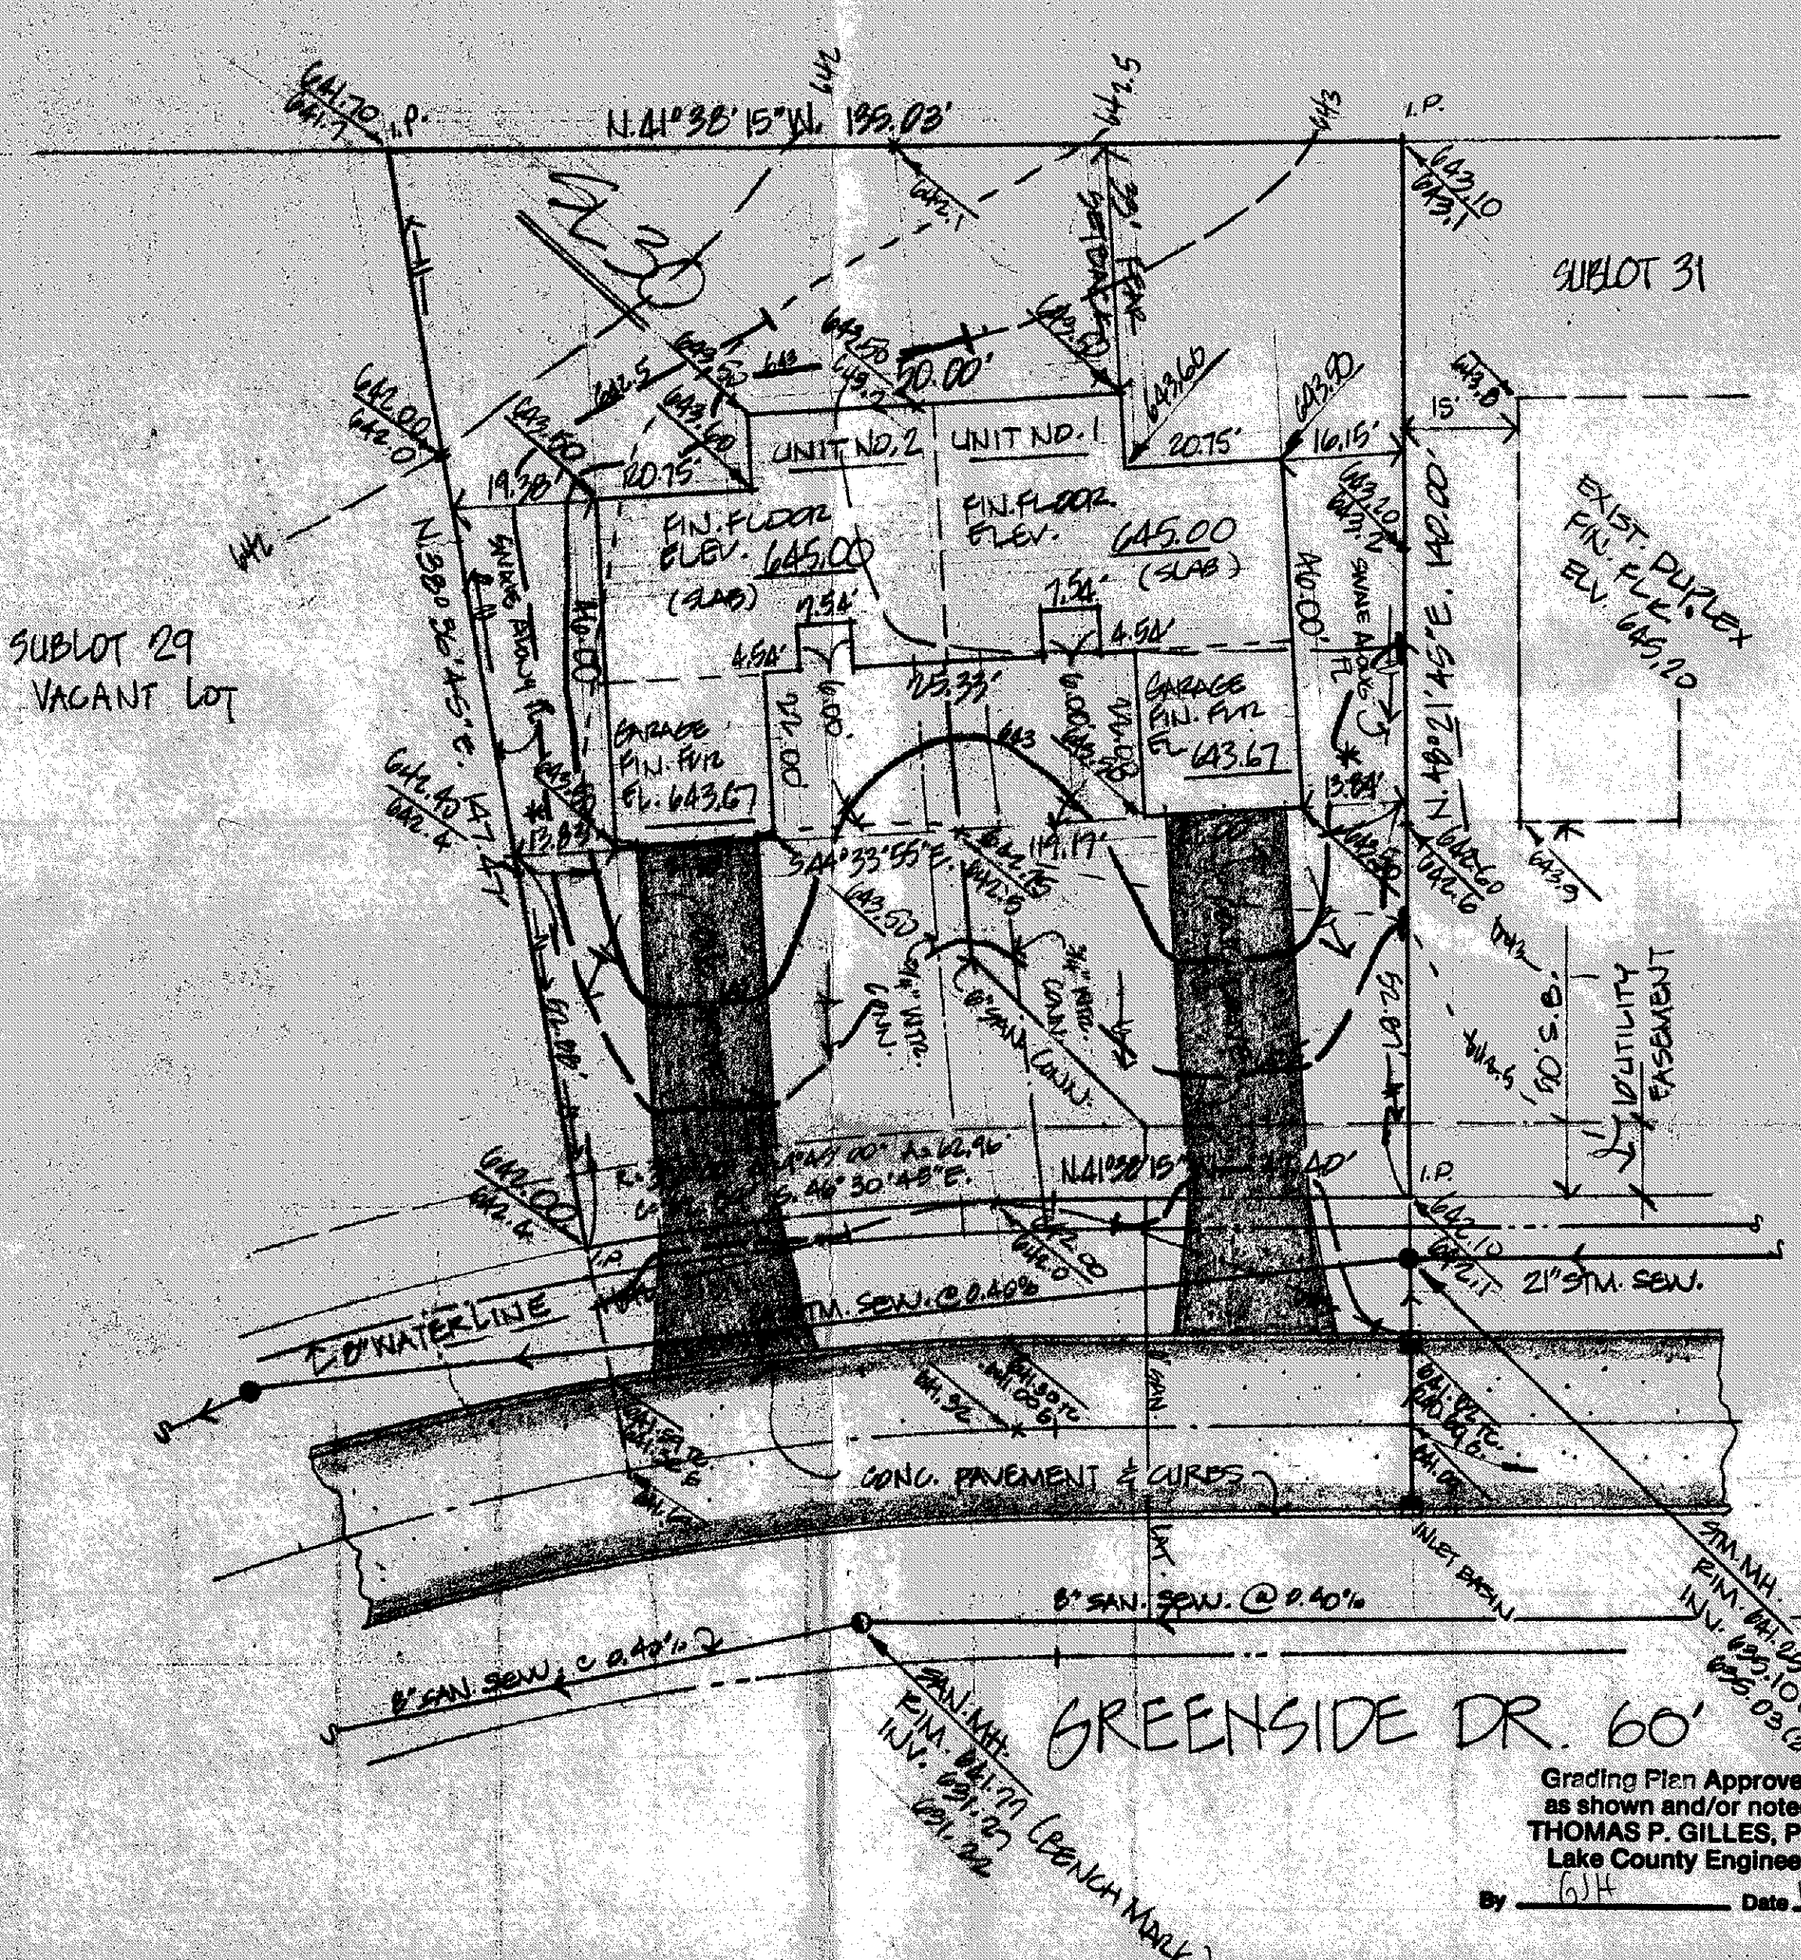

* SIDELINE VARIANCE REQUIRED 7.76%

Grading Plan Approved
as shown and/or noted
THOMAS P. GILLES, P.E.
Lake County Engineer
By GJH Date 10.26.93

ROOF DRAINS SHALL DISCHARGE TO SPLASH BLOCKS.

APPROVED
PAINESVILLE TOWNSHIP
ZONING DEPARTMENT
10/27/93

LEGEND:

- 640.00 / 640.0 — PROPOSED GRADES / EXISTING ELEVATIONS
- 642 — EXISTING CONTOURS
- 640 — PROPOSED CONTOURS

CERTIFICATION:

I HEREBY CERTIFY THAT THIS PLAT WAS PREPARED BY ME AND IS CORRECT TO THE BEST OF MY KNOWLEDGE AND BELIEF.

STATE OF OHIO — RICHARD BILSKI — 5244 — REGISTERED SURVEYOR

BY: Richard Bilski
RICHARD BILSKI, P.S. NO. 5244

SITE PLAN FOR: EDWARD H. TRESGER, INC.
9100 DEERWOOD BLVD., MENTOR, OHIO 44060
BEING SUBLOT NO. 30 IN ASHBOURNE SUBDIVISION IN PAINESVILLE TWP., OHIO

DATE Sept. 1, 1993
SCALE 1" = 20'
DRAWN BY GRH
CHK'D BY

CT Consultants, Inc.
Engineers • Architects • Planners
Willoughby • Mentor • Columbus • Lorain • North Canton • Steubenville

SHEET 1 OF 1
CONTRACT NO. 21-07