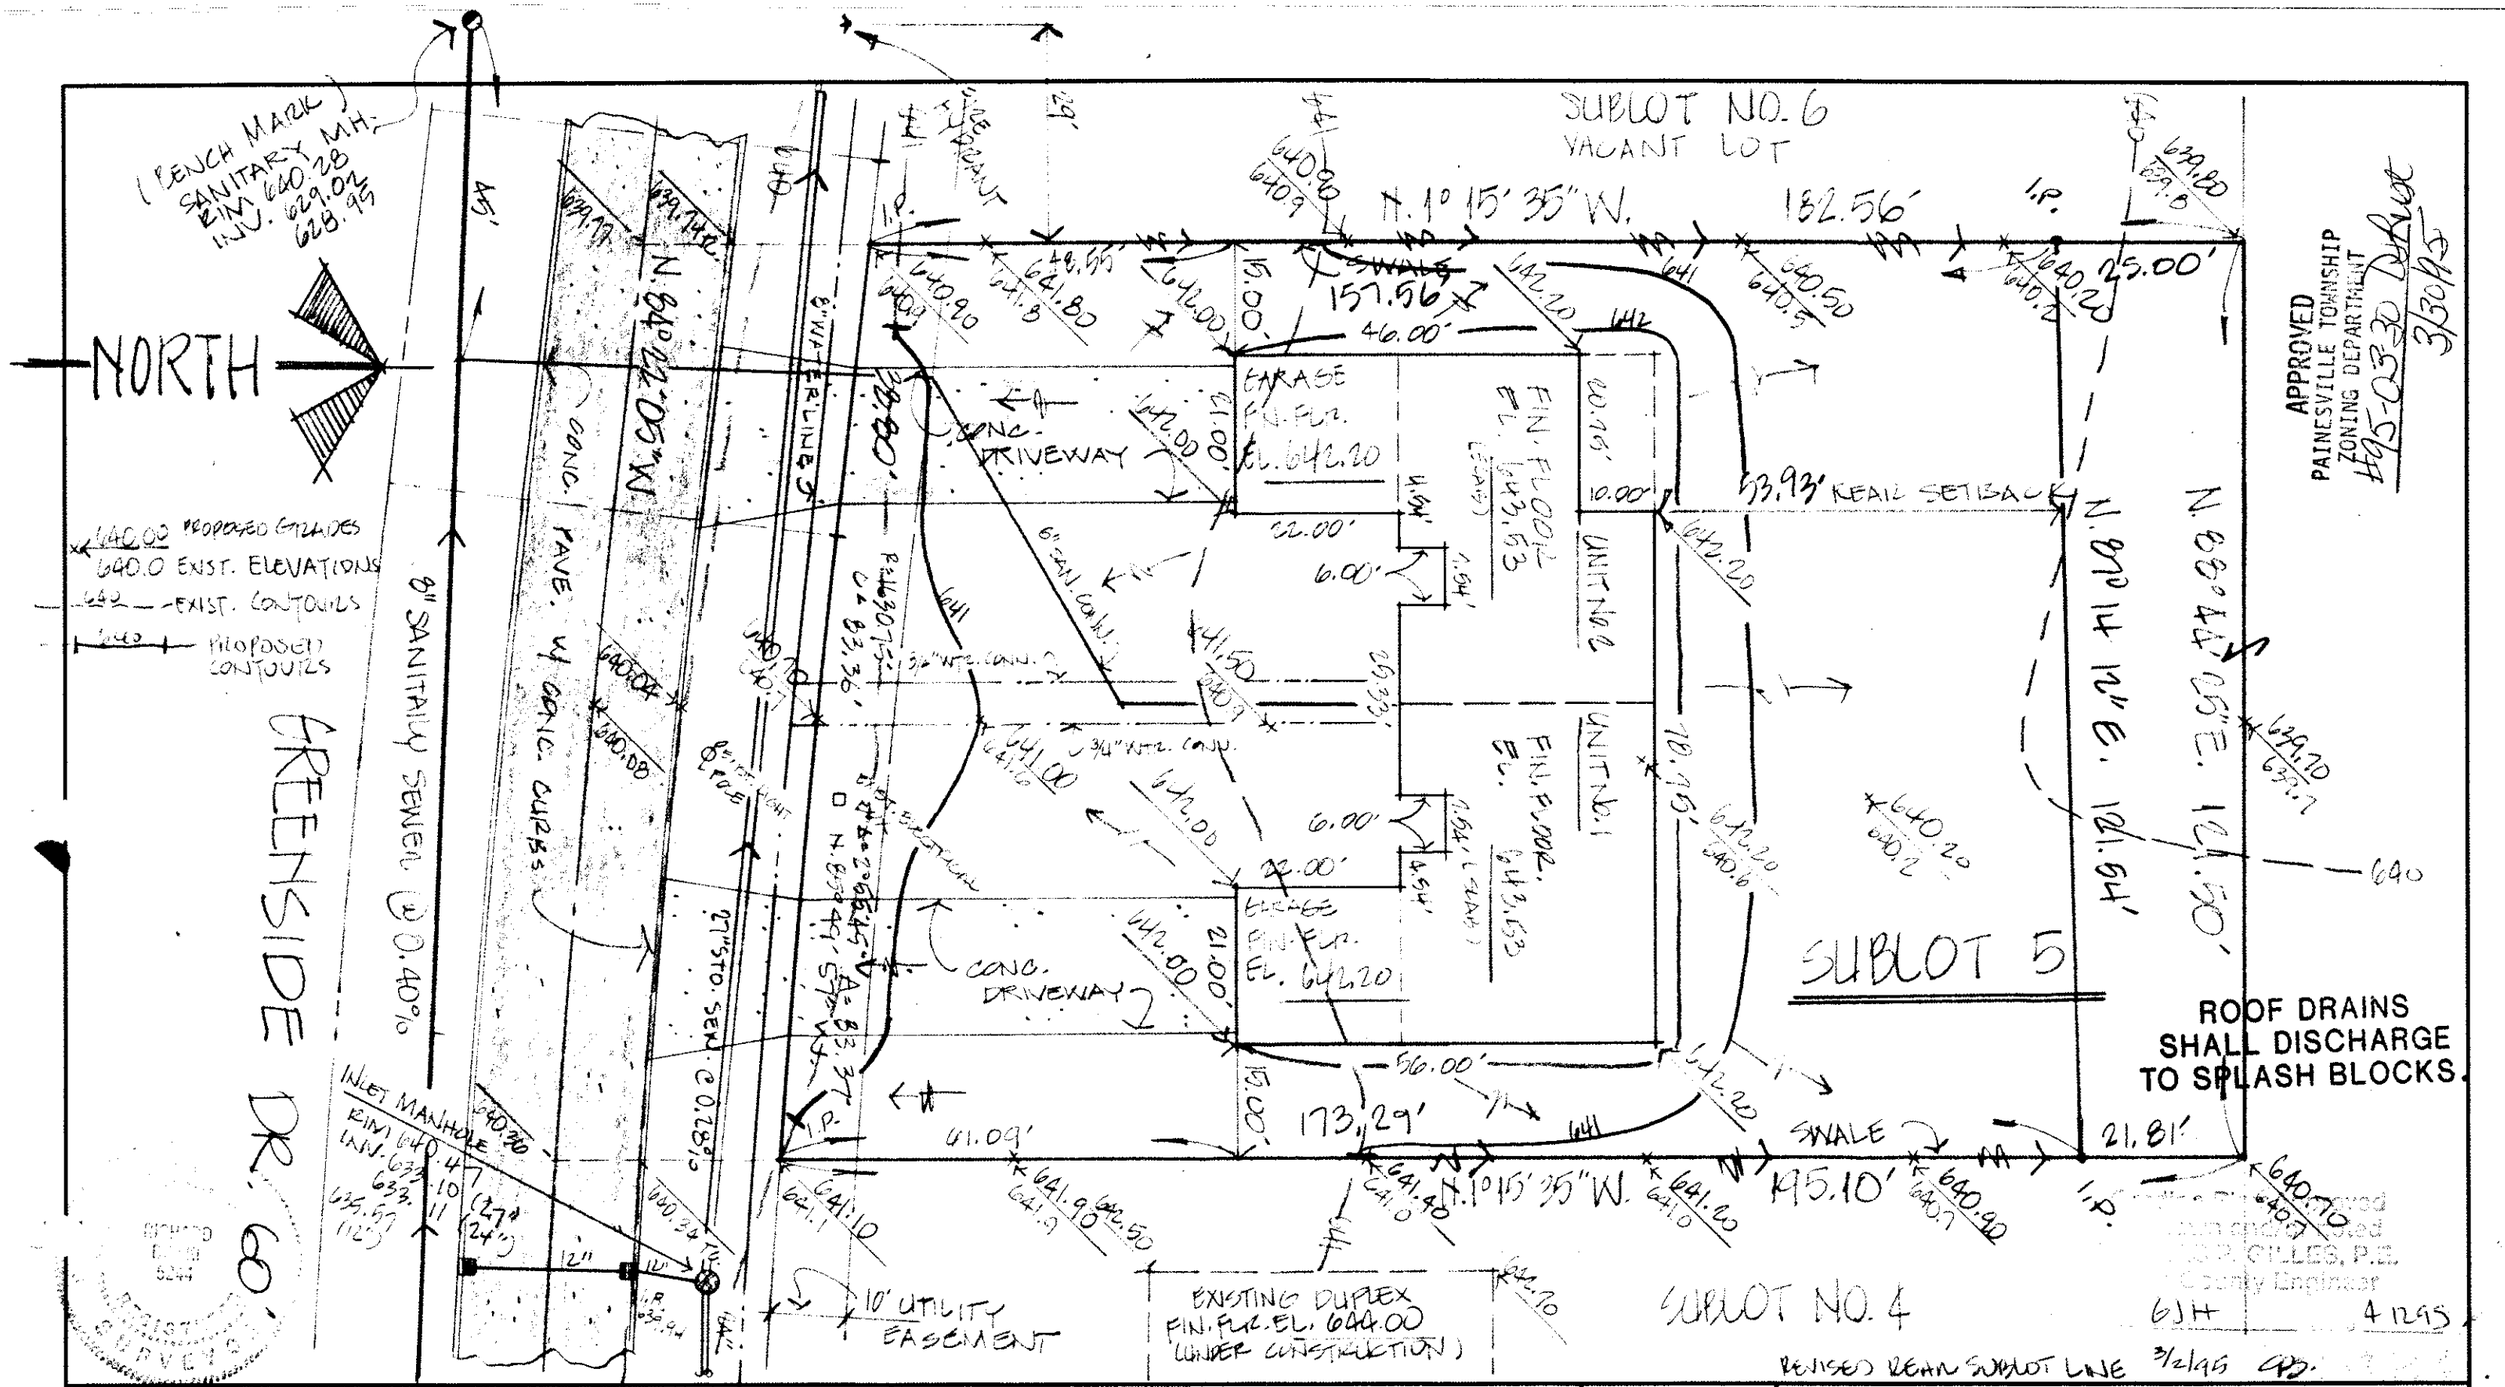

DESIGN CERTIFICATION	AS BUILT CERTIFICATION			
THIS PLAT WAS PREPARED BY ME, AND IS CORRECT TO THE BEST OF MY KNOWLEDGE AND BELIEF.	I HEREBY CERTIFY THAT THE CIRCLED GRADES ARE EXISTING FINISH GRADES CHECKED IN THE FIELD ON _____ AND THAT SURVEY IS CORRECT TO THE BEST OF MY KNOWLEDGE AND BELIEF.	CT Consultants, Inc. Engineers • Architects • Planners Willoughby • Mentor • Columbus • North Canton • Youngstown	DATE Dec. 2, 1994	SITE PLAN FOR: EDWARD H. TRESGER INC. 8100 DEEPWOOD BLVD. MENTOR, OHIO. 44060 BEING SUBLOT NO. 5 IN THE ASHBOURNE RE-SUBDIVISION NO. 1 IN PAINESVILLE TOWNSHIP, OHIO.
REG. SURVEYOR NO. PS# 5244	REG. SURVEYOR NO. _____		SCALE 1" = 20'	
			DRWN BY C.D.B.	
			CHKD BY _____	
			JOB NO. 91-117	
			FB _____ PG _____	

0001-00-313