Examined and Approved
As shown and/or noted
THOMAS P. GILLES, P.E.
Lake County Engineer
By _____ Date 3/14/95

ROOF DRAINS
SHALL DISCHARGE
TO SPLASH BLOCKS.

APPROVED
PAINESVILLE TOWNSHIP
ZONING DEPARTMENT
3/31/95

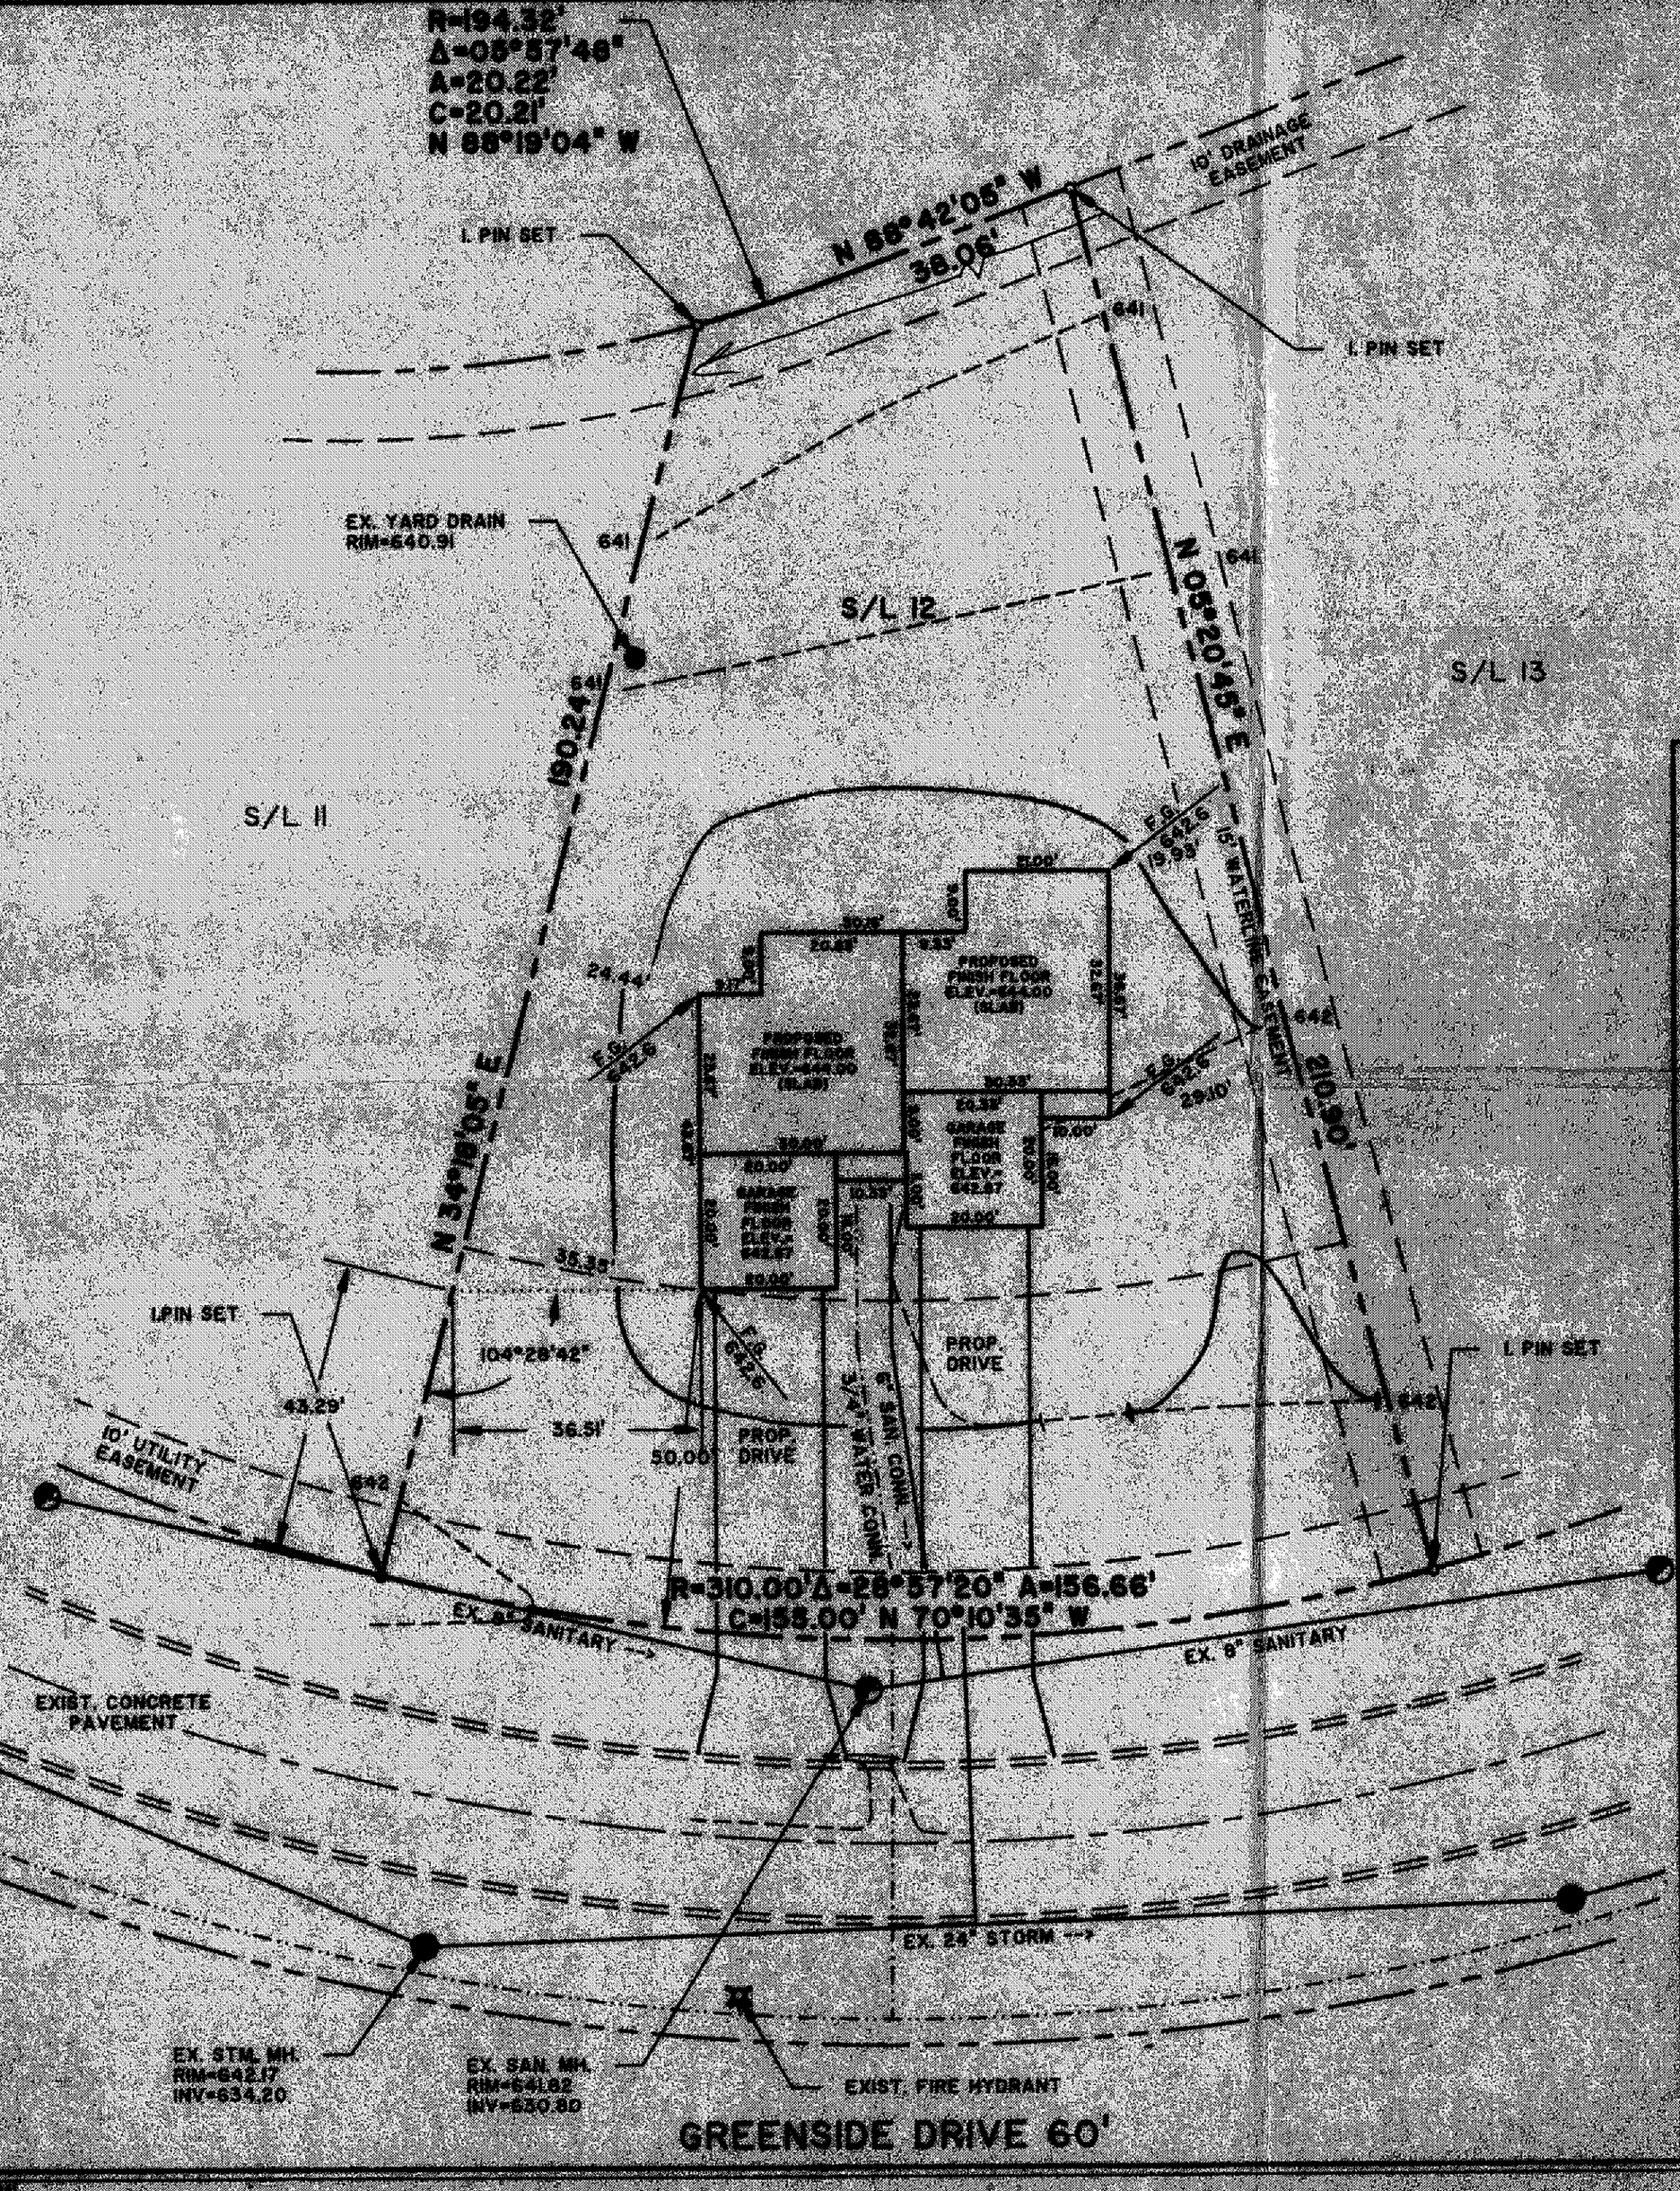

GENERAL NOTES:

1. DRIVEWAY APRON TO BE 6" THICK
2. BENCHMARK - TOP STEM OF FIRE HYDRANT LOCATED IN FRONT OF SUBLOT No. 29, ELEV=646.40

LEGEND

EXISTING CONTOUR
PROPOSED CONTOUR

100.00 EXISTING ELEVATION
100.00 PROPOSED ELEVATION

CERTIFICATION

"I THE UNDERSIGNED HEREBY CERTIFY THAT THIS TOPOGRAPHY INDICATED BY 1' CONTOURS AND ELEVATIONS SHOWN HEREON REPRESENTS AN ACTUAL SURVEY MADE BY ME ON THE 19th DAY OF SEPT., 1994 AND THE ELEVATIONS WERE TAKEN AT APPROPRIATE INTERVALS AND AS OF THAT DAY THEY EXISTED AS INDICATED HEREON.

"I HEREBY CERTIFY THAT THIS PLAN WAS PREPARED BY ME AND IS CORRECT TO THE BEST OF MY KNOWLEDGE."

DAVID W. NOVAK, P.S. No. 7507

PREPARED BY:

Himebaugh and Novak

Surveyors and Site Consultants
8663 Tyler Boulevard
Mentor, Ohio 44060-4348
(216) 974-7670, (216) 255-5900 FAX.

SITE PLAN: SUBLOT No. 12, GREENSIDE DRIVE, PAINESVILLE TWP. ASHBOURNE SUBDIVISION, VOL. 12, PG. 4
PREPARED FOR: SCHOENIGER BROS. CONSTRUCTION INC.
SCALE: 1" = 20'
DATE: MARCH 10, 1995
DRAWN BY: DAVID W. NOVAK

94-101-012

MAR 14 1995