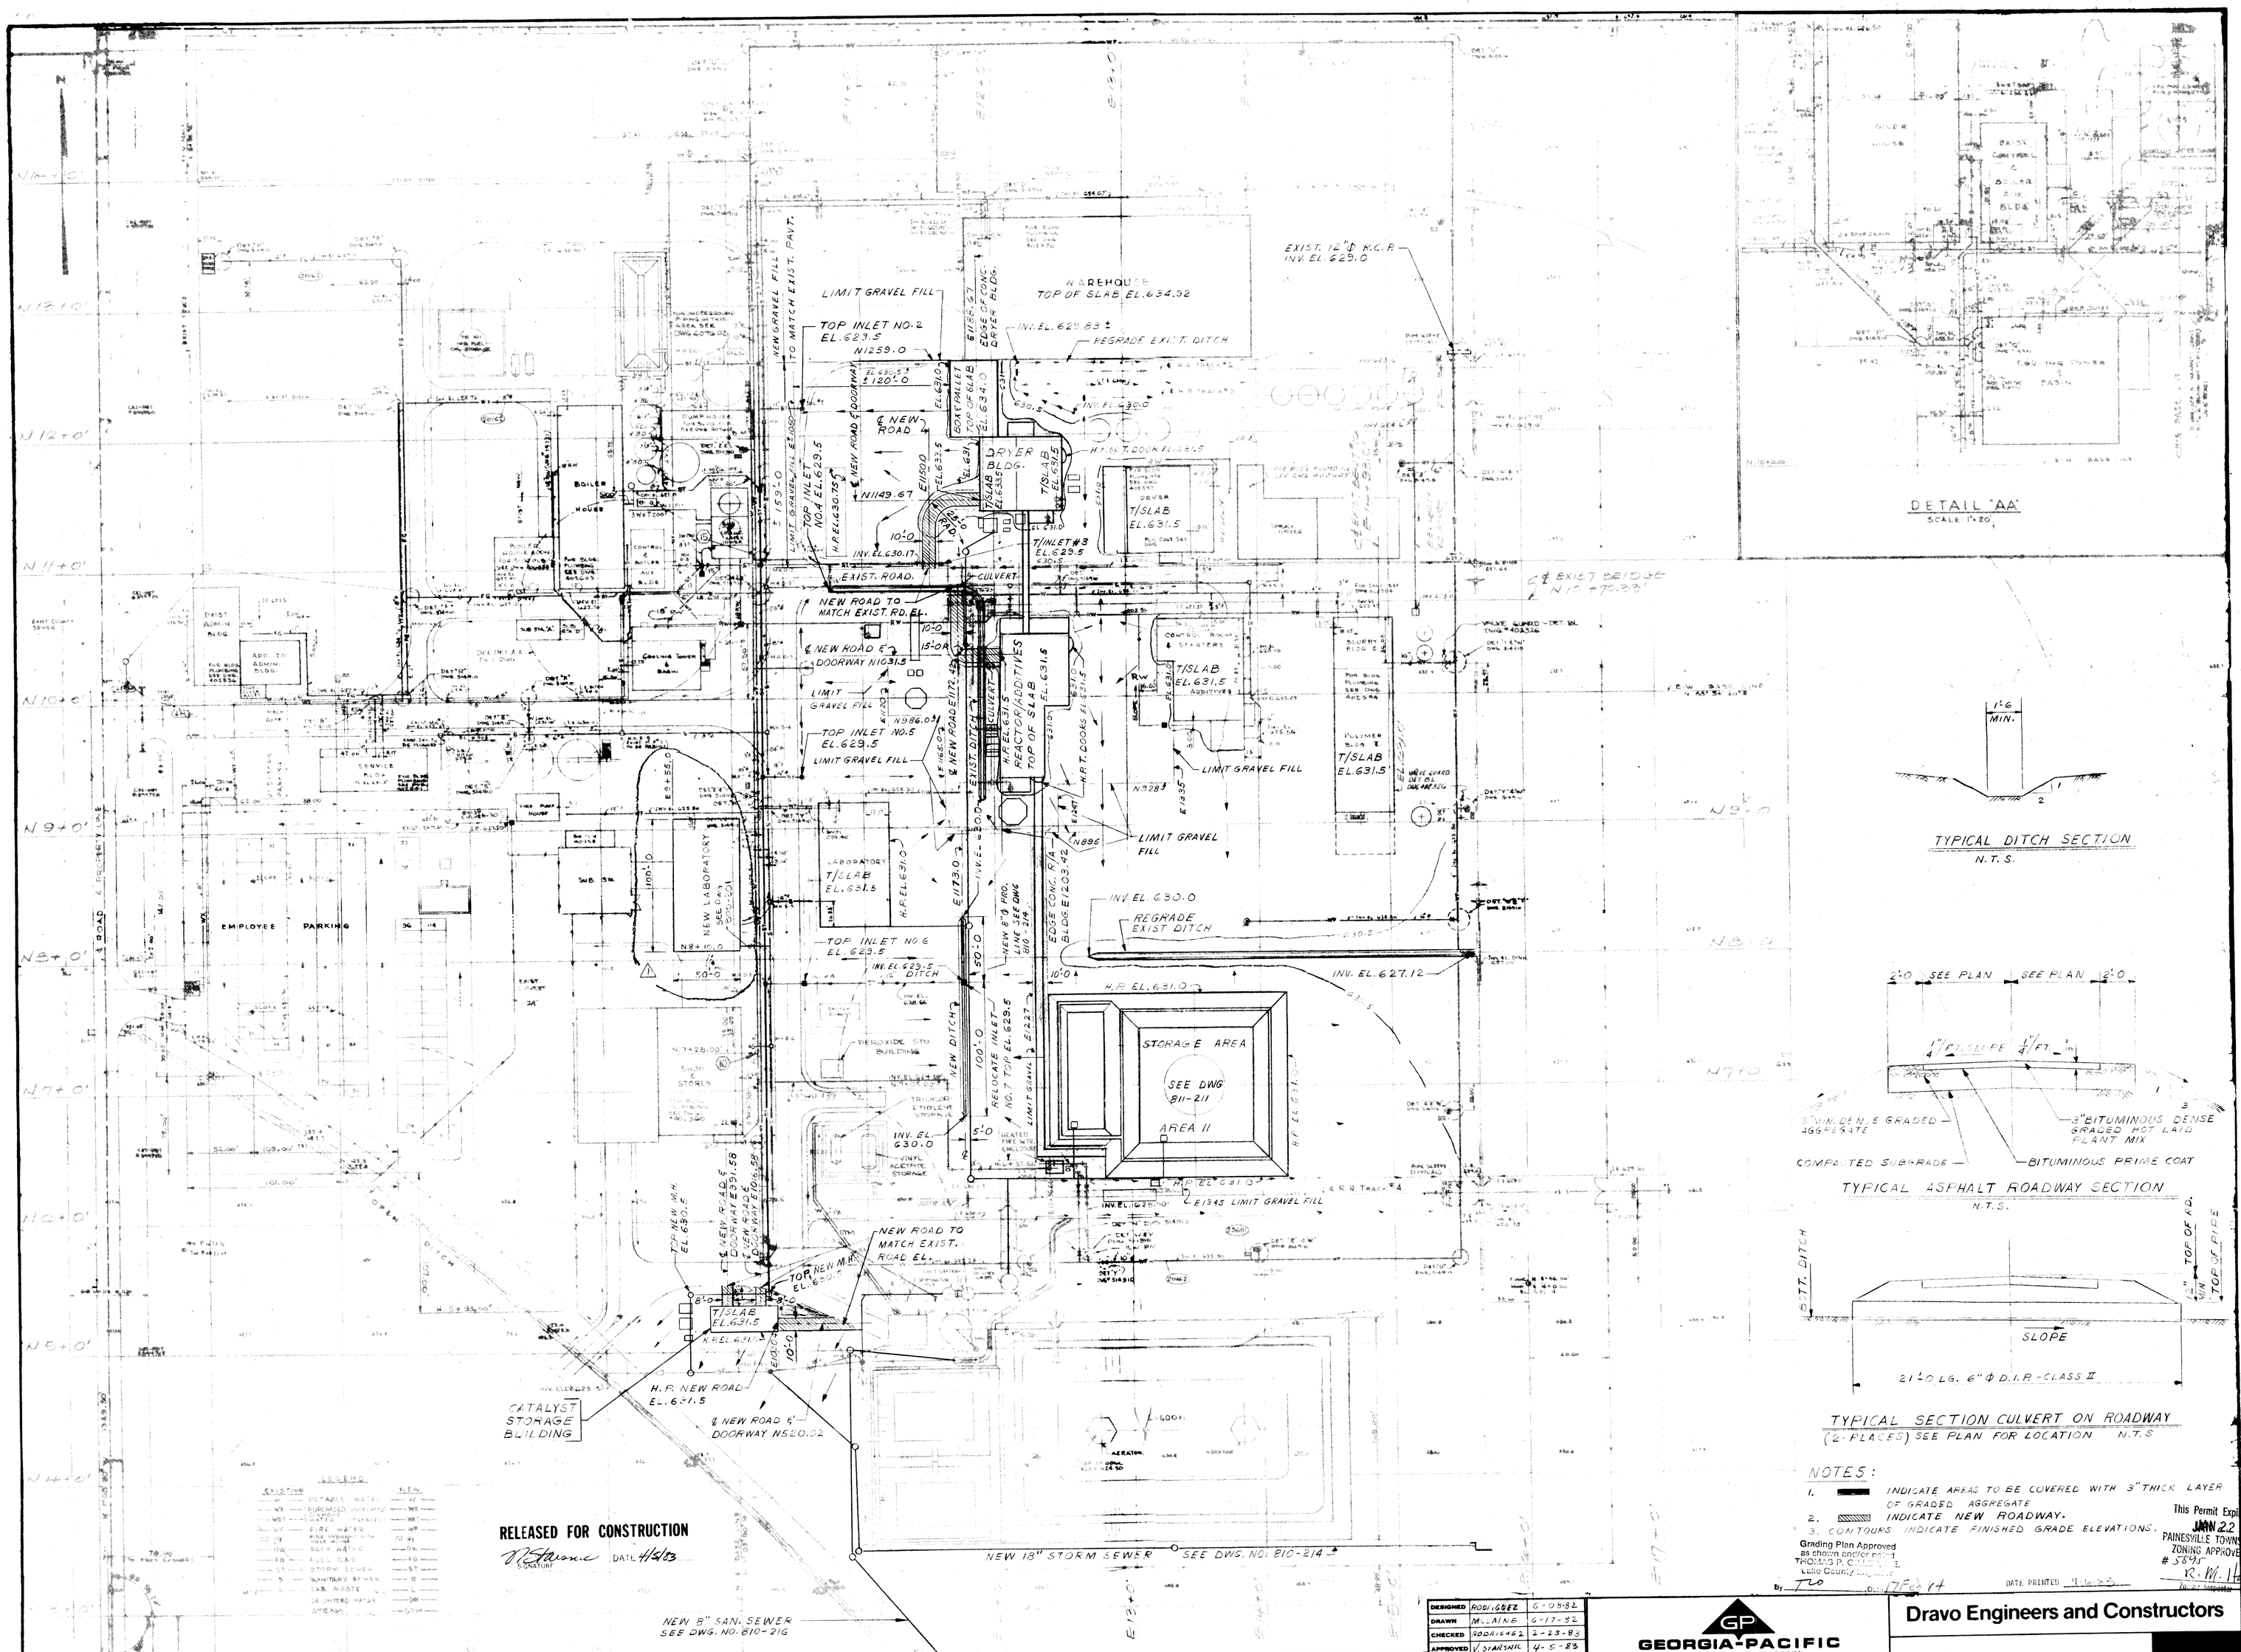

NOTES:

1. INDICATE AREAS TO BE COVERED WITH 3" THICK LAYER OF GRADED AGGREGATE
2. INDICATE NEW ROADWAY.
3. CONTOURS INDICATE FINISHED GRADE ELEVATIONS.

RELEASED FOR CONSTRUCTION
SIGNATURE DATE 4/5/83

Grading Plan Approved as shown and/or noted
THOMAS P. CONNELLY, Jr.

This Permit Expires JAN 22 1985
PAINESVILLE TOWNSHIP ZONING APPROVED
5895
By R. M. Hank 11/27/84
Zoning Inspector

DATE PRINTED 11-16-83

REV	DESCRIPTION	MADE	CHKD	DATE
1	NEW LABORATORY ADD ON C.N. 8124-1	R.S.	M.H.	11-84

REV	DESCRIPTION	MADE	CHKD	DATE

REV	RELEASED FOR	APP	DATE

DESIGNED	RODRIGUEZ	6-08-82
DRAWN	McLAINE	6-17-82
CHECKED	RODRIGUEZ	2-23-83
APPROVED	V. STARSHIC	4-5-83
APPROVED	R. LARKIN	3-30-83
APPROVED		

SCALE: 1" = 40'-0"

GEORGIA-PACIFIC
THE GROWTH COMPANY
PAINESVILLE OPERATIONS

AREA 10
STRUCTURAL
PAVING AND GRADING PLAN

Dravo Engineers and Constructors
PITTSBURGH, PENNSYLVANIA
Dravo

Contract	Drawing Number	Rev.
3320	810-212	1