Grading Plan Approved
as shown and/or noted
THOMAS P. GILLES, P.E.
Lake County Engineer
By GJH Date 9/16/91
DISCHARGE SUMP PUMP TO
6" STM. CONN.

This Permit Expires
9/10/92
PAINESVILLE TOWNSHIP
ZONING APPROVED
#7933 D. Pruot
Zoning Inspector

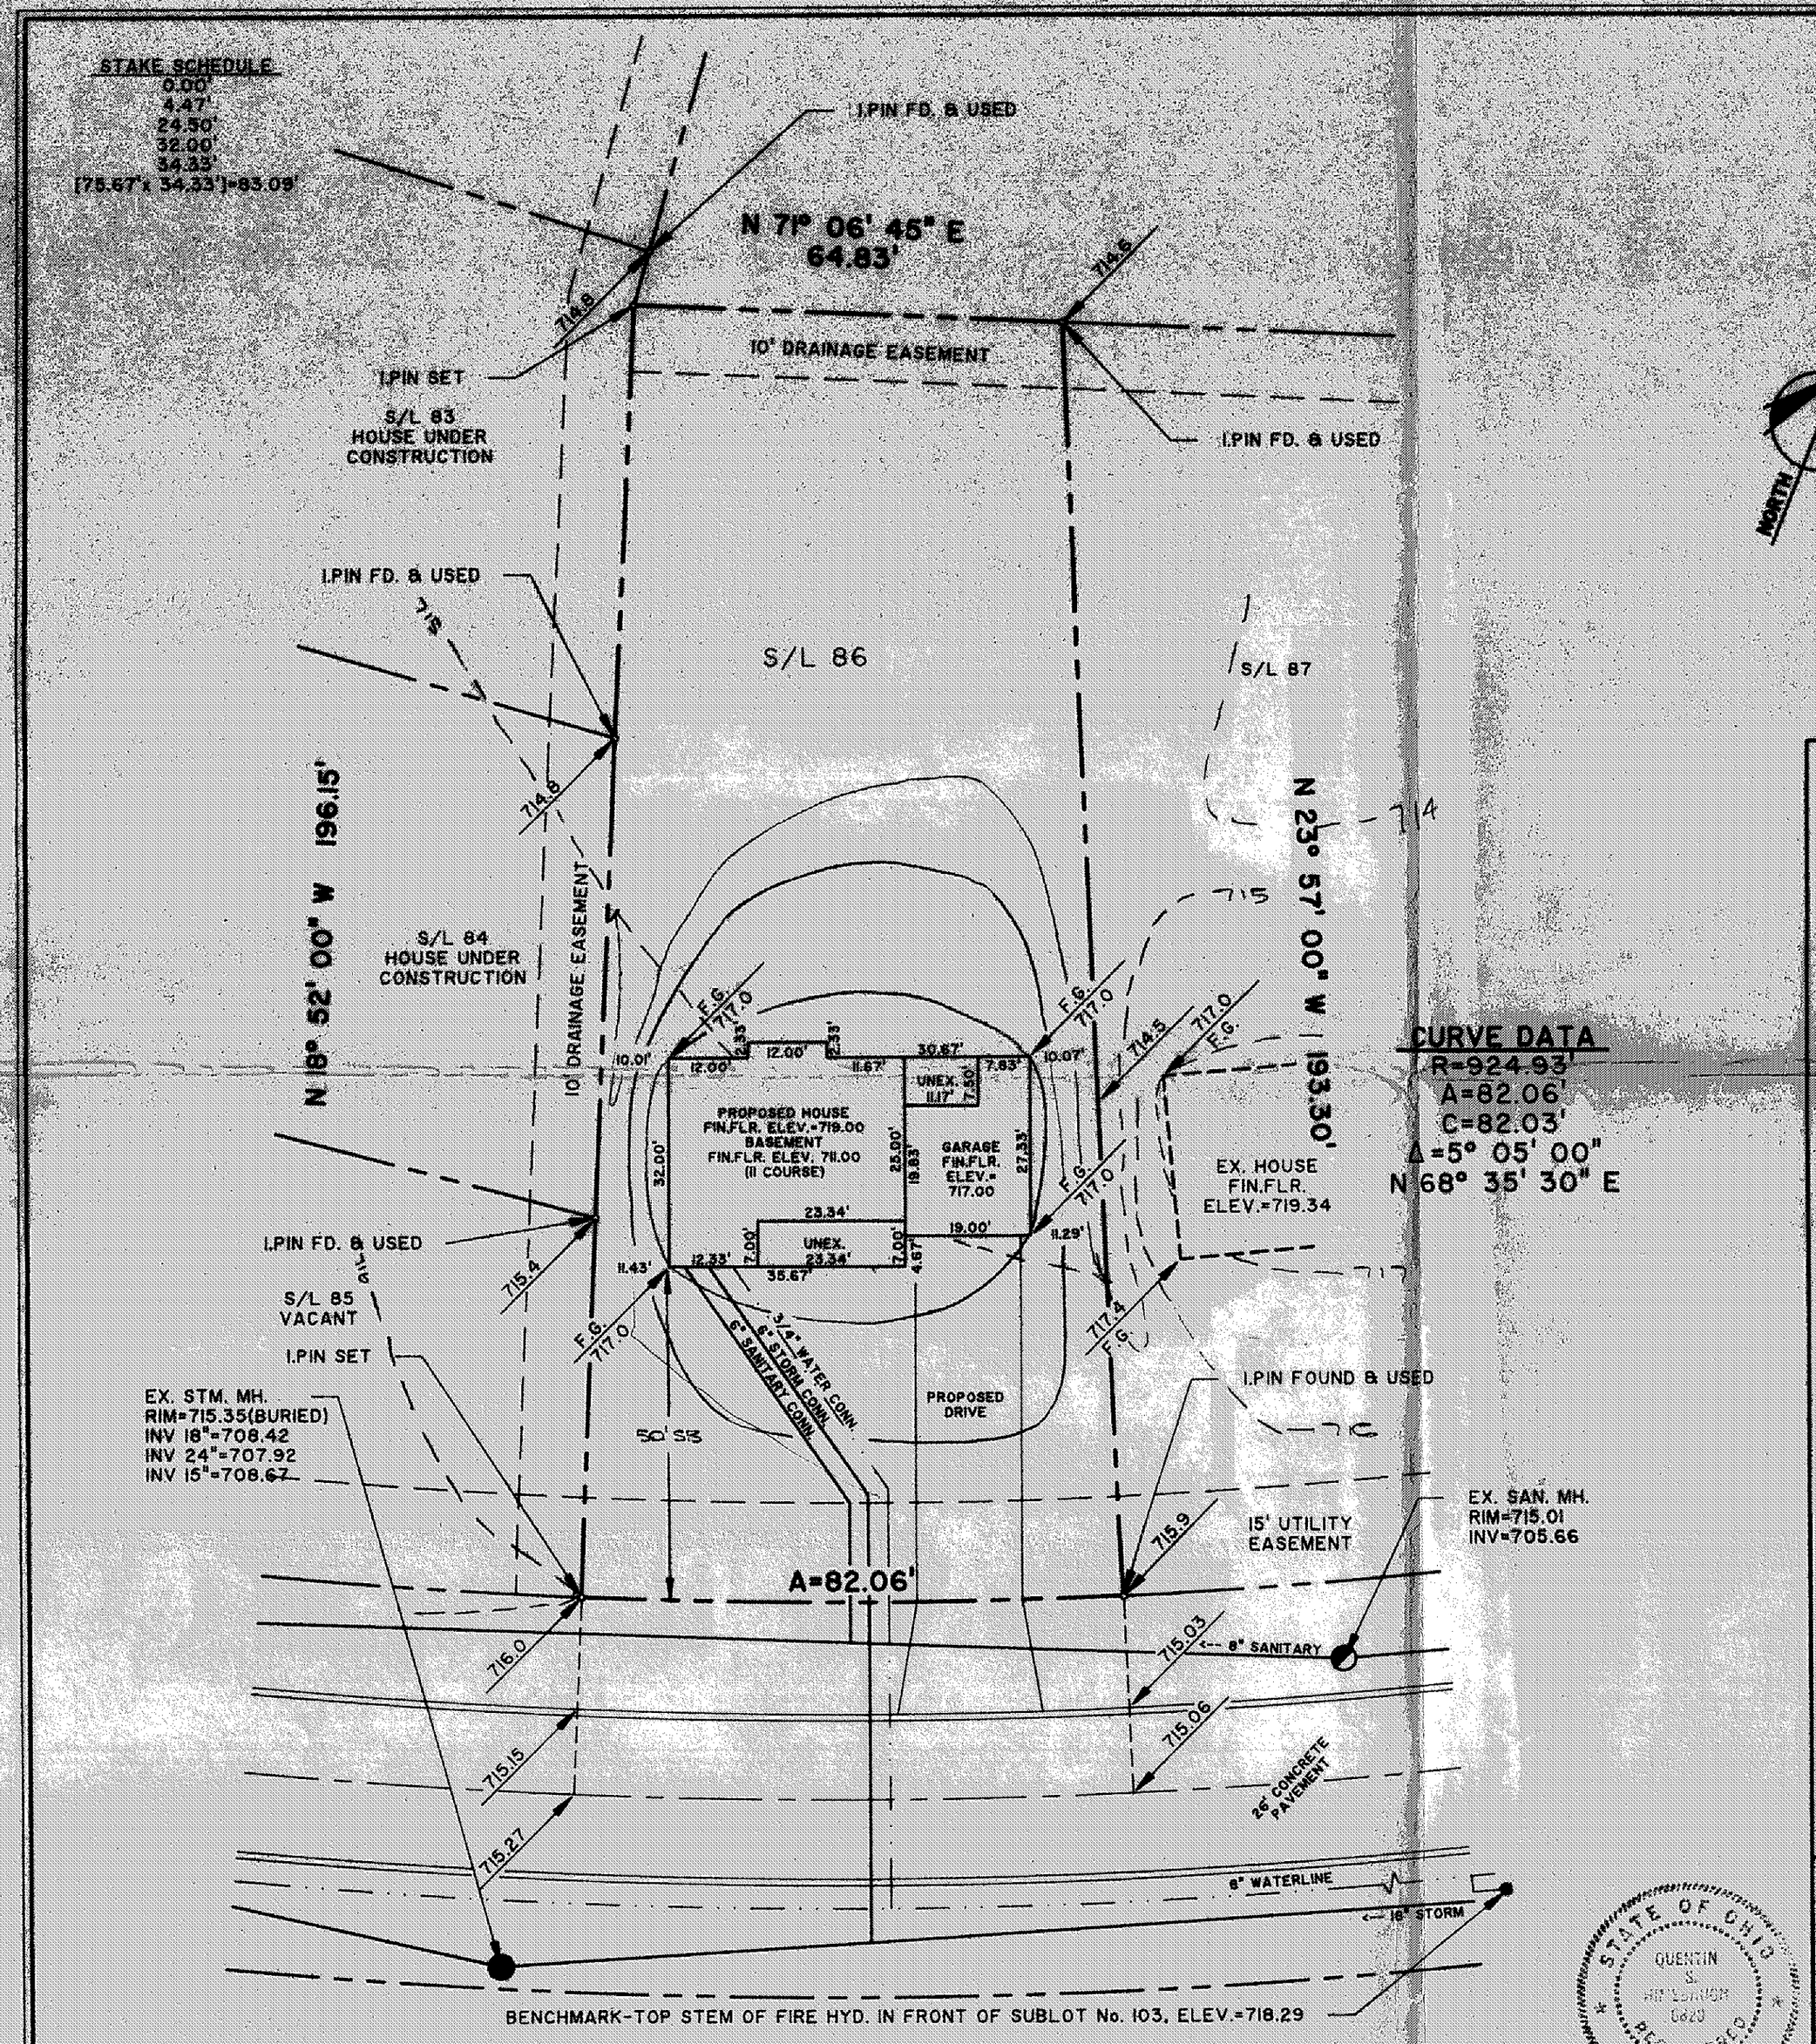

CURVE DATA
R=924.93'
A=82.06'
C=82.03'
Δ=5° 05' 00"
N 68° 35' 30" E

STATE OF OHIO
QUENTIN S. HIMEBAUGH 6820
REGISTERED SURVEYOR

GENERAL NOTES:

1. DRIVEWAY APRON TO BE 6" THICK
2. BENCHMARK - TOP STEM OF FIRE HYDRANT LOCATED IN FRONT OF SUBLOT No. 103, ELEV. = 718.29

LEGEND

EXISTING CONTOUR
PROPOSED CONTOUR

100.00 EXISTING ELEVATION
100.00 PROPOSED ELEVATION

CERTIFICATION

"I THE UNDERSIGNED HEREBY CERTIFY THAT THIS TOPOGRAPHY INDICATED BY 1' CONTOURS AND ELEVATIONS SHOWN HEREON REPRESENTS AN ACTUAL SURVEY MADE BY ME ON THE 26th DAY OF AUGUST, 1991 AND THE ELEVATIONS WERE TAKEN AT APPROPRIATE INTERVALS AND AS OF THAT DAY THEY EXISTED AS INDICATED HEREON.

"I HEREBY CERTIFY THAT THIS PLAN WAS PREPARED BY ME AND IS CORRECT TO THE BEST OF MY KNOWLEDGE"

Quentin S. Himebaugh P.S. #6820
QUENTIN S. HIMEBAUGH, P.S. No. 6820

PREPARED BY:
Himebaugh and Associates
Surveyors and Site Consultants
38083 West Spaulding St.
Willoughby, Ohio 44094
(216) 946-1761

SITE PLAN: SUBLOT No. 86 HEATHERSTONE DRIVE 60' PAINESVILLE TWP.
HEATHERSTONE SUBDIVISION, VOL. Z, PG. 35
PREPARED FOR: SCHOENIGER BROS. CONSTRUCTION, INC.
SCALE: 1" = 20'
DATE: AUGUST 29, 1991
DRAWN BY: DAVID W. NOVAK

REV A. SEPT 9, 1991

91-010-086

FORM No. A-004 (06/03/90)