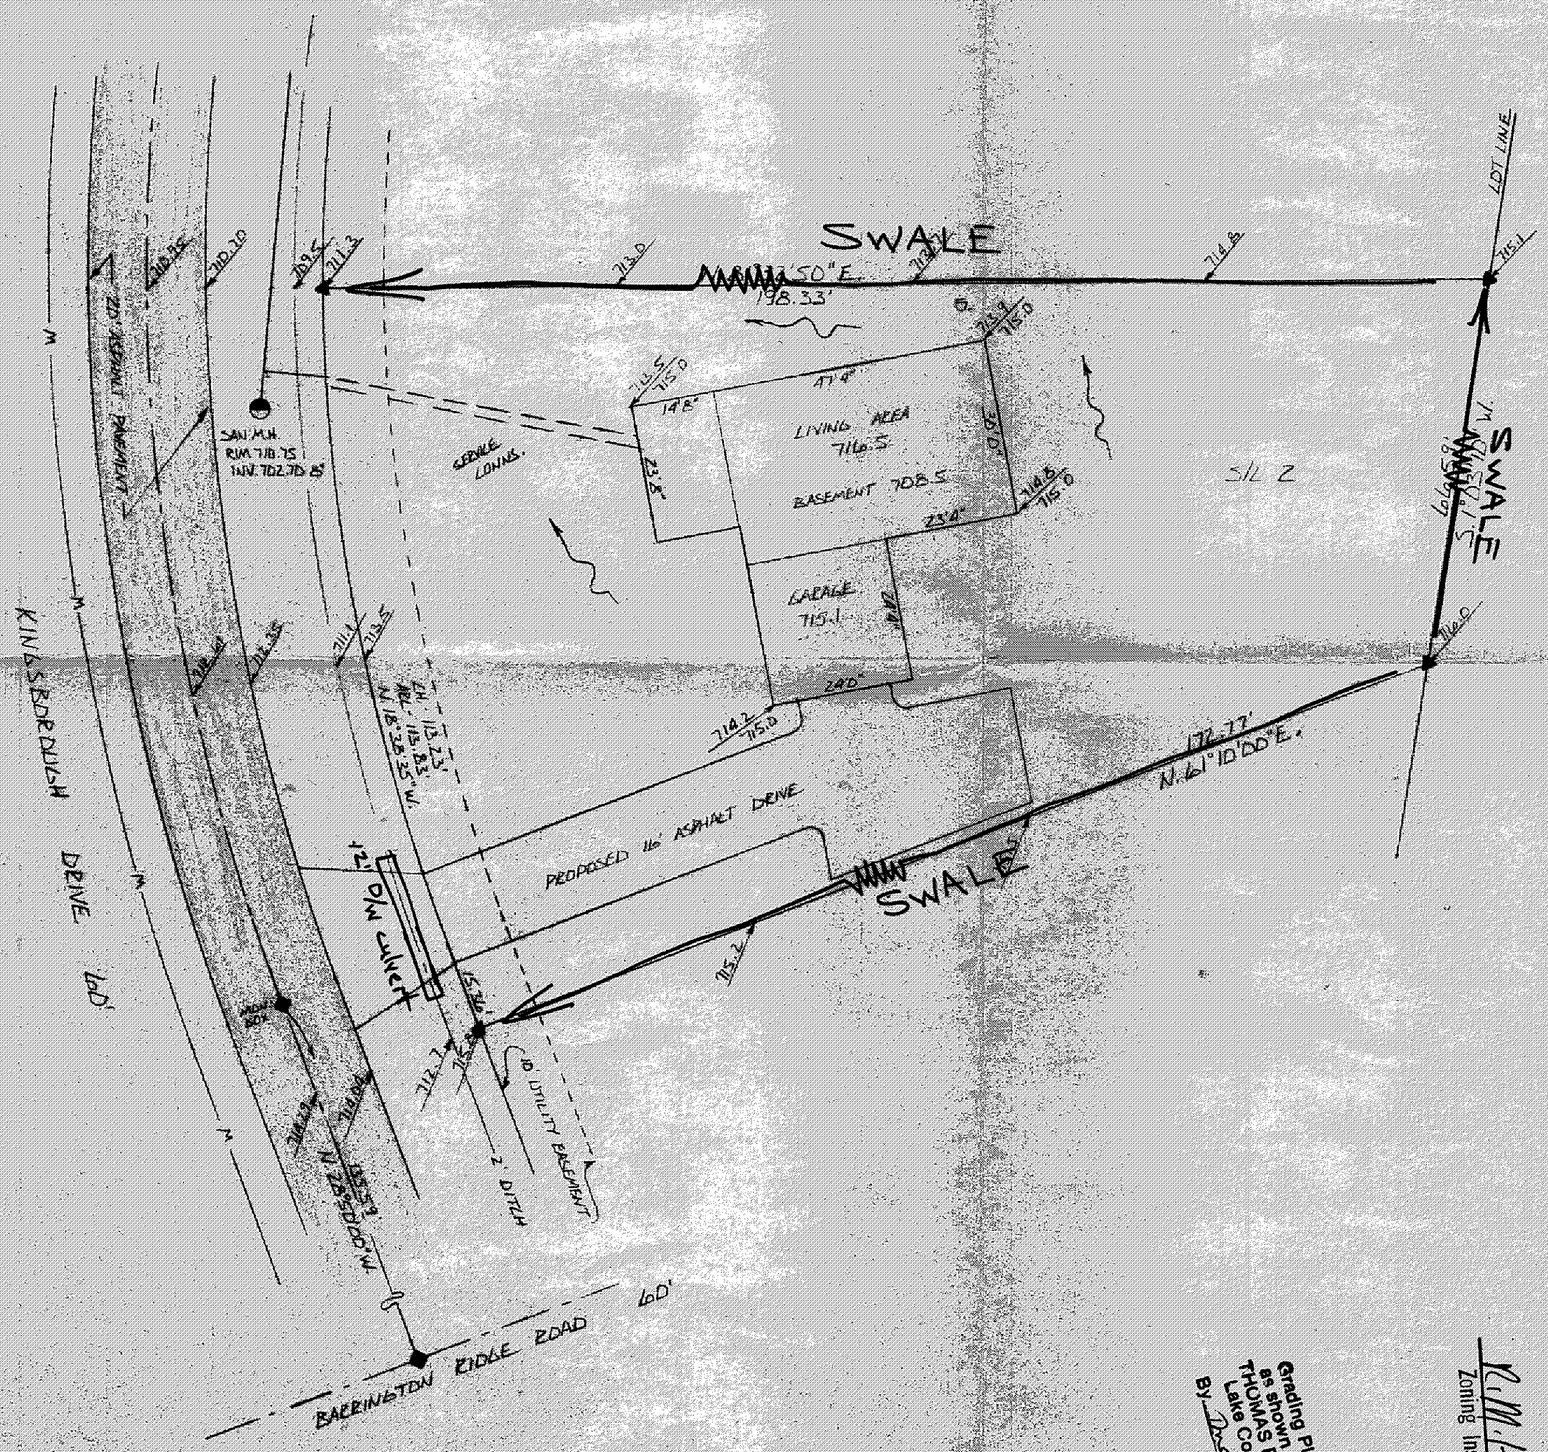

I CERTIFY THAT THIS PLAN WAS PREPARED BY ME AND IS CORRECT TO THE BEST OF MY KNOWLEDGE AND BELIEF.

REG. SURVEYOR S-6356

JOHN L. SEDNIELZNY
7739 VIEWMOUNT DRIVE
CONCORD OHIO 44077
352-7742

▲ IRON PIN SET

SWALE

PROP. EXISTING GRADES

PAINESVILLE TOWNSHIP
ZONING O.K.
PENDING DRAINAGE

Zoning Inspector

Grading Plan Approved as shown and/or noted
THOMAS P. GILLES, P.E.
Lake County Engineer
By _____ Date 11-22-78

SITE PLAN FOR
ROY SLAYTON 'SON CONST.

SCALE 1"=20'	APPROVED BY JLS	DRAWN BY SJC
DATE 8 NOV 1978		
OF S/L 2 KINGSBOROUGH SUBDIVISION		X-36
TOWNSHIP OF PAINESVILLE	LAKE COUNTY	OHIO
		DRAWING NUMBER 78-25